IREDELL COUNTY HEALTH DEPARTMENT

STATESVILLE 704-878-5305 MOORESVILLE 704-664-5281

IMPROVEMENT PERMIT / AUTHORIZATION TO CONSTRUCT / OPERATION PERMIT / EXISTING SYSTEM INSPECTION

PERMIT# 11698 PIN# 4625-83-4957, 1348 4625821126 DATE June 15, 04

OWNER OR CONTRACTOR Crescent Resources Inc // The Pawton Norman / Kinsolving Homes Home

ADDRESS 2214 Brawley School Rd Mooresville, N.C. 28117

LOCATION Brawley School Rd TL Yacht Rd. TL Milford Circle TL Alton Ct. at end

SUBDIVISION The Point BLOCK / SECTION 13 LOT 1348 LOT AREA .869Ac+.369 Ac SITE CLASS PS SFE DESIGN FLOW 480gpd L.T.A.R. 3 SFE 1358-1348

Septic Tank: ~~1000~~ 1500 Gallons; STB 338 Date 7/18/05

Pump Tank: 1000 Gallons; PT 283 Date 9/19/05

Pump Make: Gouds Model WEC-1012-H Serial No. C05F1422

Nitrification Field: No. Fields 1 Square Feet 1200 Linear Feet 400

No Lines 4@100' Trench Width 36" Max Trench Bottom Depth 36" Gravel Depth NR

☑ New System ☐ Repair System Type: I, II, III, IV, V, VI

System Description: pm 25% Reduction of SFE

Repair System Description: pm 25% Reduction on SFE

Maintenance Agreement Required: ☐ Yes ☑ No

~~☑~~ House/Mod. Home No. Bedrooms 4/4

☐ Mobile Home No. Bathrooms

☐ Business No. Employees

☐ Other

☐ Slab ~~☑~~ Crawl Space ☐ Basement w/plumbing ☐ Basement wo/plumbing

Water Supply: ☐ Individual ~~☑~~ Public ~~☐~~ Community


Comments:/Conditions:

1.94% 62.89' 103.03'

Comments:/Conditions:


EZ Flows installed.

INITIAL SITE SKETCH

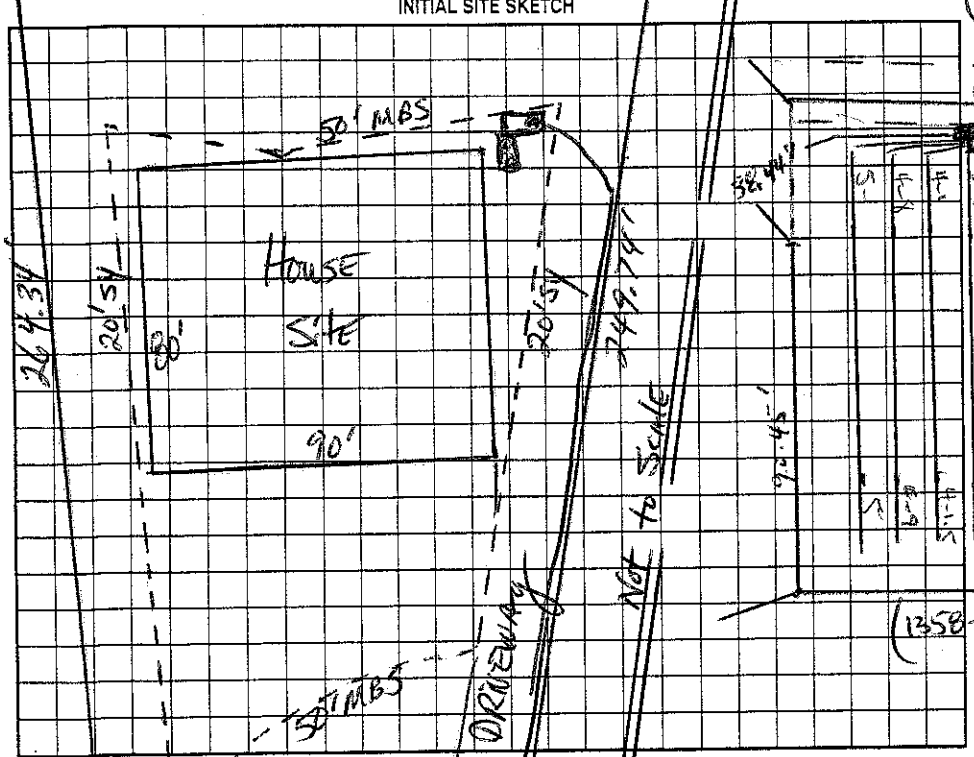

(Lot 1367)

AS BUILT SKETCH

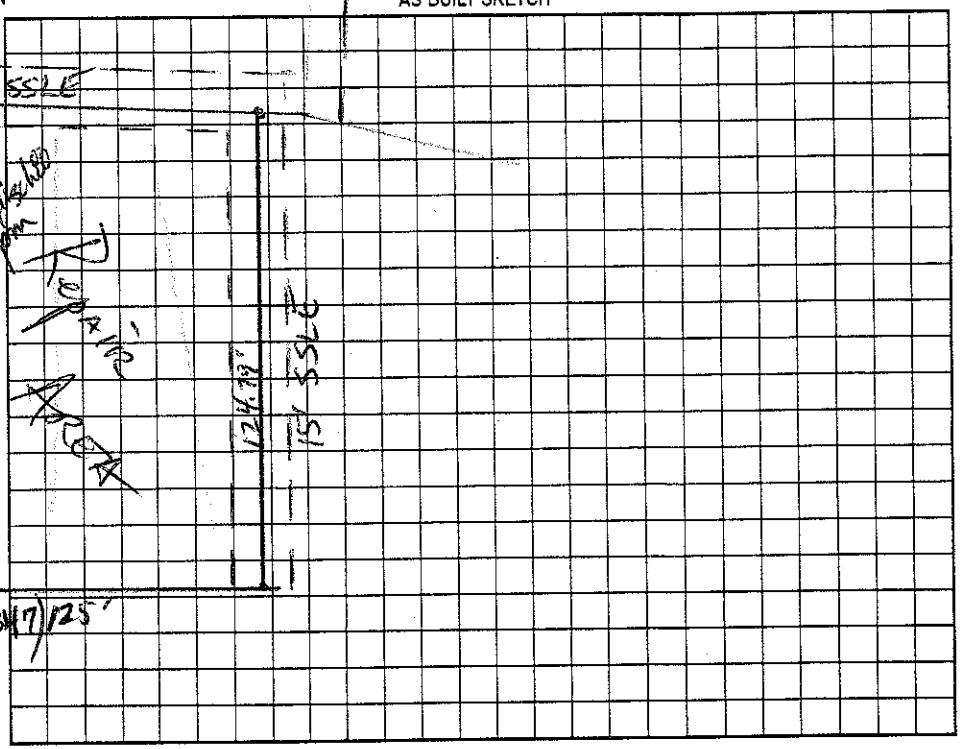

Permit can be suspended or revoked if any false information is supplied toward securing the permit/any unauthorized changes are made to the site/any unauthorized changes are made in the installation of the system. Improvement Permit with plat valid without expiration. Improvement Permit with site plan valid for sixty months. Authorization to Construct is valid for a period equal to that of Improvement Permit – not to exceed sixty months.

Signed: date 6-22-04 Installed by: Hallman Constr. Inc

Improvement Permit by: date 6-15-04 Operation Permit by: Wesley Sparks R.S. date 10/31/05

Authorization to Construct by: RW Alton Ct. Wesley Sparks R.S. date 4/19/05 Existing System Inspection by: date

54.29'

HEALTH DEPT. COPY: WHITE OWNER COPY (FINAL): YELLOW OWNER COPY (INITIAL): PINK