# IREDELL COUNTY HEALTH DEPARTMENT

STATESVILLE 704-878-5305 MOORESVILLE 704-664-5281

## IMPROVEMENT PERMIT / AUTHORIZATION TO CONSTRUCT / OPERATION PERMIT / EXISTING SYSTEM INSPECTION

PERMIT# 130341 PIN# ~~4625823567.1378~~ 4625-82-1935 DATE 11-30-06

OWNER OR APPLICANT Lifestyle Custom Homes PHONE: Business 704-795-1733 Home

ADDRESS 5706 Burck Dr Concord NC 28027

LOCATION Brawley School Rd TL Chesterwood Ct Easement on right House on left

SUBDIVISION The Pointe BLOCK / SECTION 13 LOT 1378 LOT AREA .766Ac +.418A SITE CLASS. PS DESIGN FLOW 600gpd L.T.A.R. .25-.3

Septic Tank: 1500v Gallons: STB 444 Date 3/21/07
Pump Tank: 1500v Gallons: PT 477 Date 7/28/07
Pump Make: Model Serial No.
Nitrification Field: No Fields 1 Square Feet 2310 Linear Feet 384
No Lines 5 Trench Width 36" Max Trench Bottom Depth 36" Gravel Depth NA ☐ Gravity ☒ Pressure

☒ New System ☐ Repair ☐ Expansion System Type: I II III (IV) V VI
System Description: LP PPBPS on 1378A
Repair System Description: LP PPBPS 1378A
Maintenance Agreement Required: ☒ Yes ☐ No

☒ House/Mod. Home ☐ Mobile Home ☐ Business ☐ Other
No. Bedrooms 5 No. Persons 10 No. Employees


Water Supply: ☐ Individual ☒ Public ☒ Community

☐ Slab ☐ Crawl Space ☒ Basement w/plumbing ☐ Basement wo/plumbing


Comments:/Conditions: Permit based on original permit by Paul Penninger & Kathleen Haver of same

Comments:/Conditions:

INITIAL SITE SKETCH

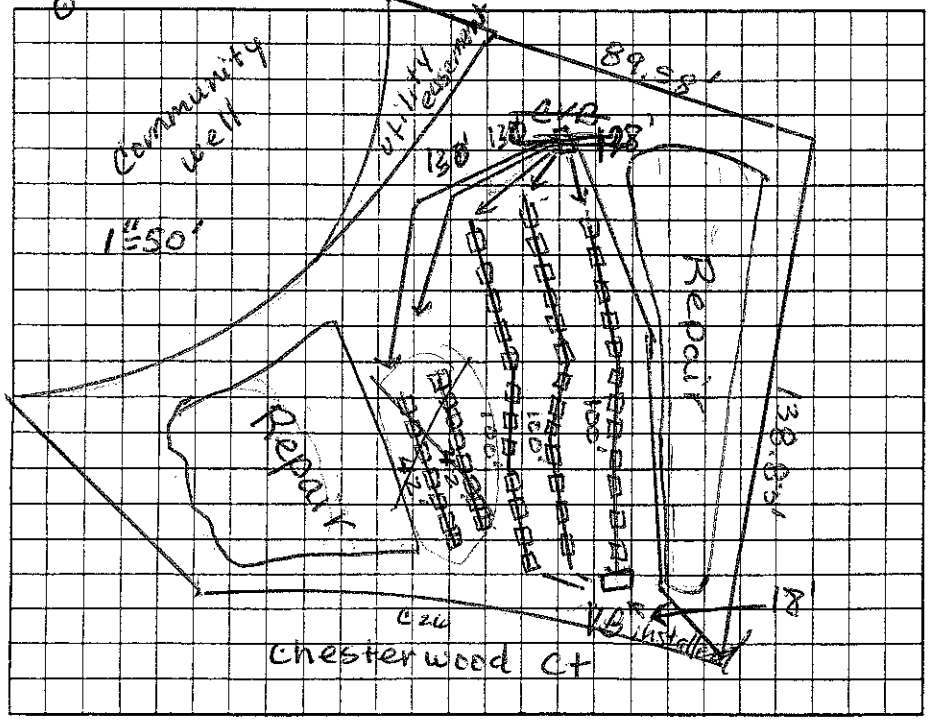


AS BUILT SKETCH

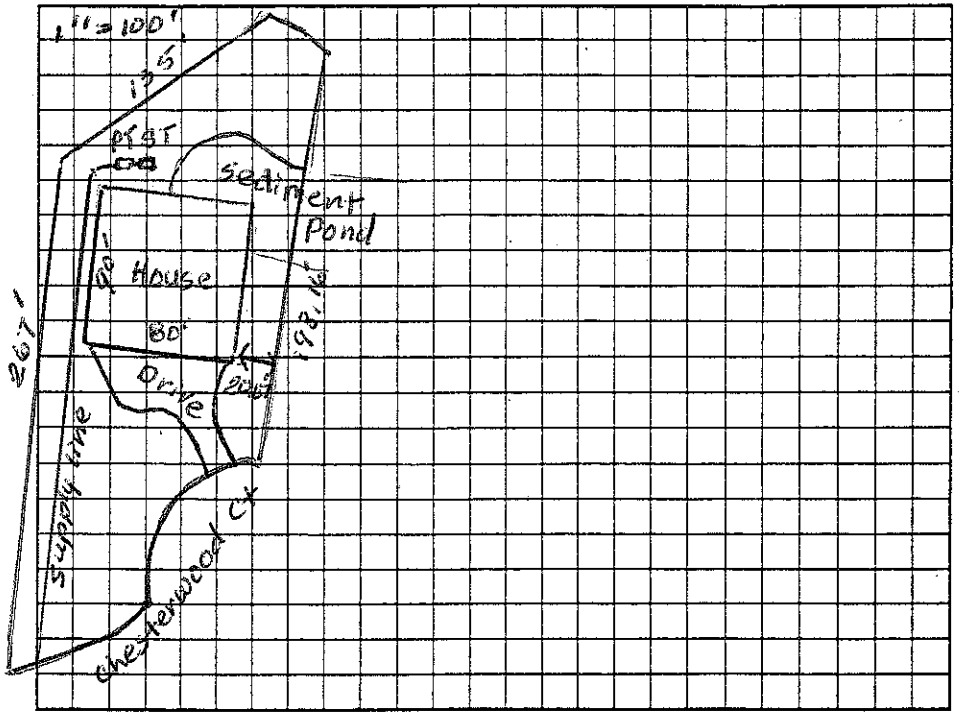


Permit can be suspended or revoked if any false information is supplied toward securing the permit/any unauthorized changes are made to the site/any unauthorized changes are made in the installation of the system. Improvement Permit with plat valid without expiration ☐ Improvement Permit with site plan valid for sixty months ☒ Authorization to Construct is valid for a period equal to that of Improvement Permit – not to exceed sixty months.

Signed: _____ date 12-6-06 Installed by: Hallmon Const

Improvement Permit by: Judy Melville date 12-1-06 Operation Permit by: Wesley Sparks R.S. date 11/13/07

Authorization to Construct by: Judy Melville date 12-1-06 Existing System Inspection by: _____ date _____

HEALTH DEPT. COPY: WHITE OWNER COPY (FINAL): YELLOW OWNER COPY (INITIAL): PINK