IREDELL COUNTY HEALTH DEPARTMENT

STATESVILLE 704-878-5305 MOORESVILLE 704-664-528

IMPROVEMENT PERMIT / AUTHORIZATION TO CONSTRUCT / OPERATION PERMIT / EXISTING SYSTEM INSPECTION

PERMIT# 130388 PIN# 4625823567 1373 Paul Phipps DATE 8/15/07

OWNER OR APPLICANT Lake Norman Signature Homes PHONE: Business 704 361 8402 Home

ADDRESS 584 Brawley School Rd Ste 104 Mooresville, NC 28117 4625822603

LOCATION Brawley School Rd thru traffic Circle Tl Chesterwood on Right

SUBDIVISION The Point BLOCK / SECTION 13 LOT 1373 LOT AREA 1.032 Acre SITE CLASS. PS DESIGN FLOW 450gpd L.T.A.R. 3

Septic Tank: 1000+ Gallons: STB 338 Date 5-7-07

Pump Tank: Gallons: PT Date

Pump Make: Model Serial No

Nitrification Field: No Fields 1 Square Feet 1260 Linear Feet 420'

No Lines 6 @ 70' Trench Width 36" Max Trench Bottom Depth 36" Gravel Depth N/A

☒ New System ☐ Repair ☐ Expansion System Type: I II III IV V VI

System Description: Gravity - 25% Reduction

Repair System Description: LRppBPs

Maintenance Agreement Required: ☐ Yes ☐ No

☒ House/Mod. Home ☐ Mobile Home ☐ Business ☐ Other

No. Bedrooms 4 No. Persons No. Employees


Water Supply: ☐ Individual ☒ Public ☒ Community

☐ Gravity ☐ Pressure ☐ Slab ☒ Crawl Space ☐ Basement w/plumbing ☐ Basement wo/plumbing


Comments/Conditions:

Comments/Conditions:

INITIAL SITE SKETCH

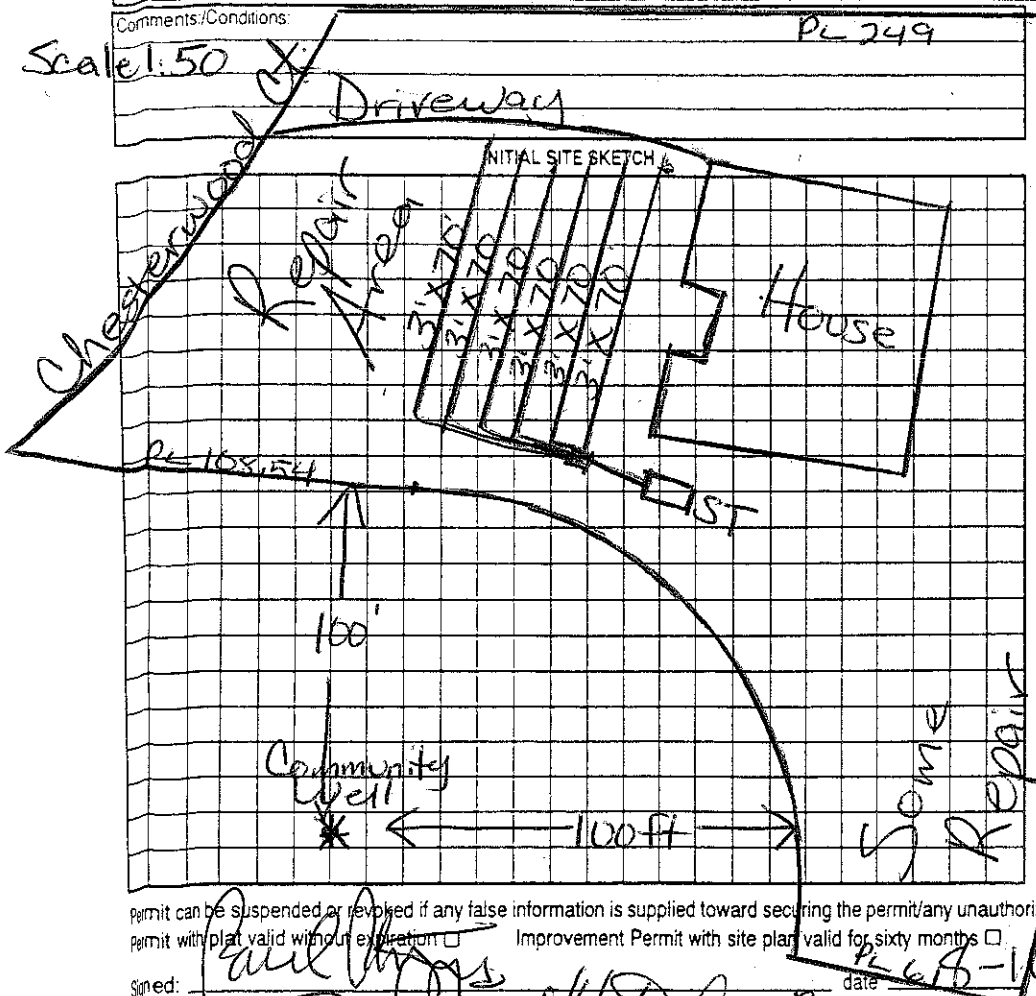

AS BUILT SKETCH

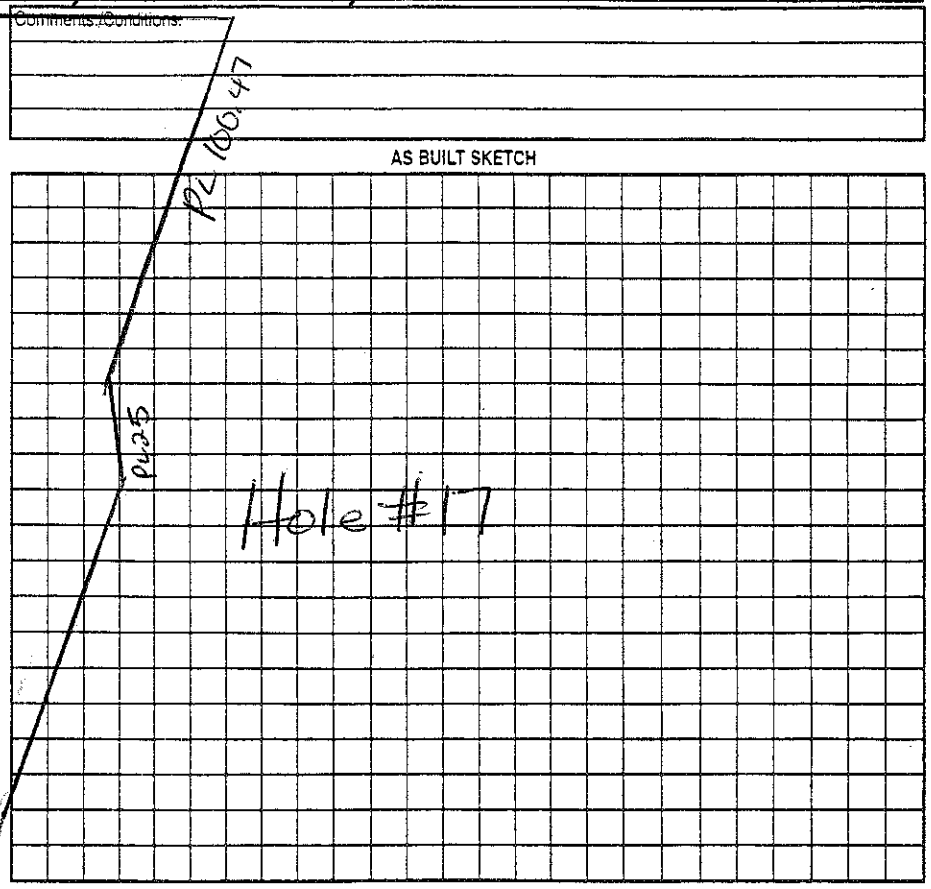

Permit can be suspended or revoked if any false information is supplied toward securing the permit/any unauthorized changes are made to the site/any unauthorized changes are made in the installation of the system. Improvement Permit with plat valid without expiration ☐ Improvement Permit with site plan valid for sixty months ☐ Authorization to Construct is valid for a period equal to that of Improvement Permit – not to exceed sixty months.

Signed: Paul Phipps date 6-6-07

Improvement Permit by: Maria H Dotson BS date 8/15/07

Authorization to Construct by: Maria H Dotson BS date 8/15/07

Installed by: Hallman Construction

Operation Permit by: Maria H Dotson RS date 8/15/07

Existing System Inspection by: date

HEALTH DEPT. COPY: WHITE OWNER COPY (FINAL): YELLOW OWNER COPY (INITIAL): PINK