130

IREDELL COUNTY HEALTH DEPARTMENT

STATESVILLE 704-878-5305 MOORESVILLE 704-664-5281

IMPROVEMENT PERMIT / AUTHORIZATION TO CONSTRUCT / OPERATION PERMIT / EXISTING SYSTEM INSPECTION

PERMIT# 18979 PIN# 4625-83-4957 . 1346 4625-82-4103 DATE June 15, 04

OWNER OR CONTRACTOR Crescent Resources Inc // The Pointe Abraham / Kingswood Custom Homes PHONE: Business _____ Home _____

ADDRESS 2214 Brawley School Rd, Mooresville, N.C. 28117

LOCATION Brawley School Rd. TL Yacht Rd TR Milford Circle on left

SUBDIVISION The Point BLOCK / SECTION 13 LOT 1346 LOT AREA 1.04ac ± .503ac SITE CLASS. PS SFE DESIGN FLOW 480 gpd L.T.A.R. .25 SFE 1358-1346

Septic Tank: ~~1000~~ 1500 Gallons; STB 444 Date 9/14/06

Pump Tank: 1000 Gallons; PT 283 Date 8/12/06

Pump Make: Bowles Model WE10/12HH Serial No. K0566964

Nitrification Field: No. Fields 1 Square Feet 1440 Linear Feet 480

No Lines 4@120' Trench Width 36" Max Trench Bottom Depth 36"

☑ New System ☐ Repair System Type: I, II, III, IV, V, VI

System Description: on 25% Reduction

Repair System Description: on 25% Reduction

Maintenance Agreement Required: ☐ Yes ☑ No

Gravel Depth NA

☑ House/Mod. Home No. Bedrooms 4

☐ Mobile Home No. Bathrooms 4

☐ Business No. Employees ____

☐ Other ____

☐ Slab ☑ Crawl Space ☐ Basement w/plumbing ☐ Basement wo/plumbing


Water Supply: ☐ Individual ☑ Public ☑ Community

Comments:/Conditions:


Comments:/Conditions: Installed EZ Flow Tanks & lines Checked 9/22/06 GM Pressure Checked 9/26/06

1" = 50'

INITIAL SITE SKETCH

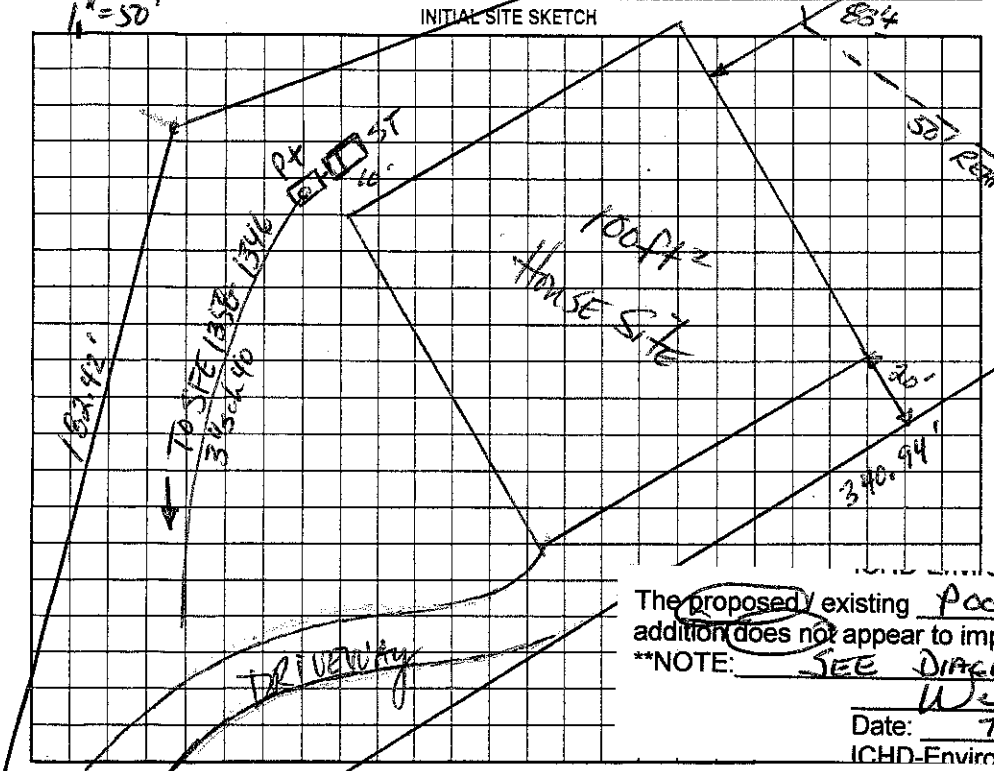

AS BUILT SKETCH 1358-1347

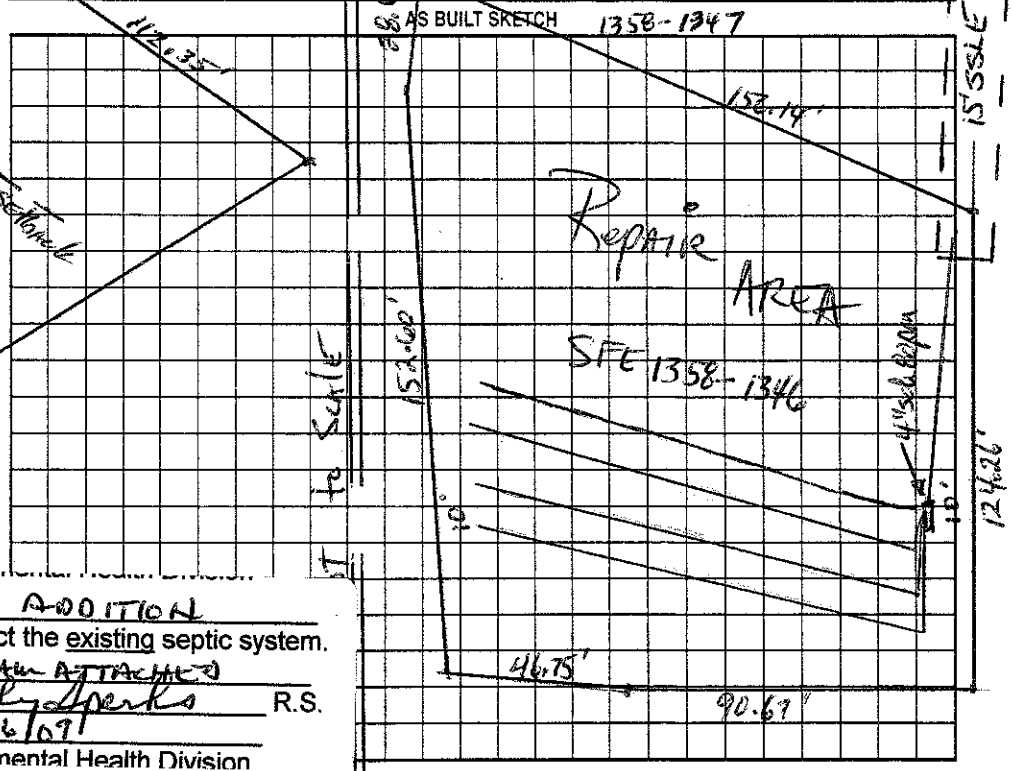

The proposed / existing POOL ADDITION addition does not appear to impact the existing septic system.

**NOTE: SEE DIAGRAM ATTACHED

Wesley Parks R.S.

Date: 7/6/07

ICHD-Environmental Health Division

Permit can be suspended or revoked if any false information is supplied toward securing the permit/any unauthorized changes are made to the site/any unauthorized changes are made in the installation of the system. Improvement Permit with plat valid without expiration. Improvement Permit with site plan valid for sixty months. Authorization to Construct is valid for a period equal to that of Improvement Permit – not to exceed sixty months.

Signed: _____ date 6-22-04 Installed by: Hallmark Pools RS

Improvement Permit by: DR Thomas RS date 6-15-04 Operation Permit by: Marvin H Folsom date 10/25/06

Authorization to Construct by: _____ date 1/10/06 Existing System Inspection by: _____ date _____

HEALTH DEPT. COPY: WHITE OWNER COPY (FINAL): YELLOW OWNER COPY (INITIAL): PINK