IREDELL COUNTY HEALTH DEPARTMENT

STATESVILLE 704-878-5305 MOORESVILLE 704-664-5281

IMPROVEMENT PERMIT / AUTHORIZATION TO CONSTRUCT / OPERATION PERMIT / EXISTING SYSTEM INSPECTION

PERMIT# 116976 PIN# 4625-83-4957.1344 4625826275 DATE

OWNER OR CONTRACTOR Crescent Resources LLC // The Point on Norman / Dienst PHONE: Business Home

ADDRESS 2214 Brawley School Rd Mooresville NC 28117

LOCATION Brawley School Rd TL Yacht Rd TL Milford Circle Lot on left SFE on Right

SUBDIVISION The Point BLOCK / SECTION 13 LOT 1344 LOT AREA .895Ac, .375Ac SFE SITE CLASS. PSSFE DESIGN FLOW 460gpd L.T.A.R. .25 SFE/1354-1344

Septic Tank: 1000+ Gallons; STB 338 Date 7/29/05

Pump Tank: 1000 Gallons; PT 29 Date 6/21/05

Pump Make: Myers Model 150 37 ME-5 Serial No.

Nitrification Field: No Fields 1 Square Feet 1440 Linear Feet 480

No Lines 4@120' Trench Width 36" Max Trench Bottom Depth 36" Gravel Depth NA

☑ New System ☐ Repair System Type: I, II, III, IV, V, VI

System Description: PM 25% Reduction on 1354-1344

Repair System Description: LPPBPS on 1354-1344

Maintenance Agreement Required: ☐ Yes ☑ No

☑ House/Mod. Home No. Bedrooms 4

☐ Mobile Home No. Bathrooms 4

☐ Business No. Employees

☐ Other


☐ Slab ☑ Crawl Space ☐ Basement w/plumbing ☐ Basement wo/plumbing

Water Supply: ☐ Individual ☑ Public ☑ Community


Comments:/Conditions:

Comments/Conditions: 3/4/05 Reviewed Building plans & Site plan; essentially in Compliance with Improvement Permit Note: Swimming pool proposed in tank location will need to move tanks to other side. MB

INITIAL SITE SKETCH

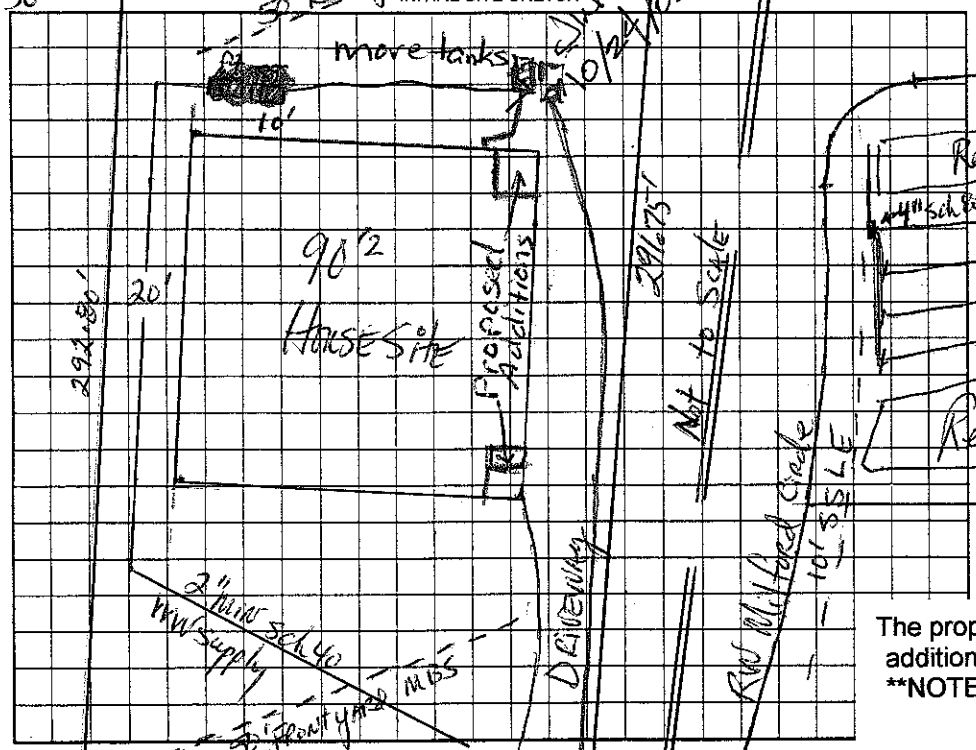

AS BUILT SKETCH

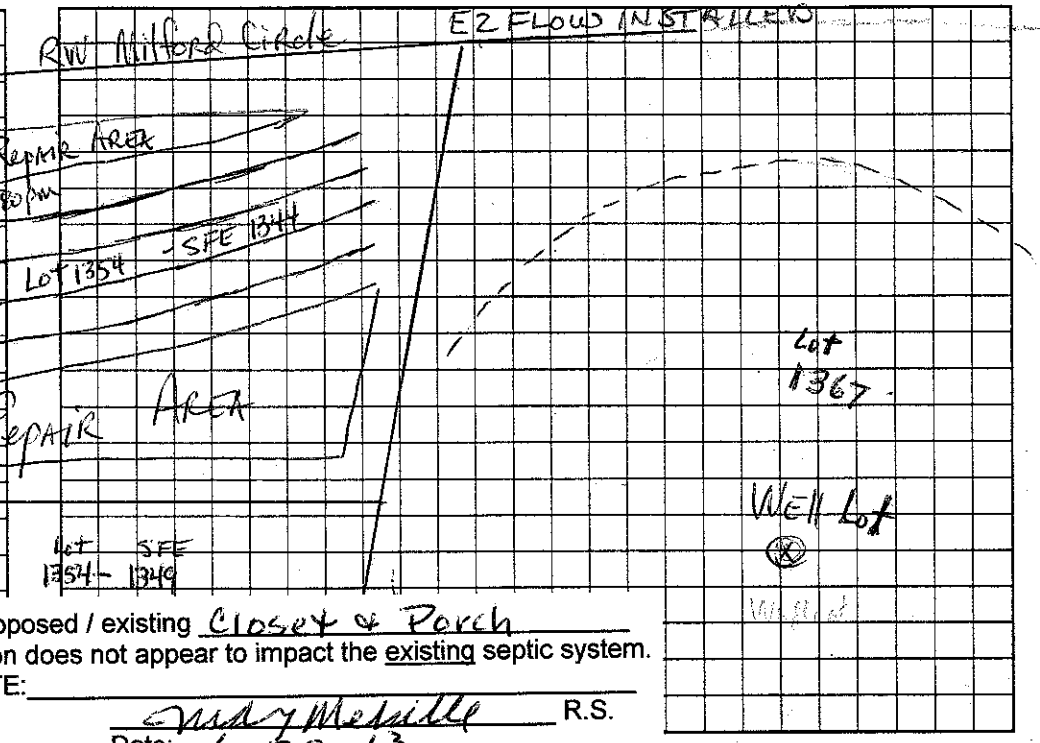

The proposed / existing Closet & Porch addition does not appear to impact the existing septic system.

**NOTE:

Cindy Melville R.S.

Date: 6-28-13

ICHD-Environmental Health Division

Permit can be suspended or revoked if any false information is supplied toward securing the permit. Authorization to Construct is valid for a period of one year from the date of issuance for installation of the system. Improvement Permit with plat valid without expiration. Improvement Permit with site plan valid for sixty months. Authorization to Construct is valid for a period equal to that of Improvement Permit – not to exceed sixty months.

Signed: date 6-28-04

Improvement Permit by: 108.84' Milford Circle date June 11, 04

Authorization to Construct by: date 3/4/05

Installed by: R+H

Operation Permit by: RS date 10/25/05

Existing System Inspection by: date