IREDELL COUNTY HEALTH DEPARTMENT

STATESVILLE 704-878-5305 — MOORESVILLE 704-664-5281

IMPROVEMENT PERMIT / AUTHORIZATION TO CONSTRUCT / OPERATION PERMIT / EXISTING SYSTEM INSPECTION

PERMIT# 118975 PIN# ~~4625 83 4959.1343~~ 4625828228 DATE 9/27/05

OWNER OR CONTRACTOR Jay Young/Builders PHONE: Business 704-947-7630 Home

ADDRESS 15665 Birkdale Commons Pkwy. Huntersville, NC. 28078

LOCATION 1100 TL Yacht Rd. TL Milford Circle on (L)

SUBDIVISION Point BLOCK / SECTION 13 LOT 343 LOT AREA .822 AC SITE CLASS. PS DESIGN FLOW 480 L.T.A.R. .3

Septic Tank: 1500 Gallons; STB 338 Date 3-7-06 ☒ New System ☐ Repair System Type: I II III IV V VI

Pump Tank: Gallons; PT Date System Description: Gravity - 25% Reduced

Pump Make: Model Serial No. Repair System Description: LAPPBPS

Nitrification Field: No Fields 1 Square Feet 1200 Linear Feet 400 Maintenance Agreement Required: ☐ Yes ☒ No

No Lines 4 @ 100' Trench Width 3' Max Trench Bottom Depth 3' Gravel Depth No

☒ House/Mod. Home No. Bedrooms 4 ☐ Mobile Home No. Bathrooms 4 ☐ Business No. Employees ☐ Other


☐ Slab ☒ Crawl Space ☐ Basement w/plumbing ☐ Basement wo/plumbing

Water Supply: ☐ Individual ☐ Public ☒ Community Point


Comments:/Conditions: REPAIR AREA

Comments:/Conditions: Installed Quick 4 as Drawn

INITIAL SITE SKETCH

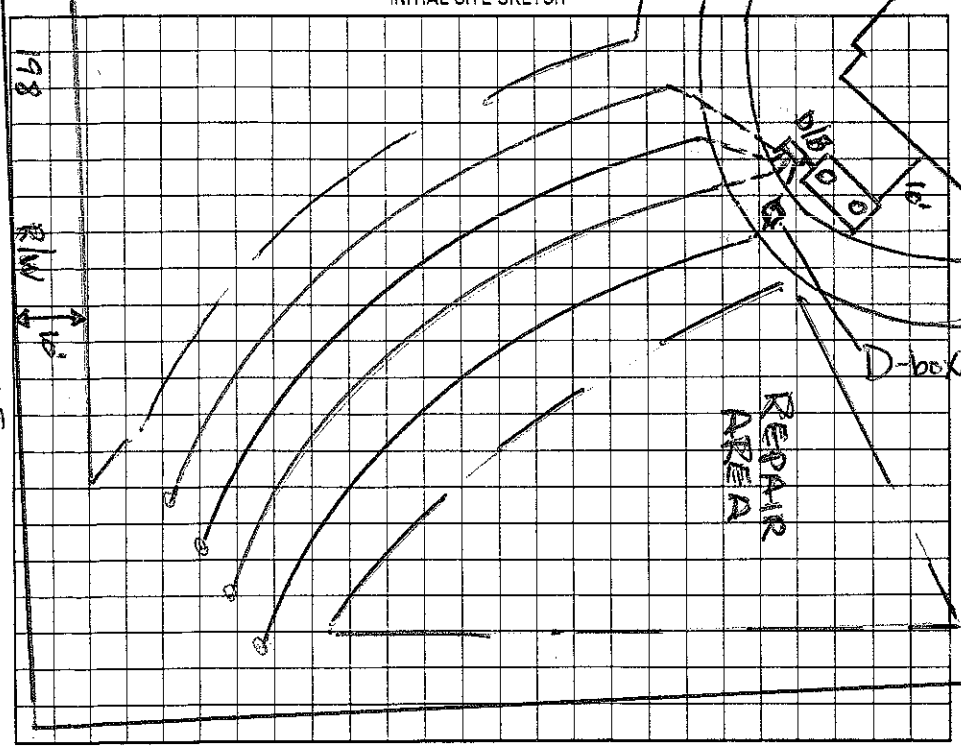

AS BUILT SKETCH

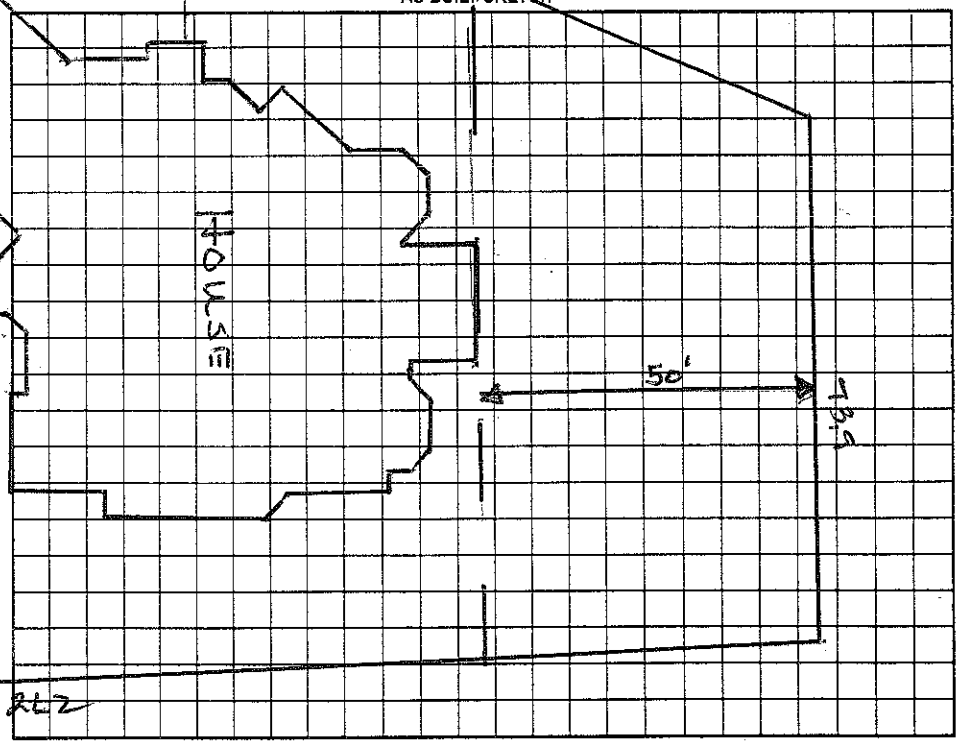

Permit can be suspended or revoked if any false information is supplied toward securing the permit/any unauthorized changes are made to the site/any unauthorized changes are made in the installation of the system. Improvement Permit with plat valid without expiration. Improvement Permit with site plan valid for sixty months. Authorization to Construct is valid for a period equal to that of Improvement Permit – not to exceed sixty months.

Signed: Margaret Young date 9/28/05 Installed by: Orbison Grading

Improvement Permit by: Wesley Sparks RS date 9/27/05 Operation Permit by: Maria H Wilson RS date 4/25/06

Authorization to Construct by: Wesley Sparks RS. date 9/27/05 Existing System Inspection by: date

HEALTH DEPT. COPY: WHITE OWNER COPY (FINAL): YELLOW OWNER COPY (INITIAL): PINK