IREDELL COUNTY HEALTH DEPARTMENT

STATESVILLE 704-878-5305 MOORESVILLE 704-664-5281

2100

IMPROVEMENT PERMIT / AUTHORIZATION TO CONSTRUCT / OPERATION PERMIT / EXISTING SYSTEM INSPECTION

PERMIT# 90698/13832/7 PIN# 4625-94-1684 PT 4625840505 DATE 10/11/00

OWNER OR CONTRACTOR CRESCENT RESOURCES / KENNETH BEALER Home Business Home

ADDRESS PO BOX 1003 CHARLOTTE NC 28201

LOCATION BRAWLEY SCHOOL - 60 PAST CIRCLE - ON RT

SUBDIVISION POINT BLOCK / SECTION 6 LOT 604 LOT AREA 47037 ft² SITE CLASS PS DESIGN FLOW 480GPD L.T.A.R. .25 GPD/FT²

Septic Tank: 1000+ Gallons; STB 338 Date 12-22-06

Pump Tank: 1000+ Gallons; PT 27 Date 1-8-07

Pump Make: Gould Model WE=03121HH Serial No.

Nitrification Field: No Fields 1 Square Feet 1440 Linear Feet 480LFD

No Lines 4@120' Trench Width 36" Max Trench Bottom Depth 36" Gravel Depth N/A

☑ New System ☐ Repair System Type: I, II, III, IV, V, VI

System Description: PUMP 25% REDUCTION

Repair System Description: 16" ~~SAND~~ LP PIPES

Maintenance Agreement Required: ☐ Yes ☑ No

☐ Slab ☑ Crawl Space ☐ Basement w/plumbing ☐ Basement wo/plumbing

☑ House/Mod. Home No. Bedrooms 4

☐ Mobile Home No. Bathrooms 4

☐ Business No. Employees

☐ Other


Water Supply: ☐ Individual ☐ Public ☑ Community

Comments:/Conditions: REMOVE TERRACES AND BERMS


Comments:/Conditions: 10/3/06 Renewed PO Form. Checked tanks & lines 3/13/07 MD Installed EZ Flow

1"=50'

INITIAL SITE SKETCH

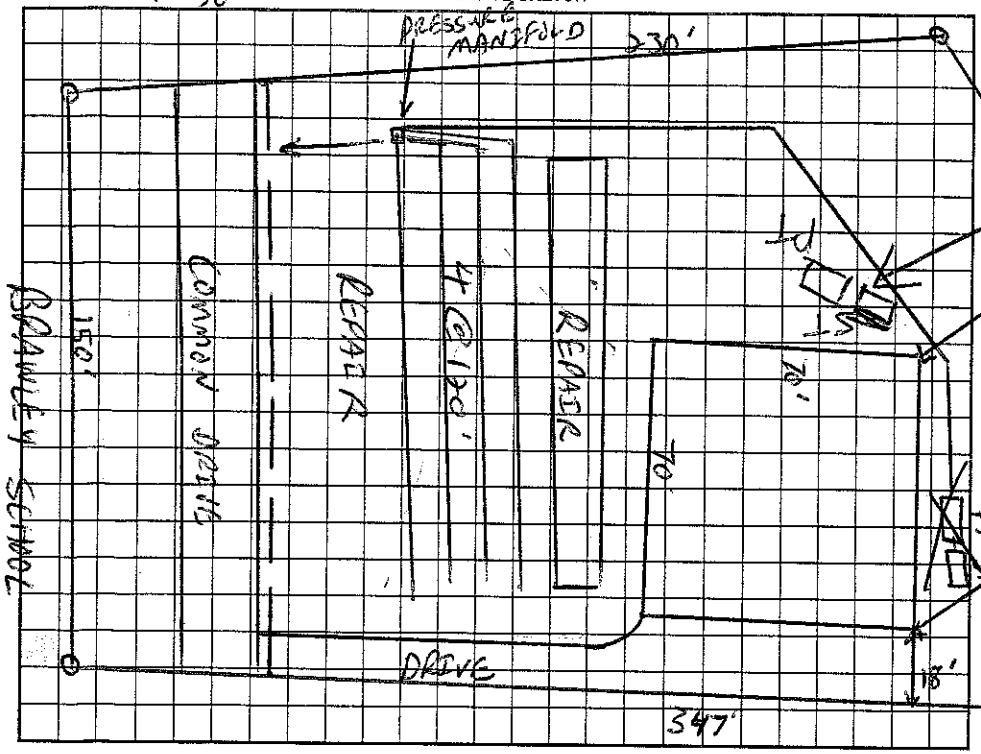

AS BUILT SKETCH

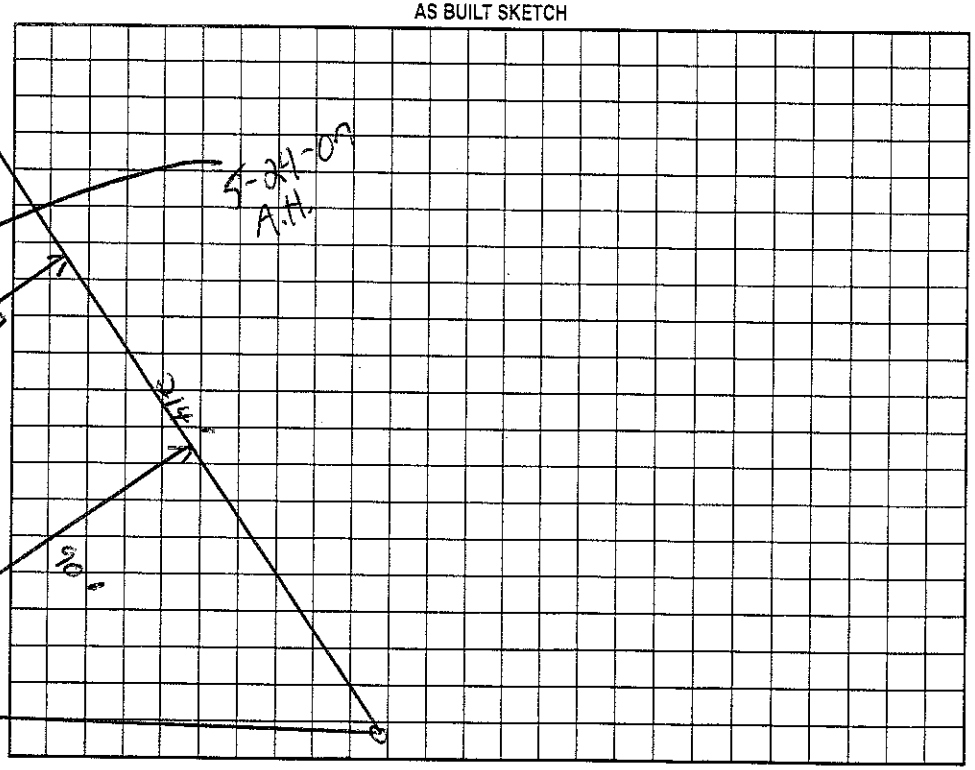

Permit can be suspended or revoked if any false information is supplied toward securing the permit/any unauthorized changes are made to the site/any unauthorized changes are made in the installation of the system. Improvement Permit with plat valid without expiration. Improvement Permit with site plan valid for sixty months. Authorization to Construct is valid for a period equal to that of Improvement Permit – not to exceed sixty months.

Signed: Terry C. Parker, CPESC Agent date 10/3/06

Improvement Permit by: C. Blake Lemm RS date 10/3/06

Authorization to Construct by: Wesley Sparks RS. date 10/3/06

Installed by: R&R Dolan RS

Operation Permit by: Mariah H. Dolan date 5/24/07

Existing System Inspection by: date

HEALTH DEPT. COPY: WHITE OWNER COPY (FINAL): YELLOW OWNER COPY (INITIAL): PINK