→ HUGHES, HAMLICK & ZANDE (BILL DOW) - OWNER

2:00

IREDELL COUNTY HEALTH DEPARTMENT

STATESVILLE 704-878-5305 MOORESVILLE 704-664-5281

IMPROVEMENT PERMIT / AUTHORIZATION TO CONSTRUCT / OPERATION PERMIT / EXISTING SYSTEM INSPECTION

PERMIT# 90697 PIN# 4625941684 PT 4625-84-0667 DATE 9-17-2001

OWNER OR CONTRACTOR Cornerstone Builders/Hughes PHONE: Business 889-8229 Home

ADDRESS 315 Main Ste E Pineville, NC 28134

LOCATION Brawley School Rd just past traffic circle on right

SUBDIVISION The Point BLOCK / SECTION 6J LOT 603 LOT AREA 48470 ft² SITE CLASS. PS DESIGN FLOW 480gpd L.T.A.R. < 3

Septic Tank: ~~1000~~ 1500+ Gallons; STB 338 Date 4-8-02

Pump Tank: 1000+ Gallons; PT 283 Date 8-5-01

Pump Make: Myers Model ME3F-21 Serial No. 1101

Nitrification Field: No. Fields 1 Square Feet 810 Linear Feet 270'

No Lines 3@90' Trench Width 24-36" Max Trench Bottom Depth 30" Gravel Depth N/A

☒ New System ☐ Repair System Type: I, II, III, IV, V, VI

System Description: Pump-Up-Panel Block

Repair System Description: Same

Maintenance Agreement Required: ☒ Yes ☐ No

☒ House/Mod. Home ☐ Mobile Home ☐ Business ☐ Other

No. Bedrooms 4 No. Bathrooms 4.5 No. Employees


☐ Slab ☒ Crawl Space ☐ Basement w/plumbing ☐ Basement wo/plumbing

Water Supply: ☐ Individual ☒ Public ☒ Community


Comments/Conditions: Remove old terraces from site. Keep Septic System at least 10' from PL

Comments/Conditions: 1) OWNERSHIP OF LOT SAME - JUST DIFFERENT BUILDER. Tanks ok to put on side of house MD Pres, eleet & alarm 1/22/03

INITIAL SITE SKETCH Scale 1:50

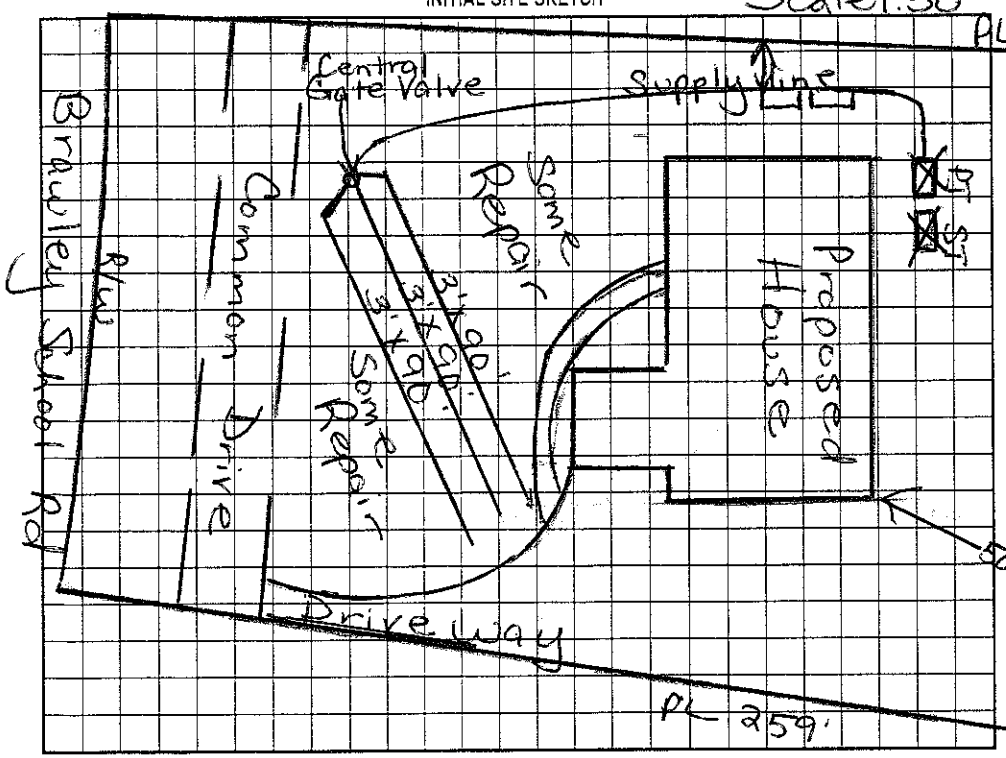

AS BUILT SKETCH

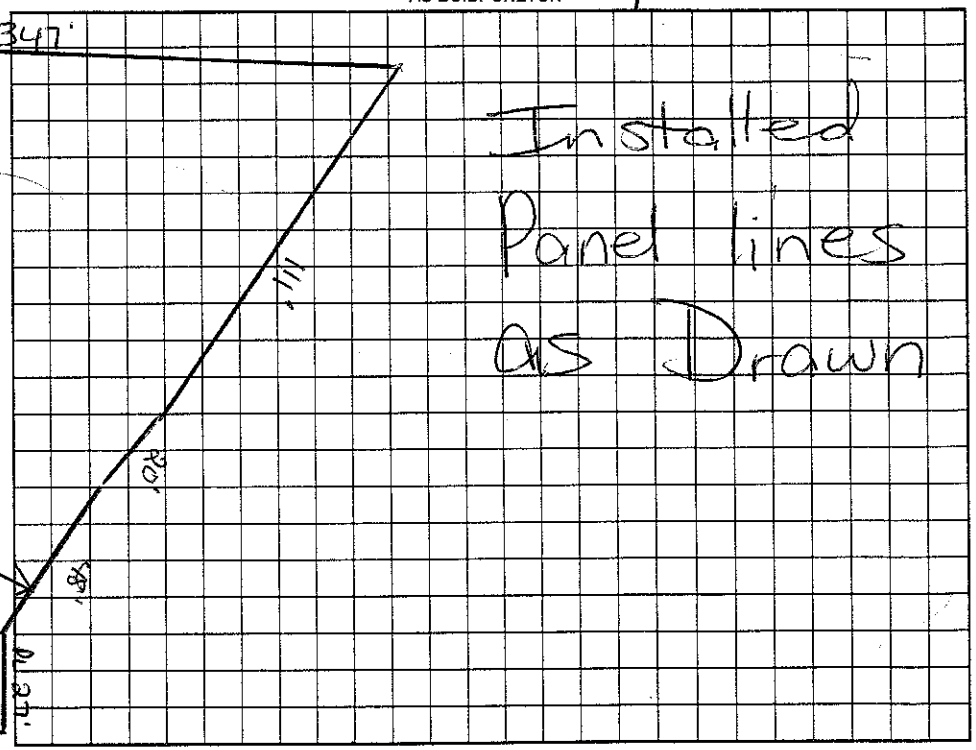

Permit can be suspended or revoked if any false information is supplied toward securing the permit/any unauthorized changes are made to the site/any unauthorized changes are made in the installation of the system. Improvement Permit with plat valid without expiration. Improvement Permit with site plan valid for sixty months. Authorization to Construct is valid for a period equal to that of Improvement Permit – not to exceed sixty months.

Signed: John W. Dowell date

Improvement Permit by: Maria H. Dotson RS 9/17/2001 date

Authorization to Construct by: Maria H. Dotson RS date 9/17/2001

Installed by: Bobby Mayhew

Operation Permit by: Maria H. Dotson RS date 1/22/03

Existing System Inspection by: date

HEALTH DEPT. COPY: WHITE OWNER COPY (FINAL): YELLOW OWNER COPY (INITIAL): PINK