IREDELL COUNTY HEALTH DEPARTMENT

STATESVILLE 704-878-5305 50.00 Paid MOORESVILLE 704-664-5281

1 PO - 12.00

IMPROVEMENT PERMIT / AUTHORIZATION TO CONSTRUCT / OPERATION PERMIT / EXISTING SYSTEM INSPECTION

PERMIT# 090696 PIN# 4625-94-1684 PF 4625-84-1861 DATE 8/20/02

OWNER OR CONTRACTOR Hughes Hanselick + Zande Bld. PHONE: Business 704-375-5999 Home

ADDRESS 909 East Blvd. Charlotte NC 28075

LOCATION Brawley Sch, on Rt just Past Traffic C.

SUBDIVISION Point BLOCK / SECTION 6 LOT 602 LOT AREA 41,415 ft² SITE CLASS. PS DESIGN FLOW 480 L.T.A.R. 0.5

Septic Tank: 1000 Gallons; STB 338 Date 12-29-02

Pump Tank: 1000 Gallons; PT 27 Date 1-11-03

Pump Make: Goulds Model iPWE032 Serial No 5033166633

Nitrification Field: No Fields 1 Square Feet 1200 Linear Feet 400

No Lines 4 @ 100' Trench Width 36" Max Trench Bottom Depth 36" Gravel Depth —

☒ New System ☐ Repair System Type: I, II, (III), IV, V, VI

System Description: Press. Man. 25% Red.

Repair System Description: LP Panel Block

Maintenance Agreement Required: ☐ Yes ☒ No

☒ House/Mod. Home ☐ Mobile Home ☐ Business ☐ Other

No. Bedrooms 4 No. Bathrooms 4 No. Employees


☐ Slab ☒ Crawl Space ☐ Basement w/plumbing ☐ Basement wo/plumbing

Water Supply: ☐ Individual ☐ Public ☒ Community

Comments:/Conditions:

Comments:/Conditions:

INITIAL SITE SKETCH

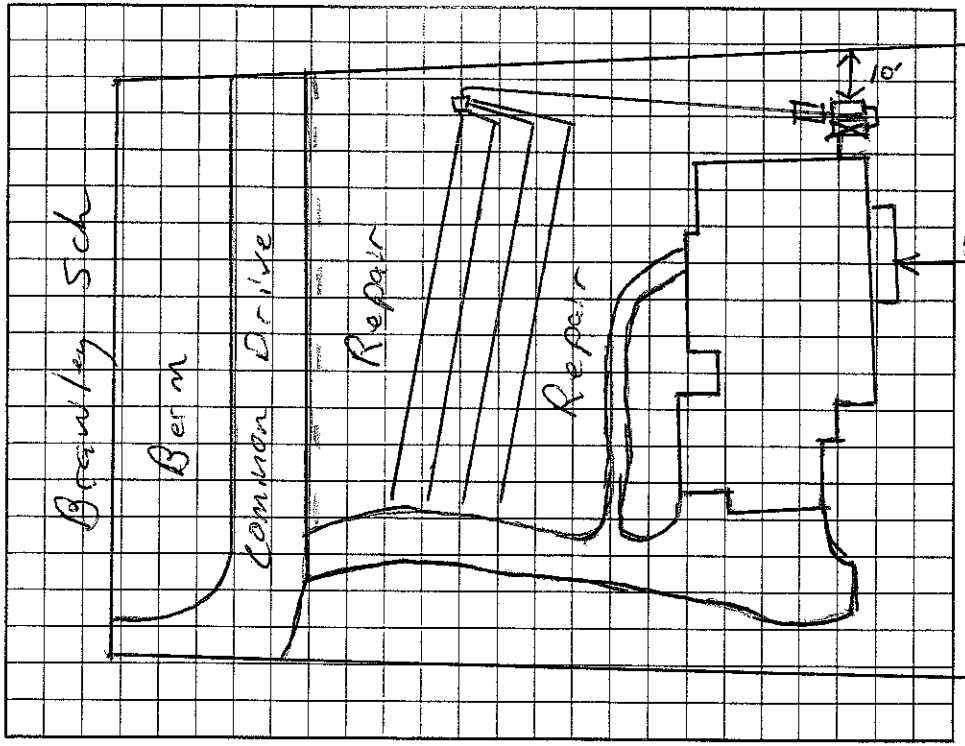

AS BUILT SKETCH

Installed EZ Flow As Drawn

Permit can be suspended or revoked if any false information is supplied toward securing the permit/any unauthorized changes are made to the site/any unauthorized changes are made in the installation of the system. Improvement Permit with plat valid without expiration. Improvement Permit with site plan valid for sixty months. Authorization to Construct is valid for a period equal to that of Improvement Permit – not to exceed sixty months.

Signed: Copy date 8-21-02 Installed by: Mayhew Septics RS

Improvement Permit by: RS date 8/20/02 Operation Permit by: RS date 3/26/03

Authorization to Construct by: RS date 8/20/02 Existing System Inspection by: date

HEALTH DEPT. COPY: WHITE OWNER COPY (FINAL): YELLOW OWNER COPY (INITIAL): PINK