IREDELL COUNTY HEALTH DEPARTMENT

STATESVILLE 704-878-5305 — MOORESVILLE 704-664-5281

IMPROVEMENT PERMIT / AUTHORIZATION TO CONSTRUCT / OPERATION PERMIT / EXISTING SYSTEM INSPECT.

129013

PERMIT# 90645 PIN# 4625941684 PT 4625-84-2972 DATE 9/13/00

OWNER OR CONTRACTOR CRESCENT RESOURCES / HHZ PHONE: Business 663-6905 Home

ADDRESS PO BOX 1003 CHARLOTTE NC 28201

LOCATION BRAWLEY SCHOOL PAST TRAFFIC CIRCLE ON RT B-4 STONEWALL BEACH

SUBDIVISION POINT BLOCK / SECTION 6 LOT 601 LOT AREA 40,019 ft² SITE CLASS PS DESIGN FLOW 480GPD L.T.A.R. .3090/ft²

Septic Tank: 1000+ Gallons; STB 338 Date 5/22/05

Pump Tank: 1000+ Gallons; PT 27 Date 7/22/05

Pump Make: Model Serial No.

Nitrification Field: No Fields 1 Square Feet 1200 Linear Feet 400

No Lines 4@100' Trench Width 36" Max Trench Bottom Depth 36" Gravel Depth N/A

☑ New System ☐ Repair System Type: I, II, III, IV, V, VI

System Description: PUMP @ 25% REDUCTION

Repair System Description: PUMP PANEL

Maintenance Agreement Required: ☐ Yes ☑ No

☑ House/Mod. Home No. Bedrooms 4

☐ Mobile Home No. Bathrooms 4

☐ Business No. Employees

☐ Other


☐ Slab ☑ Crawl Space ☐ Basement w/plumbing ☐ Basement wo/plumbing

Water Supply: ☐ Individual ☐ Public ☑ ~~Community~~


Comments:/Conditions: REMOVE ANY FARM TERRACES

Comments:/Conditions: Reviewed plans 5/24/05 MB
Checked lines 8/24/05 MB
Installed EJ Flow as Drawn
Checked tanks 8/26/05

INITIAL SITE SKETCH 1"=50'

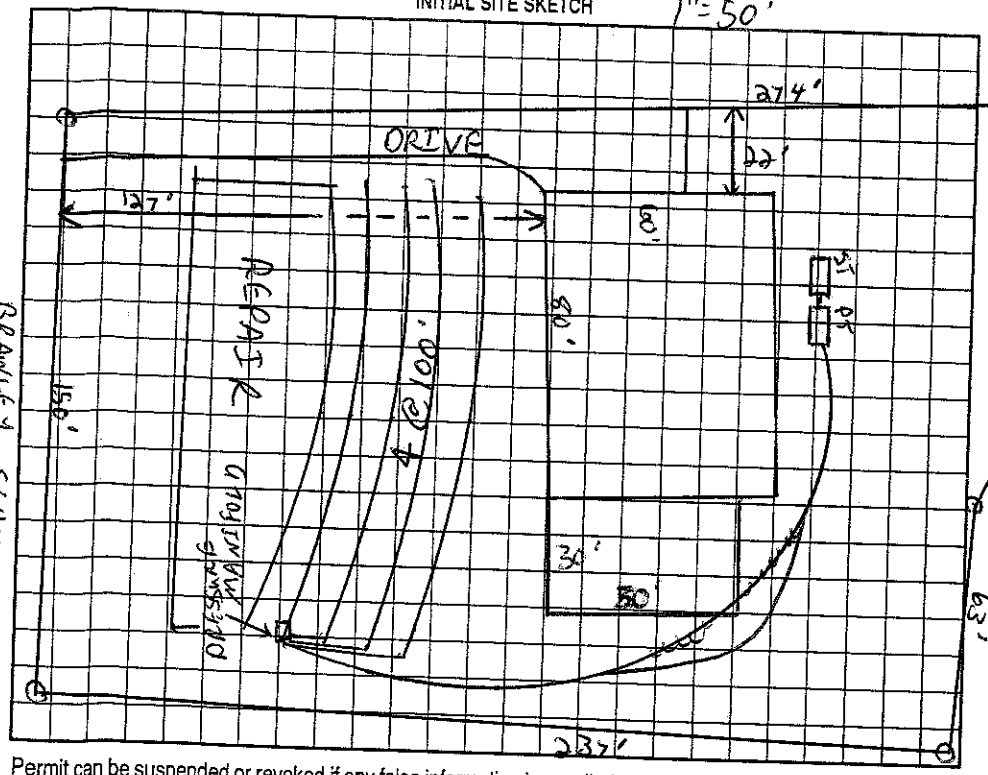

AS BUILT SKETCH

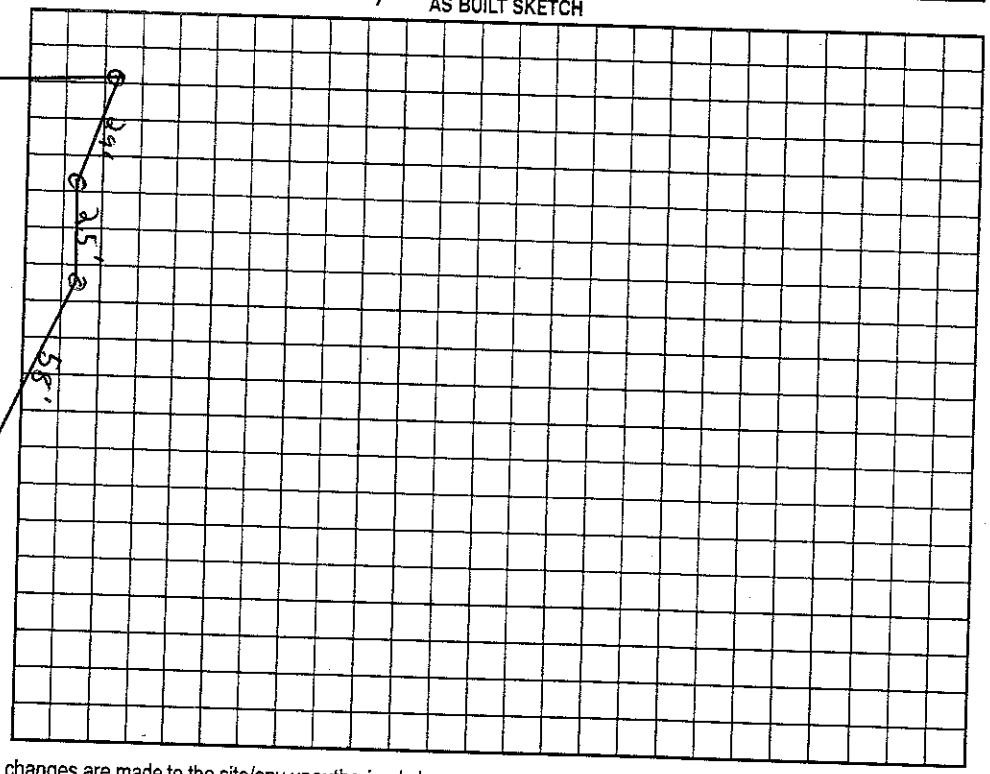

BRAWLEY SCHOOL

Permit can be suspended or revoked if any false information is supplied toward securing the permit/any unauthorized changes are made to the site/any unauthorized changes are made in the installation of the system. Improvement Permit with plat valid without expiration. Improvement Permit with site plan valid for sixty months. Authorization to Construct is valid for a period equal to that of Improvement Permit – not to exceed sixty months.

Signed: Larry Clarke, LSS (Agent) date 10/25/00

Improvement Permit by: [illegible] RS date 9/13/00

Authorization to Construct by: Maria H. Dobson RS date 5/24/05

Installed by: Bobby Mayberry

Operation Permit by: Maria H. Dobson RS date 10/24/05

Existing System Inspection by: date

HEALTH DEPT. COPY: WHITE OWNER COPY (FINAL): YELLOW OWNER COPY (INITIAL): PINK