$325

IREDELL COUNTY HEALTH DEPARTMENT

STATESVILLE 704-878-5305 MOORESVILLE 704-664-5281

IMPROVEMENT PERMIT / AUTHORIZATION TO CONSTRUCT / OPERATION PERMIT / EXISTING SYSTEM INSPECTION

PERMIT# 081397 PIN# 4625-85-0302 DATE Sept. 9, '99

OWNER OR CONTRACTOR Crescent Resources thru/ The Point by Norman PHONE: Business 660-1165 Home

ADDRESS 2214 Brawley Sch Rd. Mooresville

LOCATION Brawley Sch Rd. TR Polaris TL Jeremy Point Place on left #131

SUBDIVISION The Point BLOCK / SECTION 5 LOT 563 LOT AREA 45,586 ft² SITE CLASS. PS DESIGN FLOW 440gpd L.T.A.R. .025

Septic Tank: 1000+ Gallons; STB 338 Date 1-25-03

Pump Tank: 1000 Gallons; PT 283 Date 1-12-03

Pump Make: Model Serial No.

Nitrification Field: No Fields 1 Square Feet 1020 Linear Feet 340

No Lines 4 Trench Width 36" Max Trench Bottom Depth 36" Gravel Depth NA

☑ New System ☐ Repair System Type: I, II, III, ⓘV, V, VI

System Description: LP Panel Block

Repair System Description: SAME

Maintenance Agreement Required: ☑ Yes ☐ No

☑ House/Mod. Home No. Bedrooms 4

☐ Mobile Home No. Bathrooms 4

☐ Business No. Employees

☐ Other


☑ Slab ☑ Crawl Space ☑ Basement w/plumbing ☐ Basement wo/plumbing

Water Supply: ☐ Individual ☑ Public ☑ Community


Comments/Conditions:

Comments/Conditions: (PARTIAL) 77 panels used 5/32" hole drilled.
Plans Reviewed 7/16/02
OK to Switch Tanks to other side of house

1"=50' INITIAL SITE SKETCH

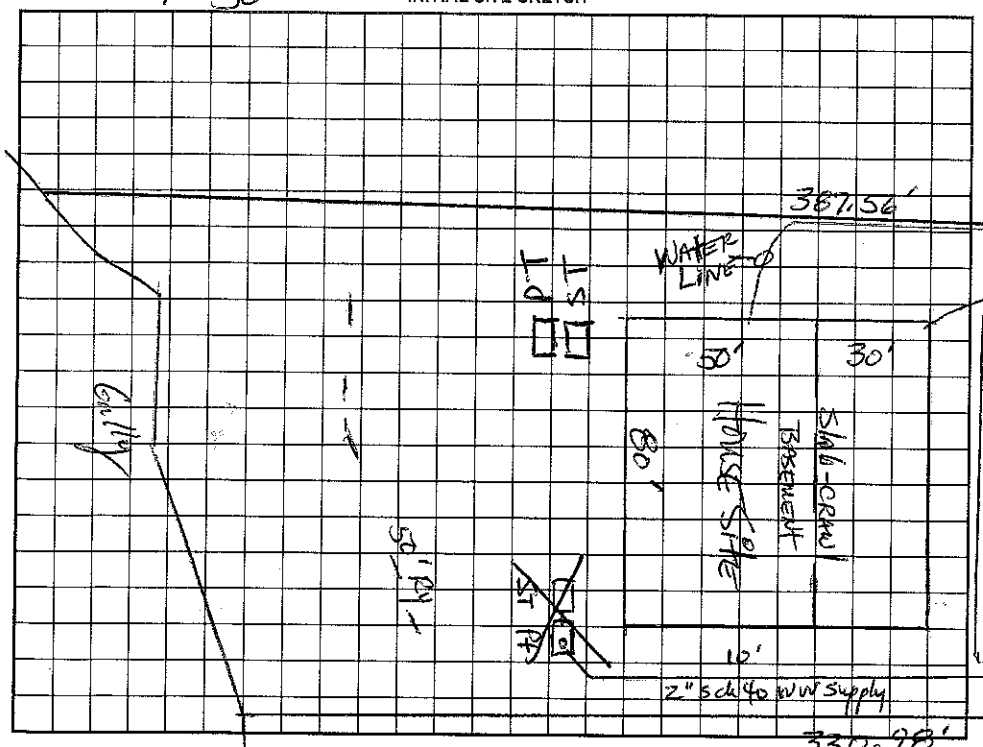

AS BUILT SKETCH

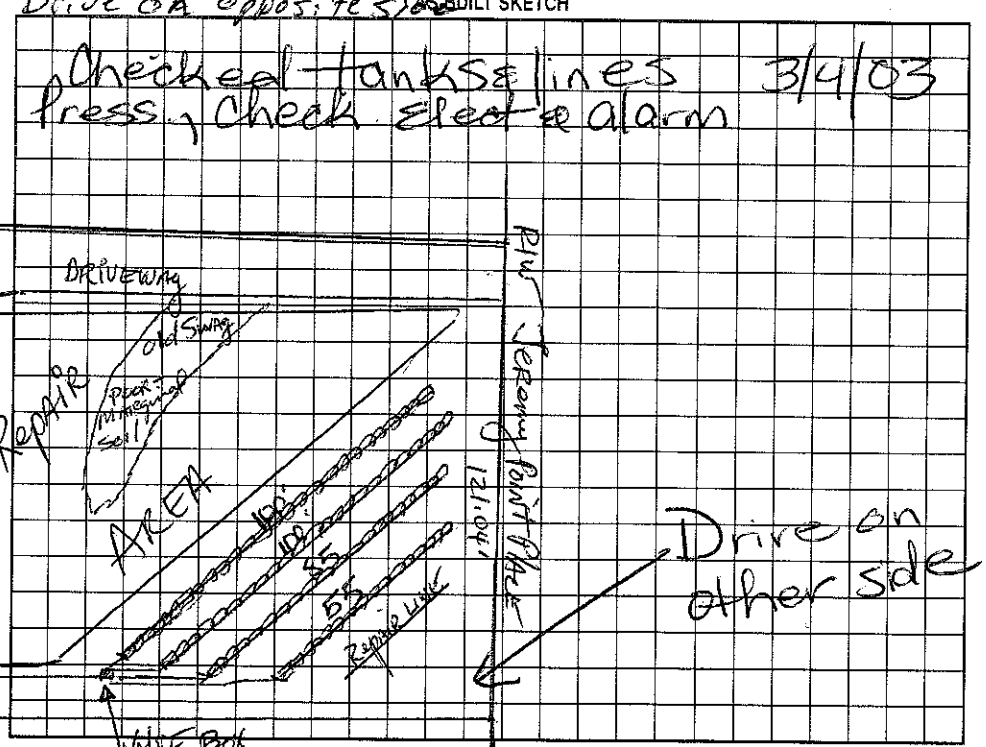

Permit can be suspended or revoked if any false information is supplied toward securing the permit/any unauthorized changes are made to the site/any unauthorized changes are made in the installation of the system. Improvement Permit with plat valid without expiration. Improvement Permit with site plan valid for sixty months. Authorization to Construct is valid for a period equal to that of Improvement Permit – not to exceed sixty months.

Signed: date 9-10-99

Improvement Permit by: date 9-9-99

Authorization to Construct by: date 7/16/02

Installed by: R & H Inc

Operation Permit by: date 3/25/03

Existing System Inspection by: date

HEALTH DEPT. COPY: WHITE OWNER COPY (FINAL): YELLOW OWNER COPY (INITIAL): PINK