IREDELL COUNTY HEALTH DEPARTMENT

STATESVILLE 704-878-5305 MOORESVILLE 704-664-5281

IMPROVEMENT PERMIT / AUTHORIZATION TO CONSTRUCT / OPERATION PERMIT / EXISTING SYSTEM INSPECTION

PERMIT# 081391 PIN# 4625941684 (pt.) Hawkins, Hamlick & Zarbo 4625850719 DATE Sept. 13, '99

OWNER OR CONTRACTOR Crescent Resources Inc. // The Point on Norman // PHONE: Business 660-1185 Home

ADDRESS 7214 Brawley Sch Rd. Mooresville

LOCATION Brawley Sch Rd. TR Polpis Tr Jeremy Point on Right at jct. w/ Brick Kiln Rd.

SUBDIVISION The Point BLOCK / SECTION 5 LOT 555 LOT AREA 36,199 ft² SITE CLASS. R5 DESIGN FLOW 480 gpd L.T.A.R. .025

Septic Tank: 1000+ Gallons; STB 338 Date

Pump Tank: 1000 Gallons; PT 283 Date

Pump Make: Myers Model ME3F21 Serial No.

Nitrification Field: No Fields Square Feet 1440 Linear Feet 480

No Lines 6@80 Trench Width 36" Trench Bottom Depth 36" Gravel Depth NA

☑ New System ☐ Repair System Type: I, II, III, IV, V, VI

System Description: PM - Innovative -25% Reduction

Repair System Description: Same

Maintenance Agreement Required: ☐ Yes ☑ No

☑ House/Mod. Home No. Bedrooms 4

☐ Mobile Home No. Bathrooms 4

☐ Business No. Employees

☐ Other

☐ Slab ☑ Crawl Space ☐ Basement w/plumbing ☐ Basement wo/plumbing

Water Supply: ☐ Individual ☑ Public ☑ Community

Comments:/Conditions:

(8) Install Laterals at 36" to.


Feb 1, 01 Reviewed house & site plan; appears substantially in compliance w/ I.P. BR

Comments:/Conditions: Per Bobby, soil really compacted. MB

Lines checked 8/28/2001 Installed EZ Flow


1" = 50'

INITIAL SITE SKETCH

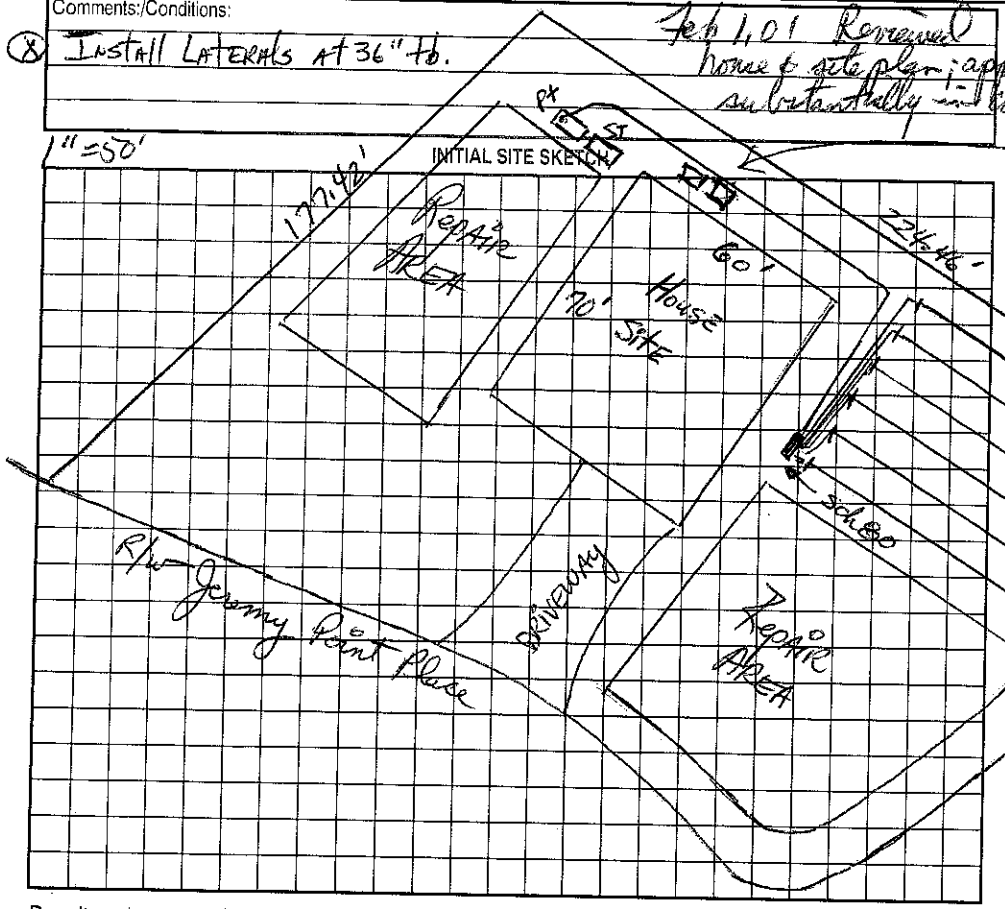

AS BUILT SKETCH

Okay to change tanks to here 10' from PL

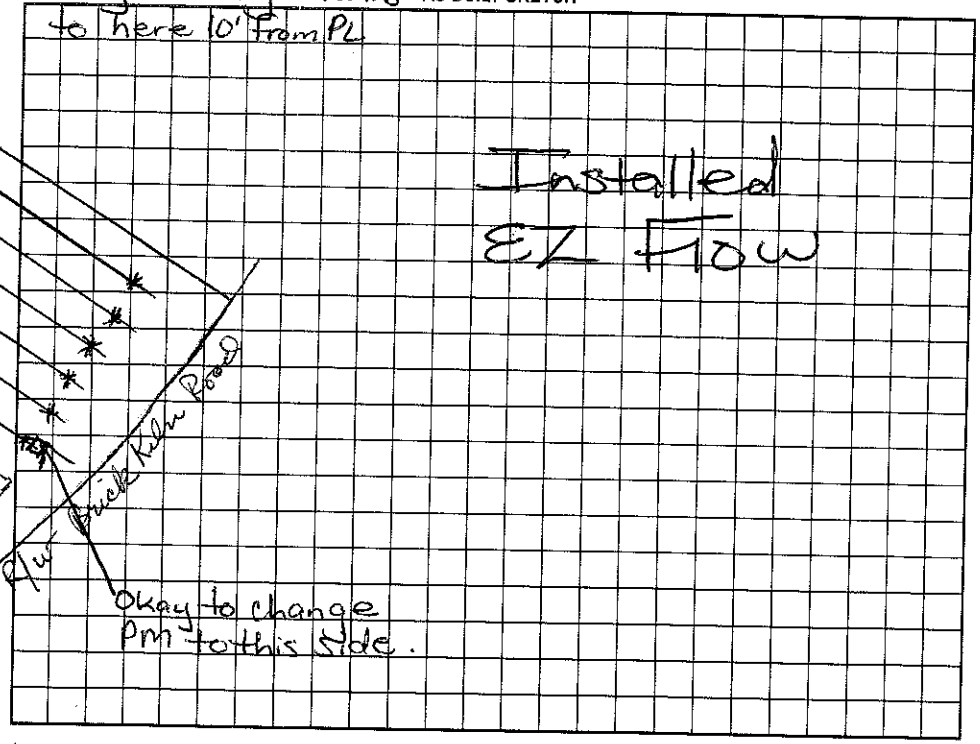

Permit can be suspended or revoked if any false information is supplied toward securing the permit/any unauthorized changes are made to the site/any unauthorized changes are made in the installation of the system. Improvement Permit with plat valid without expiration. Improvement Permit with site plan valid for sixty months. Authorization to Construct is valid for a period equal to that of Improvement Permit – not to exceed sixty months.

Signed: date 9-17-99

Improvement Permit by: RS date 9-13-99

Authorization to Construct by: RS date 2-01-01

Installed by: Bobby Mathews RS

Operation Permit by: RS date 11/1/2001

Existing System Inspection by: date

HEALTH DEPT. COPY: WHITE OWNER COPY (FINAL): YELLOW OWNER COPY (INITIAL): PINK