IREDELL COUNTY HEALTH DEPARTMENT

STATESVILLE 704-878-5305 MOORESVILLE 704-664-5281

IMPROVEMENT PERMIT / AUTHORIZATION TO CONSTRUCT / OPERATION PERMIT / EXISTING SYSTEM INSPECTION

PERMIT# 14138P PIN# 4346258514 21 DATE 4-3-07

OWNER OR APPLICANT Courtland Properties Inc PHONE: Business 894-0786 Home

ADDRESS 116 Easton Drive Mooresville NC 28117

LOCATION Brawley School Rd TR Polpis TL Jeremy Point Place on left

SUBDIVISION The Point BLOCK / SECTION 5 LOT 56 LOT AREA 50,821 ft² SITE CLASS PS DESIGN FLOW 600gpd T.A.R. 3

Septic Tank: 1500 Gallons; STB 338 Date 12/9/07

Pump Tank: 1500 Gallons; PT 477 Date 9/5/07

Pump Make: MYERS Model ME 50-21 Serial No.

Nitrification Field: No Fields 1 Square Feet 1500 Linear Feet 500

No Lines 5@100 Trench Width 36" Max Trench Bottom Depth 36"

☒ New System ☐ Repair ☐ Expansion System Type: I II (III) IV V VI

System Description: Pump - 25% Reduction

Repair System Description: 4 Panel Blk

Maintenance Agreement Required: ☐ Yes ☒ No

Gravel Depth N/A ☐ Gravity ☒ Pressure

☒ House/Mod. Home ☐ Mobile Home ☐ Business ☐ Other

No. Bedrooms 5 No. Persons No. Employees


Water Supply: ☐ Individual ☒ Public ☒ Community

☐ Slab ☐ Crawl Space ☒ Basement w/plumbing ☐ Basement wo/plumbing

Comments:/Conditions:


Scale 1:50

INITIAL SITE SKETCH

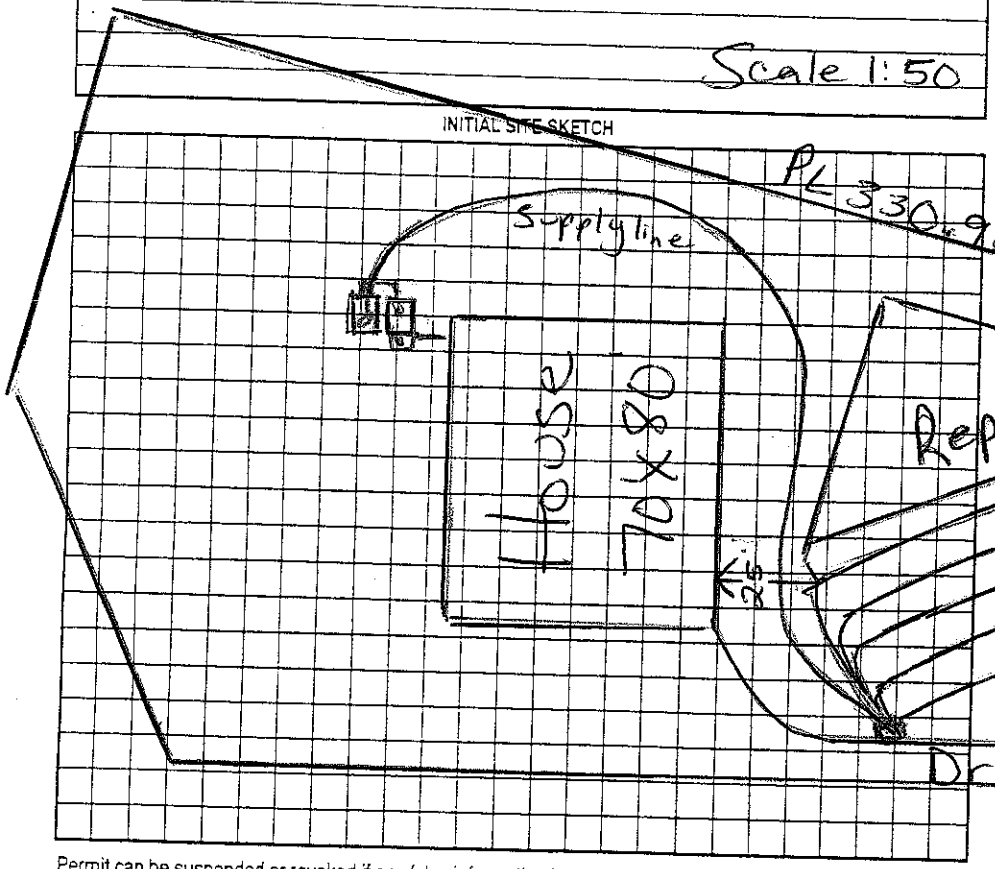

Comments:/Conditions: Must keep Drainfield at least 25ft from basement wall

AS BUILT SKETCH

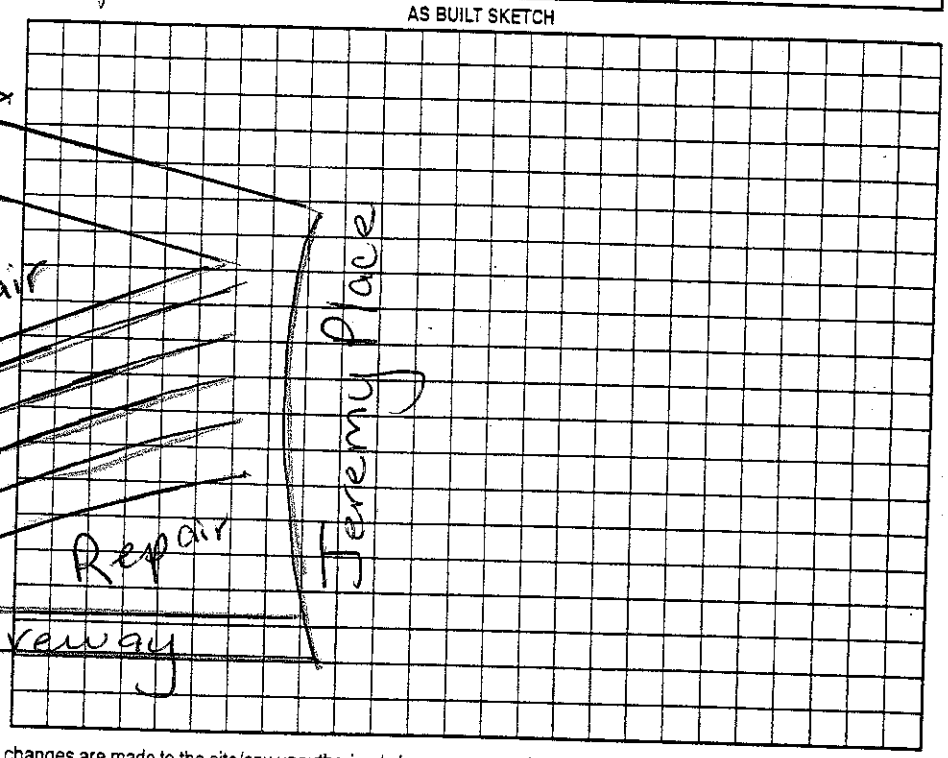

Permit can be suspended or revoked if any false information is supplied toward securing the permit/any unauthorized changes are made to the site/any unauthorized changes are made in the installation of the system. Improvement Permit with plat valid without expiration ☐ Improvement Permit with site plan valid for sixty months ☐. Authorization to Construct is valid for a period equal to that of Improvement Permit – not to exceed sixty months.

Signed: RS date 4/4/07

Improvement Permit by: Marian H. Coleson date 4/4/07

Authorization to Construct by: Marian H. Coleson date 4/4/07

Installed by: Tarheel Septic Tank - Stanley Septic Tanks

Operation Permit by: date 5-3-08

Existing System Inspection by: date

HEALTH DEPT. COPY: WHITE OWNER COPY (FINAL): YELLOW OWNER COPY (INITIAL): PINK