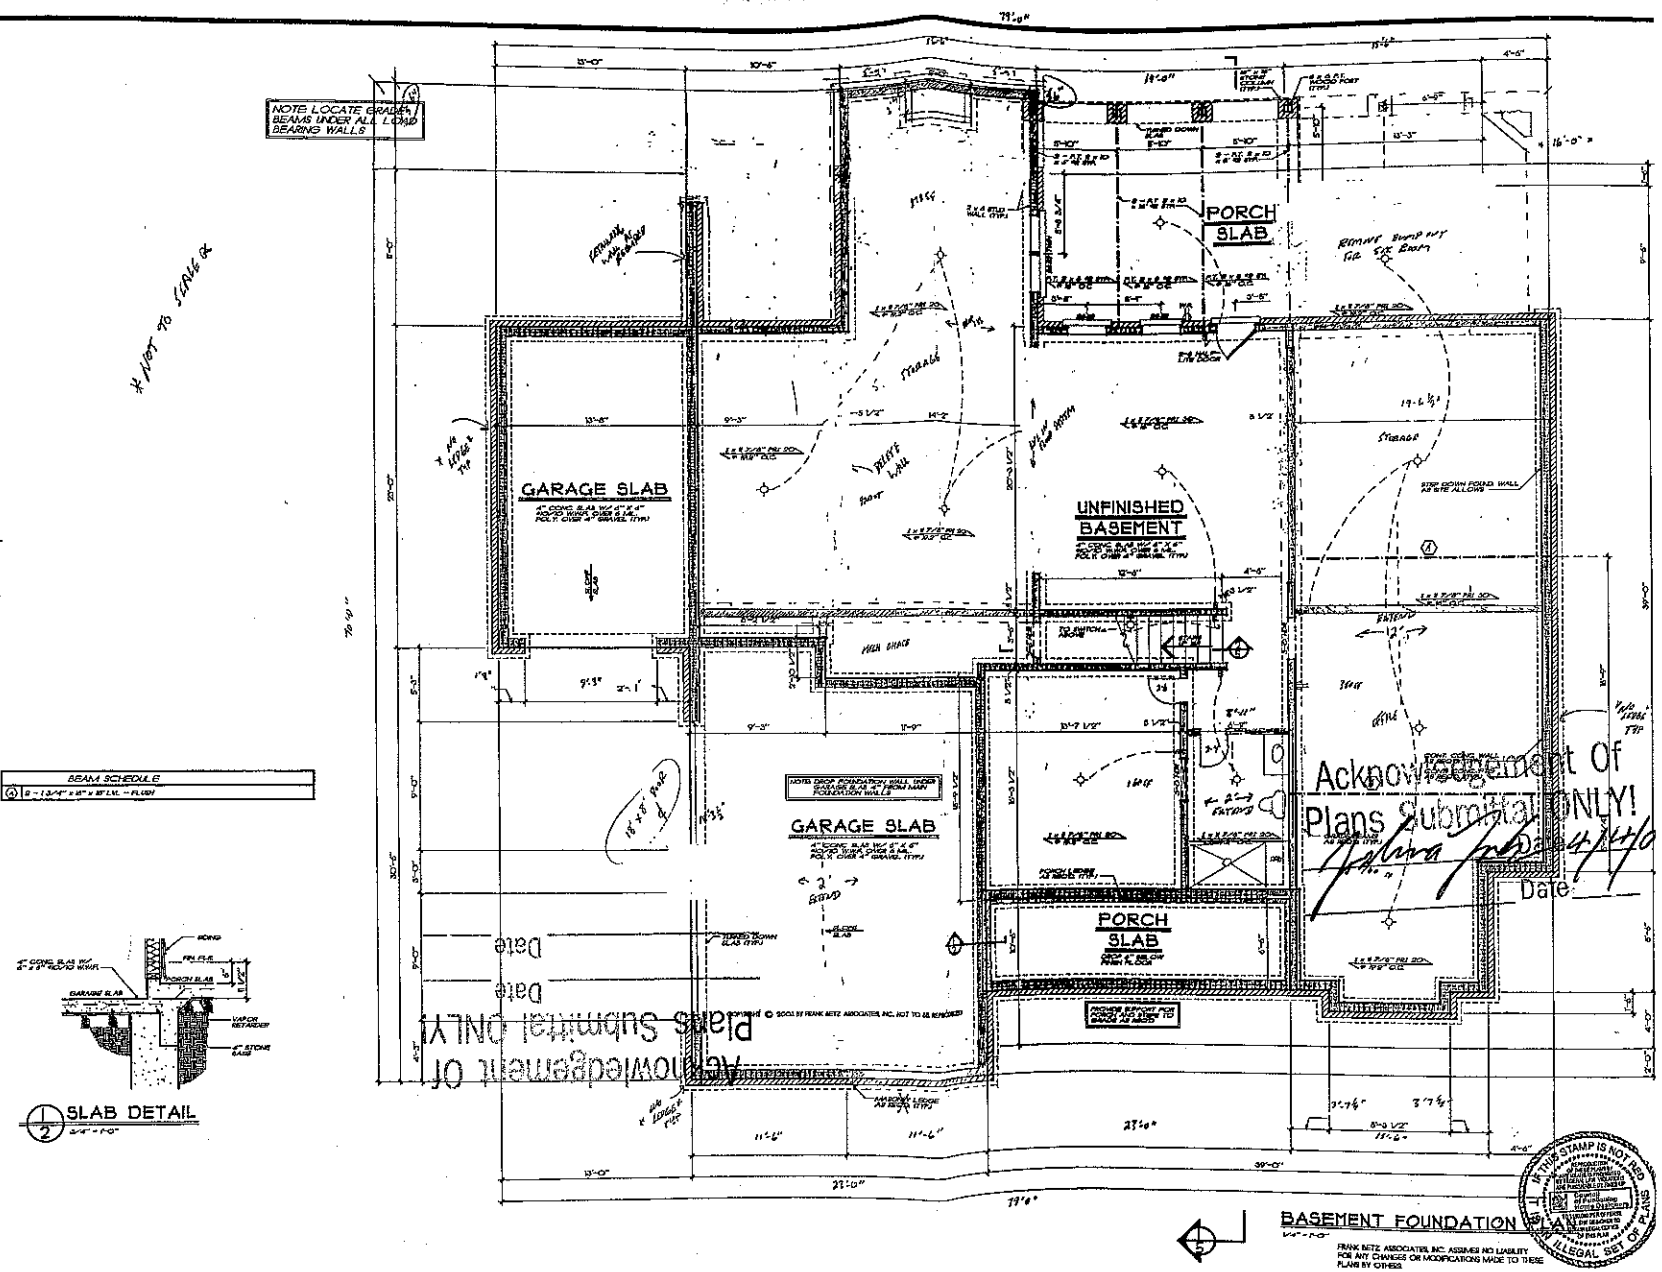

NOTE: LOCATE GRADE BEAMS UNDER ALL LOAD BEARING WALLS
* NOT TO SCALE
GARAGE SLAB
UNFINISHED BASEMENT
PORCH SLAB
GARAGE SLAB
PORCH SLAB
STORAGE
BEAM SCHEDULE
Ⓐ 8 - 13 3/4" x 18" x 38' LVL - FLUSH
SLAB DETAIL
BASEMENT FOUNDATION PLAN
Acknowledgement of Plans Submittal ONLY!
Date
Date
Acknowledgement of Plans Submittal ONLY!
IF THIS STAMP IS NOT RED IT IS AN ILLEGAL SET OF PLANS




























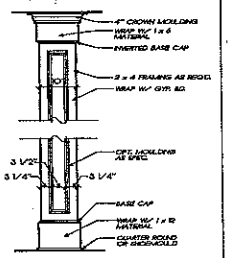

1/3 INT. COLUMN DETAIL
3/4" = 1'-0"

BEAM SCHEDULE
2 - 1 3/4" X 9 7/16" X 10'-0" LVL. - DROPPED
2 - 1 3/4" X 9 7/16" X 10'-0" LVL. - DROPPED
2 - 1 3/4" X 11" X 12'-0" JOIST - FLUSH
3 - 1 3/4" X 11" X 22' LVL. - FLUSH
2 - 1 3/4" X 9 7/16" X 11'-0" LVL. - DROPPED
3 - 1 3/4" X 9 7/16" X 6'-0" LVL. - DROPPED
2 - 1 3/4" X 9 1/4" X 6'-0" LVL. - DROPPED
2 - 1 3/4" X 9 1/4" X 6'-0" LVL. - FLUSH
2 - 1 3/4" X 9 7/16" X 22'-0" LVL. - FLUSH
3 - 1 3/4" X 9 7/16" X 18'-0" LVL. - FLUSH
3 - 1 3/4" X 9 7/16" X 22'-0" LVL. - FLUSH
5 - 1 3/4" X 9 7/16" X 18'-0" LVL. - FLUSH
2 - 2 X 10 X 6'-0" 6X10 - FLUSH
2 - 2 X 10 X 6'-0" 6X10 - DROPPED
2 - 1 3/4" X 9 1/4" X 22'-0" LVL. - DROPPED
2 - 2 X 10 X 10'-0" 10 6X10 - DROPPED
2 - 1 3/4" X 9 1/4" X 6'-0" LVL. - FLUSH
2 - 1 3/4" X 9 1/4" X 10'-0" LVL. - DROPPED
2 - 2 X 12 X 6'-0" 6X12 - BOOK MARK
4 - 1 3/4" X 9 7/16" X 9'-0" LVL. - FLUSH
4 - 1 3/4" X 16" X 20' LVL. - FLUSH

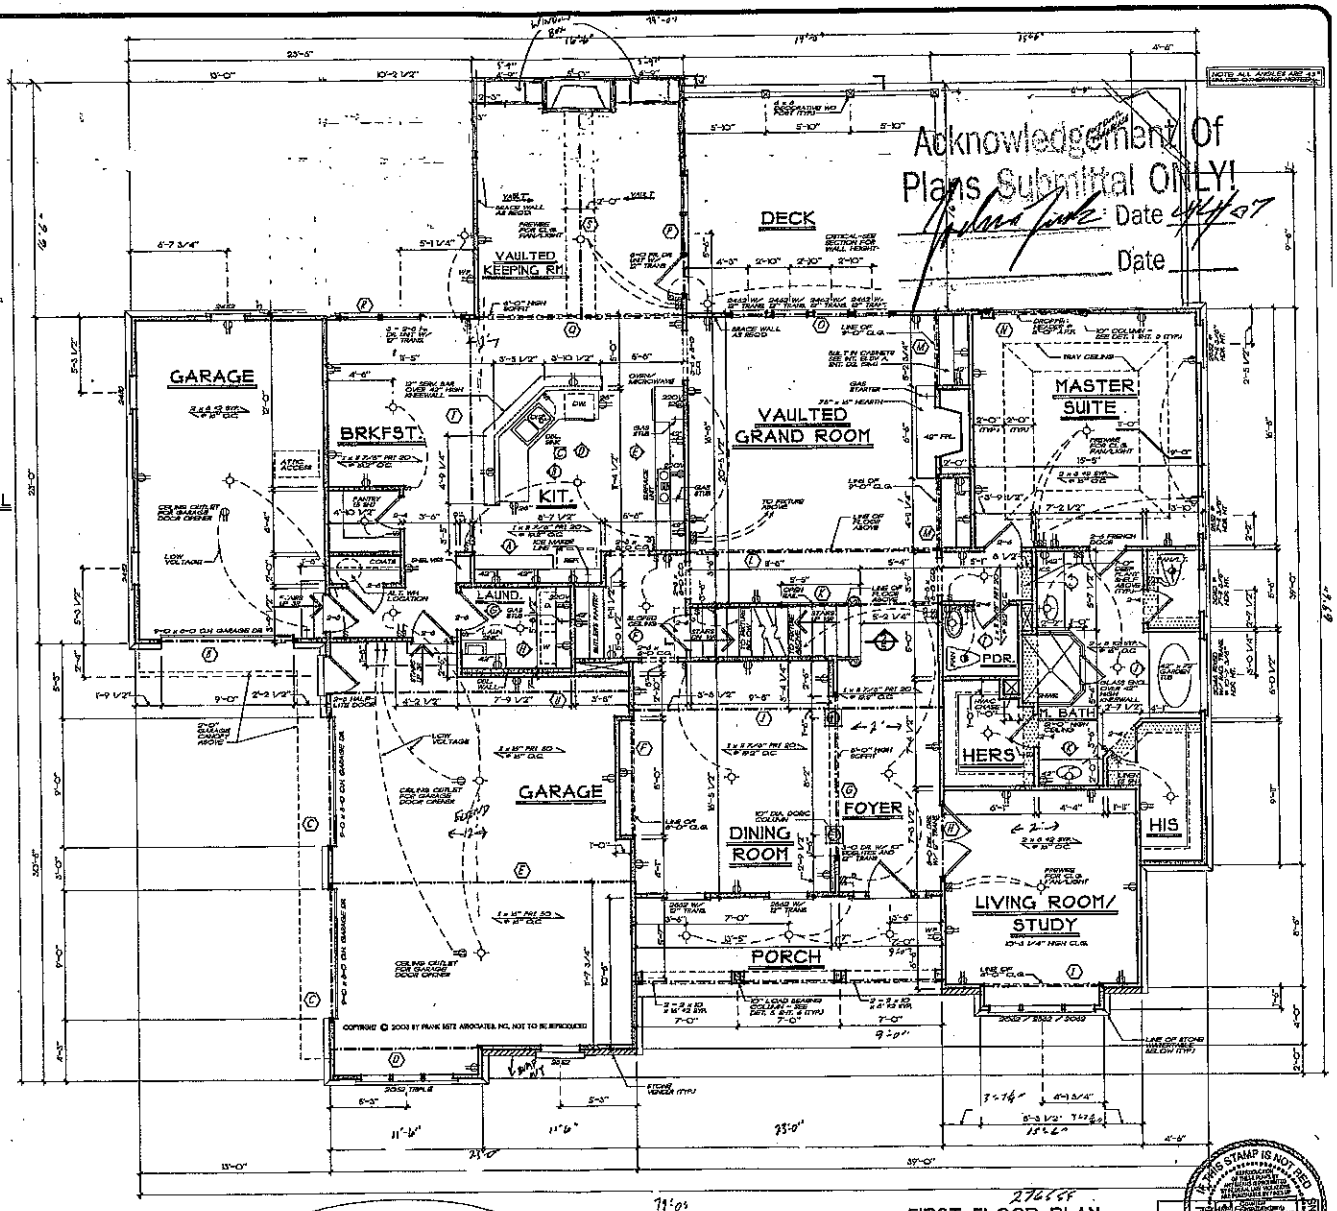

Acknowledgement Of Plans Submittal ONLY!
Date 4/4/07
Date

2766 SF


FIRST FLOOR PLAN
1/4" = 1'-0"

NOT TO SCALE

FRANK SITZ ASSOCIATES, INC. ASSUMES NO LIABILITY FOR ANY CHANGES OR MODIFICATIONS MADE TO THESE PLANS BY OTHERS.

COPYRIGHT © 2003 BY FRANK SITZ ASSOCIATES, INC. NOT TO BE REPRODUCED

THIS STAMP IS NOT RED INK ILLEGAL TO COPY

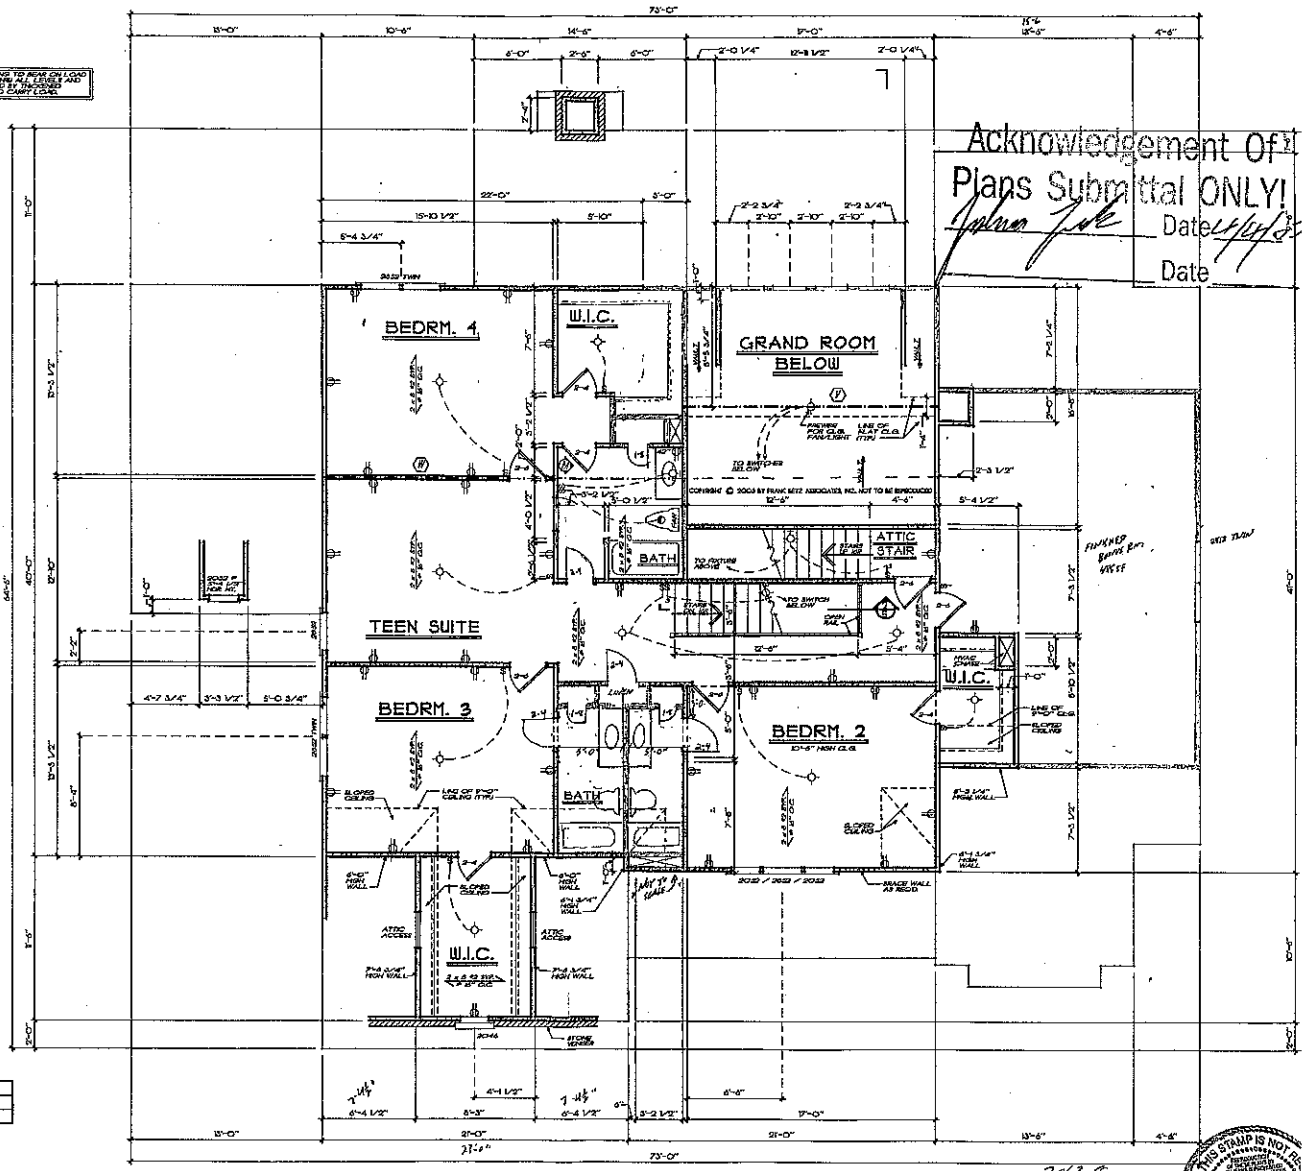

Acknowledgement Of
Plans Submittal ONLY!
Date 4/4/
Date

NOTE: ALL CEILING JOISTS AND RAFTER BRACING TO BEAR ON LOAD BEARING WALLS DESIGNED TO CARRY ALONG THEIR ALL LEVELS AND TERMINATE AT FOUNDATION AND BE SUPPORTED BY TRACTORED BEAM BRACE BEAM OR POSTING DESIGNED TO CARRY LOADS.

BEAM SCHEDULE
(V) 2 - 13-1/4" X 14" X 5'-1" LVL - ROOF BEAM
(W) 2 - 13-1/4" X 24" X 20'-1" LVL - FLUSH

2062 SF

5 SECOND FLOOR PLAN
1/4" = 1'-0"

FRANK SETZ ASSOCIATES, INC. ASSUMES NO LIABILITY FOR ANY CHANGES OR MODIFICATIONS MADE TO THESE PLANS BY OTHERS.

IF THIS STAMP IS NOT RED IT IS AN ILLEGAL SET