Site Address: 120 Polpis Dr. - Mooresville Maintenance Facility

IREDELL COUNTY HEALTH DEPARTMENT

STATESVILLE 704-878-5305 MOORESVILLE 704-664-5201

IMPROVEMENT PERMIT / AUTHORIZATION TO CONSTRUCT / OPERATION PERMIT / EXISTING SYSTEM INSPECTION

PERMIT# 072254 PIN# 4625853808 4625 85 6731 4625848012 DATE 4/21/98

OWNER OR CONTRACTOR CRESCENT RESOURCES PHONE: Business 663-6905 T JACOBS Home 85-7750

ADDRESS PO BOX 1003 CHARLOTTE NC 28202 POLPIS

LOCATION BRAWLEY SCHOOL RD - TR POSSUM KNOB ON LT AT END 120 Polpis Dr.

SUBDIVISION The Point BLOCK / SECTION 5 LOT -1- LOT AREA 6.053Ac SITE CLASS. PS DESIGN FLOW 500 GPD L.T.A.R. ~.36PD/FT~

Septic Tank: 1000 Gallons; STB 797 Date 7/14/98

Pump Tank: 1000 Gallons; PT 27 Date 4/4/98

Pump Make: MYERS Model ME50S21 Serial No.

Nitrification Field: No Fields 1 Square Feet 1350 Linear Feet 450

No Lines 5@90' Trench Width 36" Max Trench Bottom Depth 36" Gravel Depth NA

☑ New System ☐ Repair System Type: I, II, III, IV, V, VI

System Description: PUMP 25% REDUCTION

Repair System Description: SAME

Maintenance Agreement Required: ☐ Yes ☑ No

☐ House/Mod. Home No. Bedrooms

☐ Mobile Home No. Bathrooms

☐ Business No. Employees

☐ Other

☐ Slab ☐ Crawl Space ☐ Basement w/plumbing ☐ Basement wo/plumbing

Water Supply: ☐ Individual ☐ Public ☐ Community

Comments:/Conditions:

Pressure

Comments:/Conditions:

Golf Course Maintenance Facility

Now called Jump National Golf Club

INITIAL SITE SKETCH

SEE SITE PLAN

AS BUILT SKETCH

I understand that this permit can be suspended or revoked if any false information is supplied toward securing the permit/any unauthorized changes are made to the site/any unauthorized changes are made in the installation of the system. Improvement Permit with plat valid without expiration. Improvement Permit with site plan valid for sixty months. Authorization to Construct is valid for a period equal to that of Improvement Permit – not to exceed sixty months.

Signed: Terry Clontz REHS Agent date 4/21/98

Improvement Permit by: C. Ray Lewis RS date 4/21/98

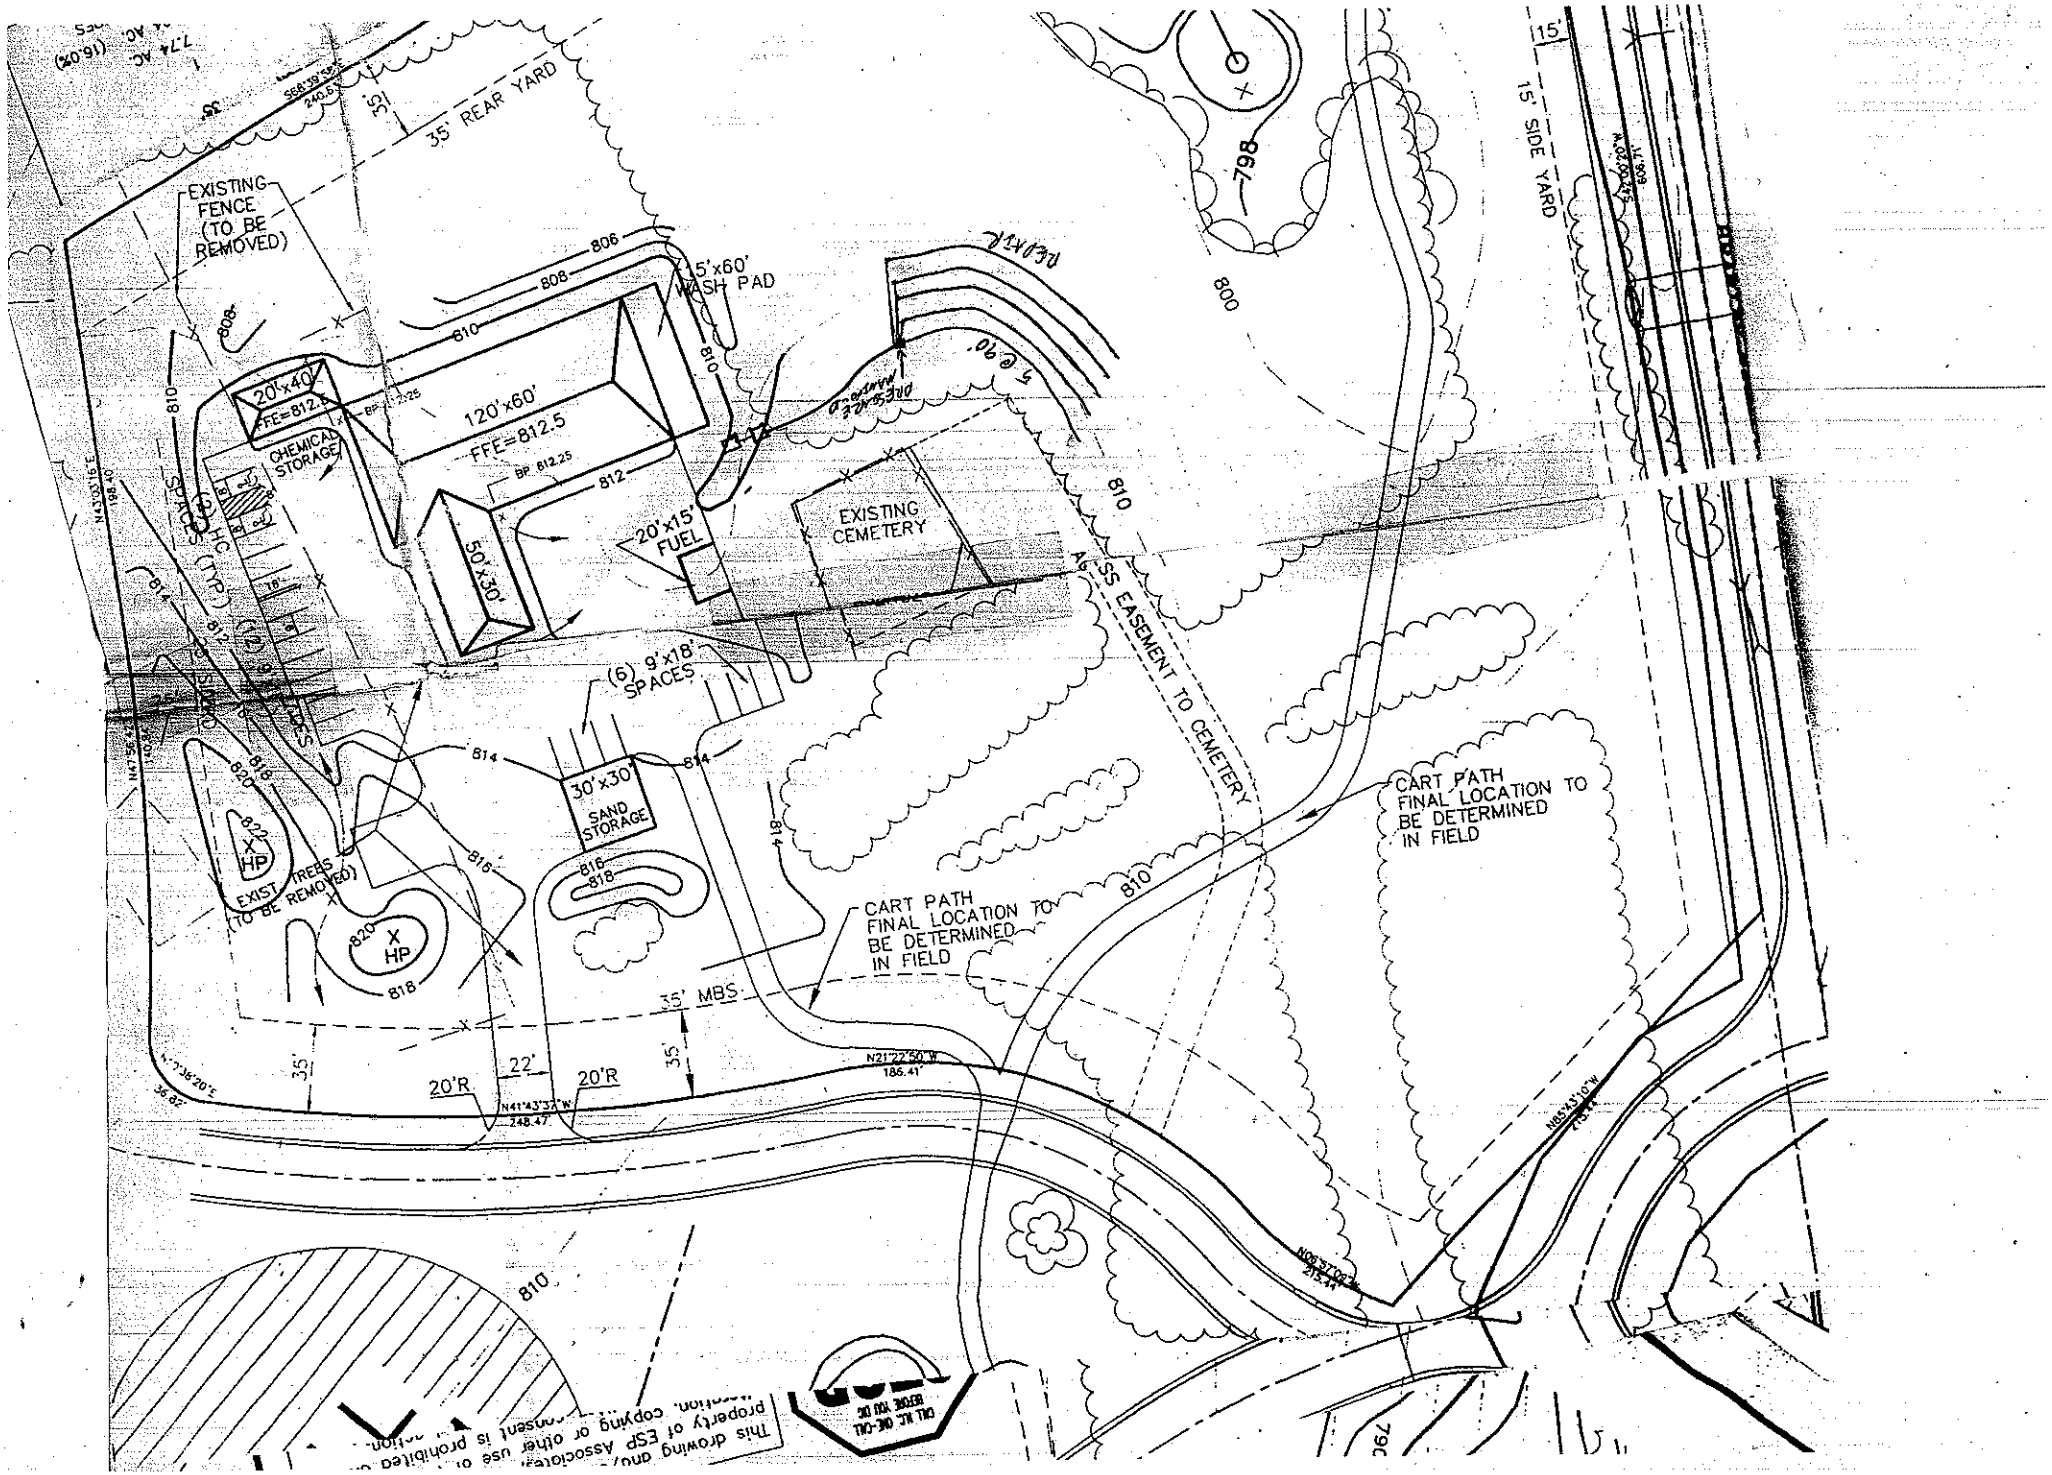
Authorization to Construct by: C. Ray Lewis RS date 4/21/98

Installed by: STANLEY SEPTIC TANKS

Operation Permit by: C. Ray Lewis RS date 8/25/98

Existing System Inspection by: date

HEALTH DEPT. COPY: WHITE INSPECTION COPY (FINAL): GREEN OWNER COPY (FINAL): YELLOW INSPECTION COPY (INITIAL): PINK OWNER COPY (INITIAL): GOLD


35' REAR YARD
15' SIDE YARD
EXISTING FENCE (TO BE REMOVED)
15'x60' WASH PAD
120'x60' FFE=812.5
20'x40' FFE=812.5
CHEMICAL STORAGE
50'x30'
20'x15' FUEL
EXISTING CEMETERY
ACCESS EASEMENT TO CEMETERY
(6) 9'x18' SPACES
30'x30' SAND STORAGE
CART PATH FINAL LOCATION TO BE DETERMINED IN FIELD
EXIST. TREES (TO BE REMOVED)
35' MBS
20'R
22'
20'R
798
800
810
812
814
816
818
820