IREDELL COUNTY HEALTH DEPARTMENT

STATESVILLE 704-878-5305 MOORESVILLE 704-664-5281

IMPROVEMENT PERMIT / AUTHORIZATION TO CONSTRUCT / OPERATION PERMIT / EXISTING SYSTEM INSPECTION

$125

PERMIT# 081170 PIN# 4625447687 (pt) 4625857936 DATE August 3, '99

OWNER OR CONTRACTOR Crescent Resources Lucy II The Point on Norman PHONE: Business Home

ADDRESS 2214 Brawley Sch Rd. Mooresville

LOCATION Brawley Sch Rd. TR Polger Road on Right past Golf Course Maintenance Facility

SUBDIVISION The Point BLOCK / SECTION 5 LOT 506 LOT AREA 36,297 sf SITE CLASS PS DESIGN FLOW 460 gpd L.T.A.R. .03

Septic Tank: 1500 Gallons; STB 338 Date 11/9/00

Pump Tank: 1000 Gallons; PT 27 Date 12/9/00

Pump Make: Zoeller Model WE0312M Serial No.

Nitrification Field: No Fields 1 Square Feet 1200 Linear Feet 400

No Lines 4@100 Trench Width 36" Max Trench Bottom Depth 36"

☑ New System ☐ Repair System Type; I, II, III, IV, V, VI

System Description: PM-Innovative-25% Reduction

Repair System Description: LP-Innovative

Maintenance Agreement Required: ☐ Yes ☑ No

Gravel Depth NA

☑ House/Mod. Home ☐ Mobile Home ☐ Business ☐ Other

No. Bedrooms 4 No. Bathrooms 4 No. Employees

☑ Slab ☑ Crawl Space ☑ Basement w/plumbing ☐ Basement wo/plumbing


Water Supply: ☐ Individual ☑ Public ☑ Community

Comments:/Conditions: * ONE INSPECTION PORT PER LATERAL.
8/2/00 - Reviewed, meets Permit requirements.


Comments:/Conditions: (PARTIAL)
Drawfield, Tanks, Pressure

1" = 50'

INITIAL SITE SKETCH

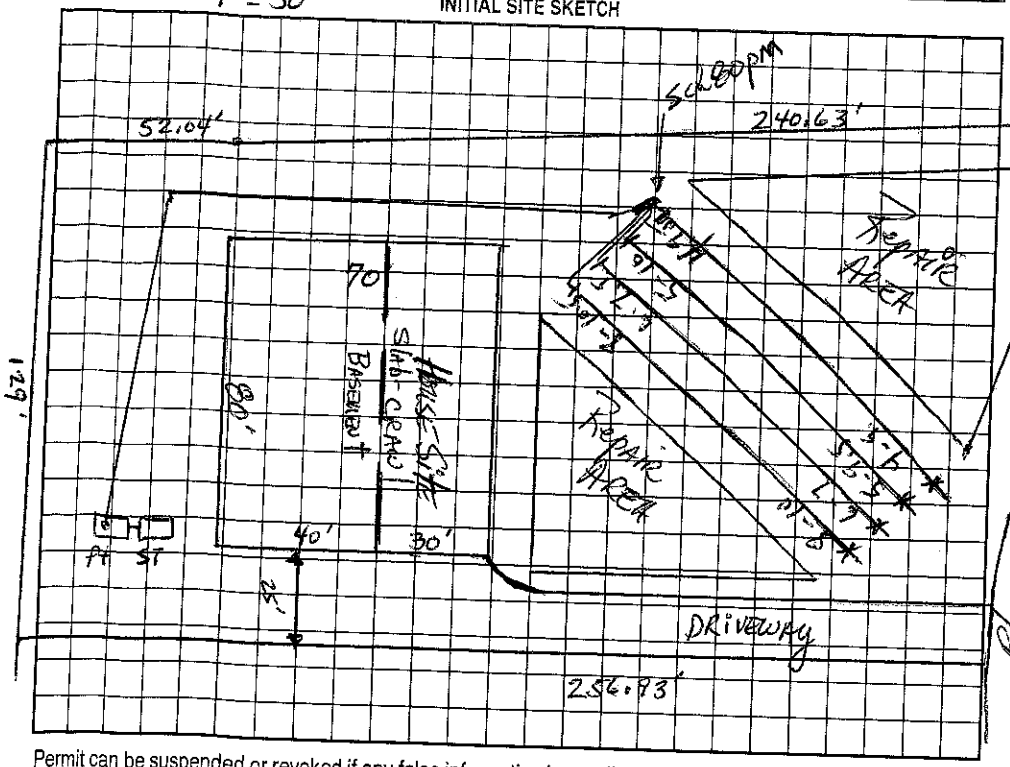

AS BUILT SKETCH

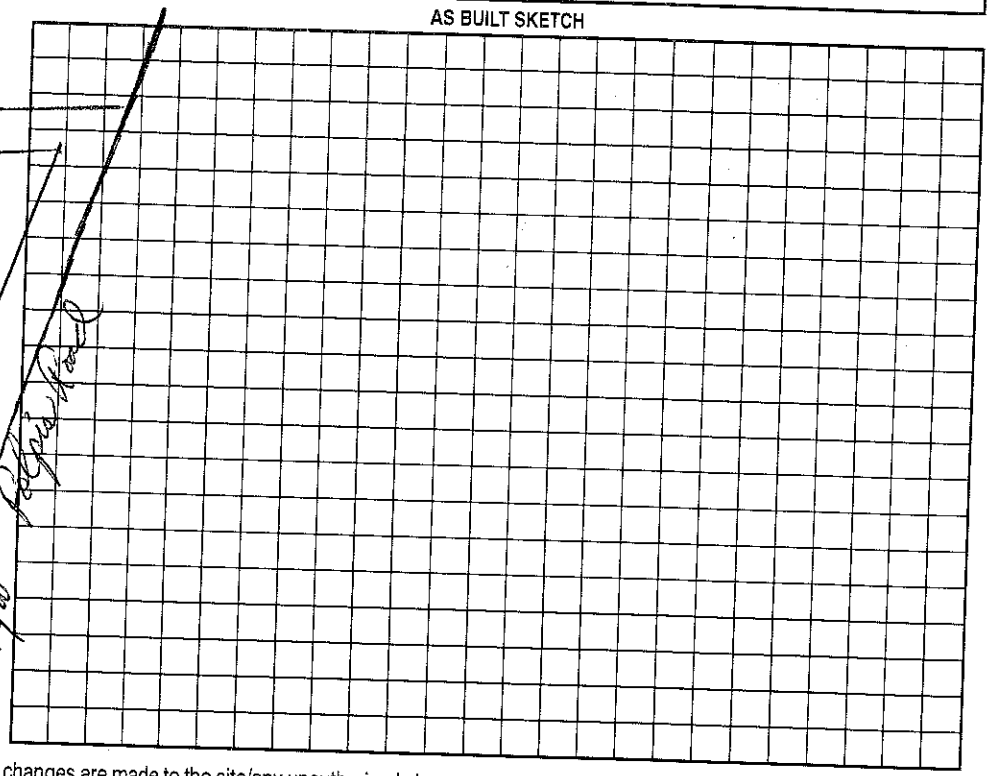

Permit can be suspended or revoked if any false information is supplied toward securing the permit/any unauthorized changes are made to the site/any unauthorized changes are made in the installation of the system. Improvement Permit with ~~plat~~ valid without expiration. Improvement Permit with site plan valid for sixty months. Authorization to Construct is valid for a period equal to that of Improvement Permit – not to exceed sixty months.

Signed:

Improvement Permit by: date 9-10-99

Authorization to Construct by: Wesley Spencer R.S. date 8/2/00

Installed by: Brawley Septic Svcs.

Operation Permit by: R.S. date 3/6/01

Existing System Inspection by: date

HEALTH DEPT. COPY: WHITE OWNER COPY (FINAL): YELLOW OWNER COPY (INITIAL): PINK