Brawley School Rd @ circle Lot 134 The Point Sales office

IREDELL COUNTY HEALTH DEPARTMENT

STATESVILLE 704-878-5305 MOORESVILLE 704-664-5281

IMPROVEMENT PERMIT / AUTHORIZATION TO CONSTRUCT / OPERATION PERMIT / EXISTING SYSTEM INSPECTION

PERMIT# 071261 PIN# 4625941684 4625859132 DATE 4/9/98

OWNER OR CONTRACTOR CRESCENT RESOURCES PHONE: Business 663-6905 T JACOBS Home

ADDRESS PO BOX 1003 CHARLOTTE NC 28201

LOCATION BRAWLEY SCHOOL - AT CORNER OF GARDEN RD

SUBDIVISION BLOCK / SECTION LOT LOT AREA SITE CLASS. PS DESIGN FLOW 480 GPD L.T.A.R. .30 GPD/FT

Septic Tank: ~~1000~~ 1500 Gallons; STB 797 Date 9/11/98

Pump Tank: 1000 Gallons; PT 27 Date 9/20/98

Pump Make: MYERS Model ME-3F Serial No. 2198

Nitrification Field: No Fields 1 Square Feet 1200 Linear Feet 400

No Lines 5 Trench Width 36" Max Trench Bottom Depth 36" Gravel Depth N/A

☑ New System ☐ Repair System Type: I, II, III, IV, V, VI

System Description: PUMP CHAMBERS OR HDS

Repair System Description: PANEL

Maintenance Agreement Required: ☐ Yes ☑ No

☑ House/Mod. Home No. Bedrooms 4

☐ Mobile Home No. Bathrooms 4

☑ Business No. Employees 19

☑ Other SIZED FOR 19 EMPLOYEES

☐ Slab ☑ Crawl Space ☐ Basement w/plumbing ☐ Basement wo/plumbing


Water Supply: ☐ Individual ☐ Public ☑ Community

Comments:/Conditions:

1" = 60'

PRESSURE MANIFOLD (4 TAPS)

INITIAL SITE SKETCH

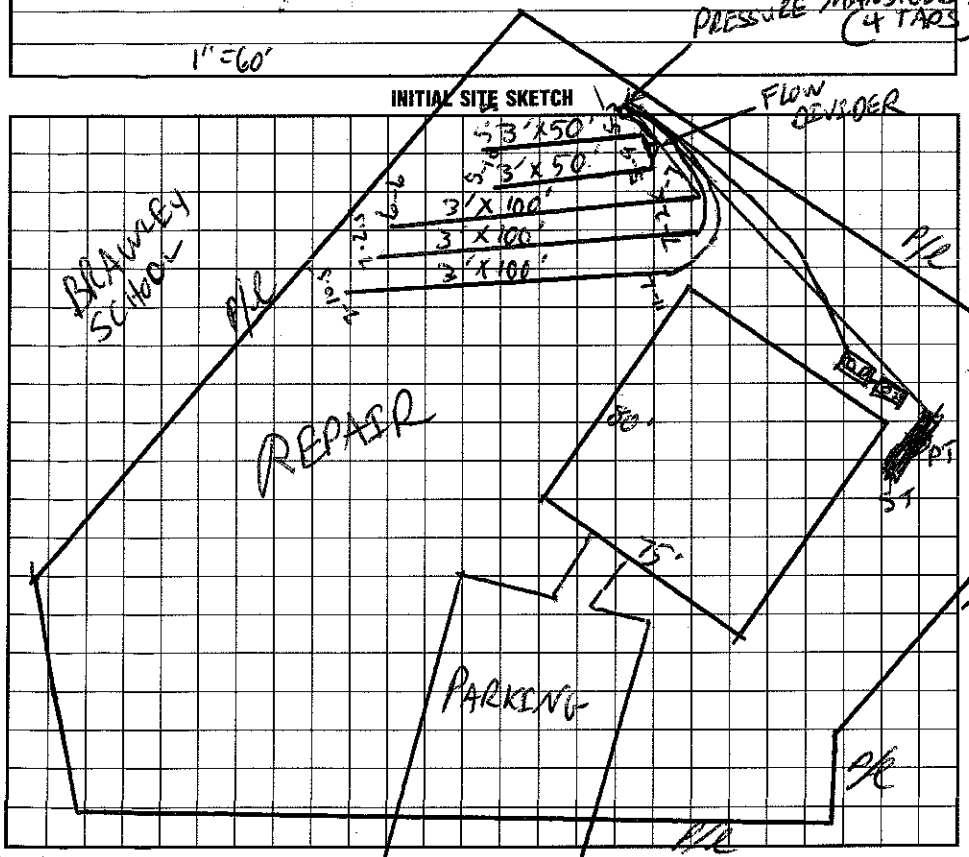

Comments:/Conditions: 240

5" Teflon .44 - 110 g/a.

AS BUILT SKETCH

I understand that this permit can be suspended or revoked if any false information is supplied toward securing the permit/any unauthorized changes are made to the site/any unauthorized changes are made in the installation of the system. Improvement Permit with plat valid without expiration. Improvement Permit with site plan valid for sixty months. Authorization to Construct is valid for a period equal to that of Improvement Permit – not to exceed sixty months.

Signed: Tony Jacobs, CPSS (Agent) date 4/14/98

Improvement Permit by: date 4/9/98

Authorization to Construct by: date 4/9/98

Installed by: Chris Hedrick

Operation Permit by: Wesley Sparks RS. date 3/11/99

Existing System Inspection by: date

HEALTH DEPT. COPY: WHITE INSPECTION COPY (FINAL): GREEN OWNER COPY (FINAL): YELLOW INSPECTION COPY (INITIAL): PINK OWNER COPY (INITIAL): GOLD