As Built

IREDELL COUNTY HEALTH DEPARTMENT

STATESVILLE 704-878-5305 MOORESVILLE 704-664-5281

IMPROVEMENT PERMIT / AUTHORIZATION TO CONSTRUCT / OPERATION PERMIT / EXISTING SYSTEM INSPECTION

PERMIT# 132047 PIN# 4625860097 DATE 3-12-07

OWNER OR APPLICANT Kingswood Custom Homes PHONE: Business 309-4575 Home

ADDRESS

LOCATION

SUBDIVISION Point BLOCK / SECTION 5 LOT 518 LOT AREA .85 Acre SITE CLASS. PS DESIGN FLOW 480 L.T.A.R. .25

Septic Tank: 1500 Gallons; STB 338 Date 11-23-06
Pump Tank: 1000 Gallons; PT 27 Date 12-8-06
Pump Make Goulds Model WE0512HHLS Serial No.
Nitrification Field: No Fields 1 Square Feet 960 Linear Feet 320'
No Lines 4@80' Trench Width 36" Max Trench Bottom Depth 36"

☒ New System ☐ Repair ☐ Expansion System Type: I II III (IV) V VI
System Description: LP-Panel Blk
Repair System Description: Same
Maintenance Agreement Required: ☒ Yes ☐ No

☒ House/Mod. Home ☐ Mobile Home ☐ Business ☐ Other
No. Bedrooms 4 No. Persons No. Employees

Water Supply: ☒ Individual ☐ Public ☐ Community


Gravel Depth N/A ☐ Gravity ☒ Pressure ☐ Slab ☐ Crawl Space ☐ Basement w/plumbing ☐ Basement wo/plumbing

Comments:/Conditions: PL 175


Comments:/Conditions:

* Not to Scale

INITIAL SITE SKETCH

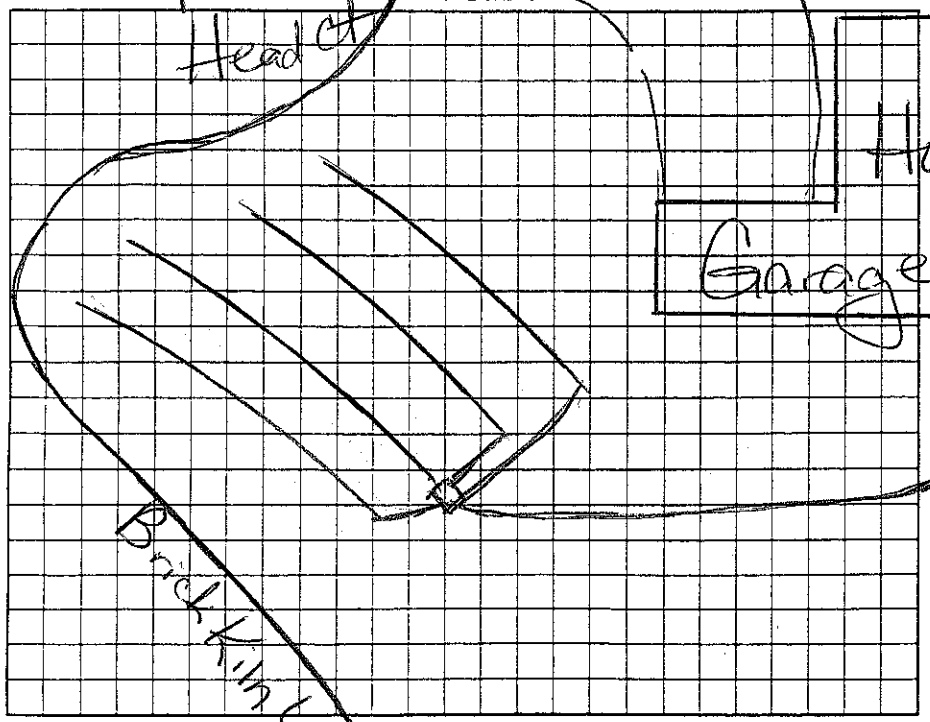

AS BUILT SKETCH

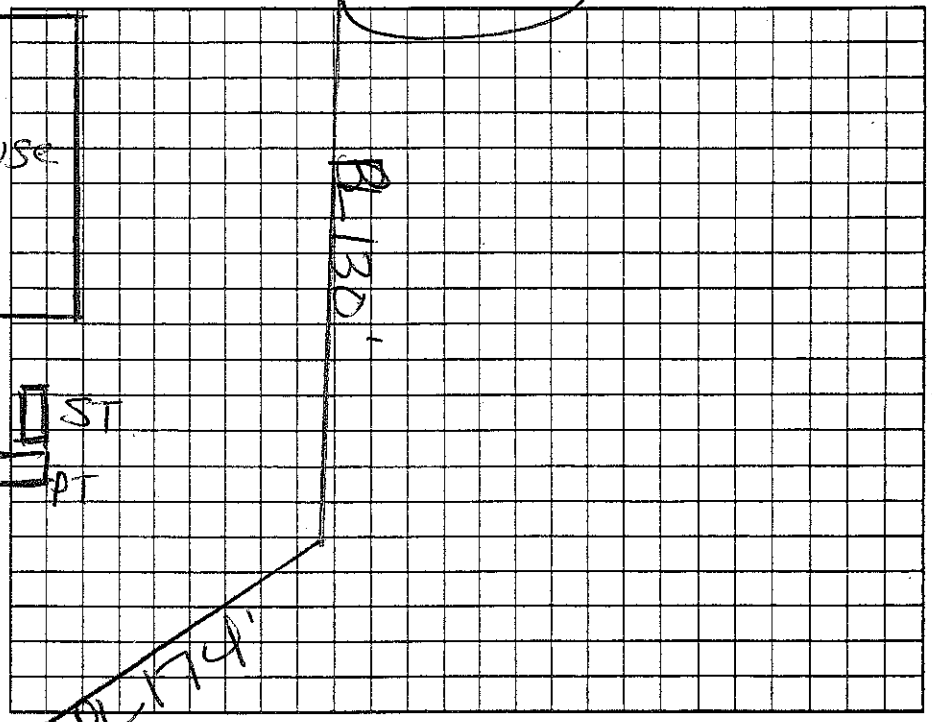

Permit can be suspended or revoked if any false information is supplied toward securing the permit/any unauthorized changes are made to the site/any unauthorized changes are made in the installation of the system. Improvement Permit with plat valid without expiration ☐ Improvement Permit with site plan valid for sixty months ☐ Authorization to Construct is valid for a period equal to that of Improvement Permit – not to exceed sixty months.

Signed: date 3-12-07 Installed by: Kevin Hallman

Improvement Permit by: date Operation Permit by: date

Authorization to Construct by: date Existing System Inspection by: date

HEALTH DEPT. COPY: WHITE OWNER COPY (FINAL): YELLOW OWNER COPY (INITIAL): PINK