3:30

COPY

IREDELL COUNTY HEALTH DEPARTMENT

STATESVILLE 704-878-5305 MOORESVILLE 704-664-5281

IMPROVEMENT PERMIT / AUTHORIZATION TO CONSTRUCT / OPERATION PERMIT / EXISTING SYSTEM INSPECTION

PERMIT# 081250 PIN# 4625941684 (pt) LAKE NORMAN Signature Homes 4625-86-0249 DATE Sept 15, 99

OWNER OR CONTRACTOR Crescent Resources Inc // The Point at Norman // PHONE: Business 660-1185 Home

ADDRESS 2214 Brawley Sch Rd. Mooresville

LOCATION Brawley Sch Rd. TR Polpis TL Jeromy Pt (SFE immediately on Right) TR Brick Kiln TR Masthead

SUBDIVISION The Point BLOCK / SECTION 5 LOT 519/519A LOT AREA 35,172 sf + SFE 519A SITE CLASS. PS DESIGN FLOW 480 gpd L.T.A.R. .025 - SFE 519A

Septic Tank: 1500+ Gallons; STB 338 Date 7/6/01

Pump Tank: 1000 Gallons; PT 27 Date 3/3/01

Pump Make: GOULDS Model WE0 1012 HC Serial No. G0141188

Nitrification Field: No Fields 1 Square Feet 1350 Linear Feet 450

No Lines 5 @ 90' Trench Width 36" Trench Bottom Depth 36"

☑ New System ☐ Repair System Type: I, II, III, IV, V, VI

System Description: Am - INNOVATIVE - 25% Reduction

Repair System Description: SAME ONSITE 519A

Maintenance Agreement Required: ☐ Yes ☑ No

Gravel Depth NA

☑ House/Mod. Home ☐ Mobile Home ☐ Business ☐ Other

No. Bedrooms 4 No. Bathrooms 4 No. Employees

☐ Slab ☐ Crawl Space ☑ Basement w/plumbing ☐ Basement wo/plumbing


Water Supply: ☐ Individual ☑ Public ☑ Community

Comments:/Conditions:

ONE inspection port PER LATERAL


1-11-01 Reviewed house plan; appears in compliance w/ I.P.

INITIAL SITE SKETCH

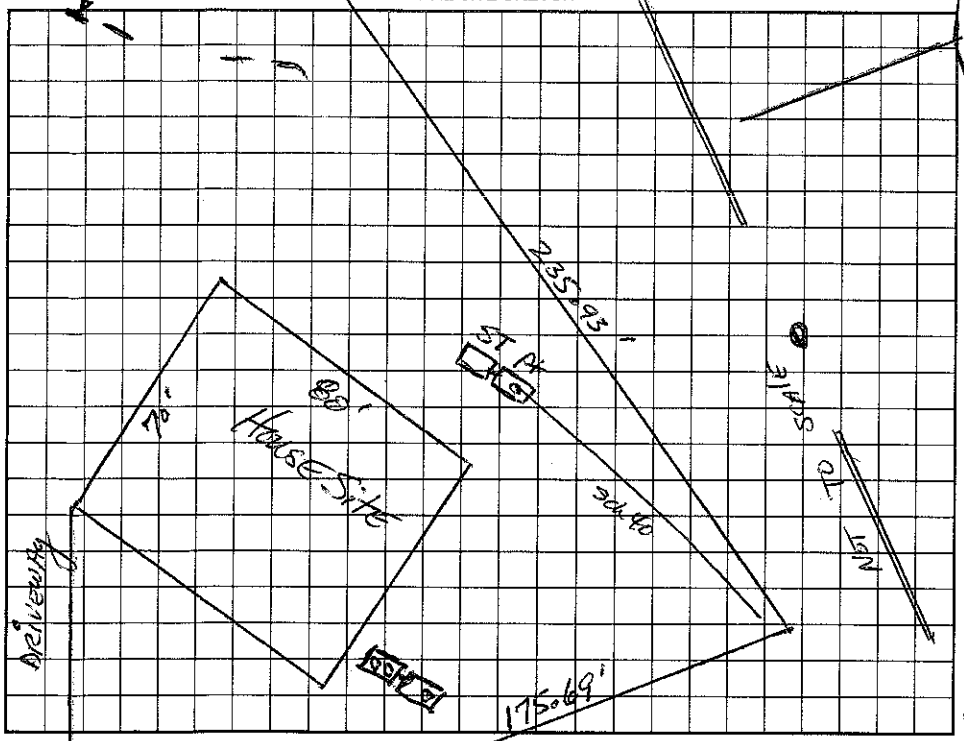

Comments:/Conditions:

AS BUILT SKETCH

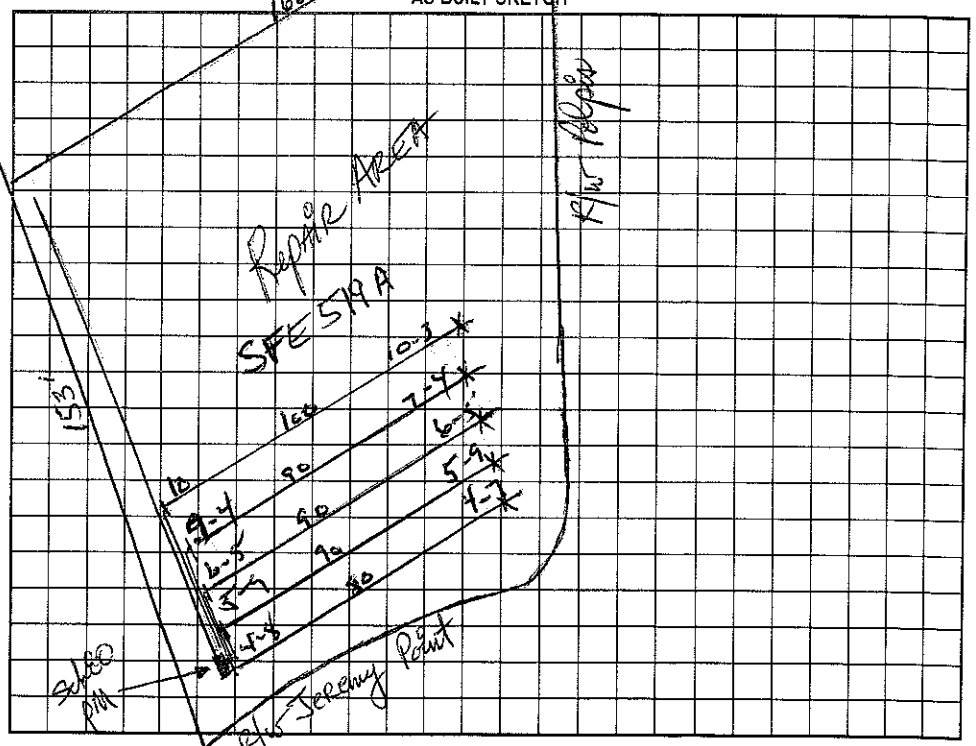

Permit can be suspended or revoked if any false information is supplied toward securing the permit/any unauthorized changes are made to the site/any unauthorized changes are made in the installation of the system. Improvement Permit with plat valid without expiration. Improvement Permit with site plan valid for sixty months. Authorization to Construct is valid for a period equal to that of Improvement Permit – not to exceed sixty months.

Signed: date 9-17-99 Installed by: Hallmark Grading

Improvement Permit by: Mary R. Hinson, RS date 9-15-99 Operation Permit by: R.A. Ellis REHS date 5-16-01

Authorization to Construct by: M R Hinson, RS date 1-11-01 Existing System Inspection by: date

HEALTH DEPT. COPY: WHITE OWNER COPY (FINAL): YELLOW OWNER COPY (INITIAL): PINK