IREDELL COUNTY HEALTH DEPARTMENT

STATESVILLE 704-878-5305 MOORESVILLE 704-664-5281

IMPROVEMENT PERMIT / AUTHORIZATION TO CONSTRUCT / OPERATION PERMIT / EXISTING SYSTEM INSPECTION

$450 2:30-3:00

PERMIT# 08171 (115103) PIN# 4625-94-6847 4625-86-7097 DATE 7/28/03

OWNER OR CONTRACTOR Simmons Builders PHONE: Business 704-358-9940 Home

ADDRESS 817 E. Morehead Charlotte NC 28202

LOCATION BSR, [redacted] Rt, Polpis, on Rt past Maintenance Shed

SUBDIVISION Point BLOCK / SECTION 5 LOT 507 LOT AREA 36,679 Ft² SITE CLASS. PS DESIGN FLOW 600 L.T.A.R. 0.3

Septic Tank: 1500 Gallons; STB 338 Date 2-1-04

Pump Tank: 1500 Gallons; PT 421 Date 4-13-04

Pump Make: Model Serial No.

Nitrification Field: No Fields 1 Square Feet 990 Linear Feet 330

No Lines 4 Trench Width 24-36" Max Trench Bottom Depth 36" Gravel Depth —

☒ New System ☐ Repair System Type: I, II, III, (IV) V, VI

System Description: LP Panel Block

Repair System Description: Same

Maintenance Agreement Required: ☒ Yes ☐ No

☒ House/Mod. Home No. Bedrooms 5

☐ Mobile Home No. Bathrooms 5

☐ Business No. Employees

☐ Other


☐ Slab ☐ Crawl Space ☒ Basement w/plumbing ☐ Basement wo/plumbing

Water Supply: ☐ Individual ☐ Public ☒ Community


Comments:/Conditions:

Comments:/Conditions: Lines checked by GM
Tanks checked by MD
Pres, test & alarm MD 6/23/04

INITIAL SITE SKETCH

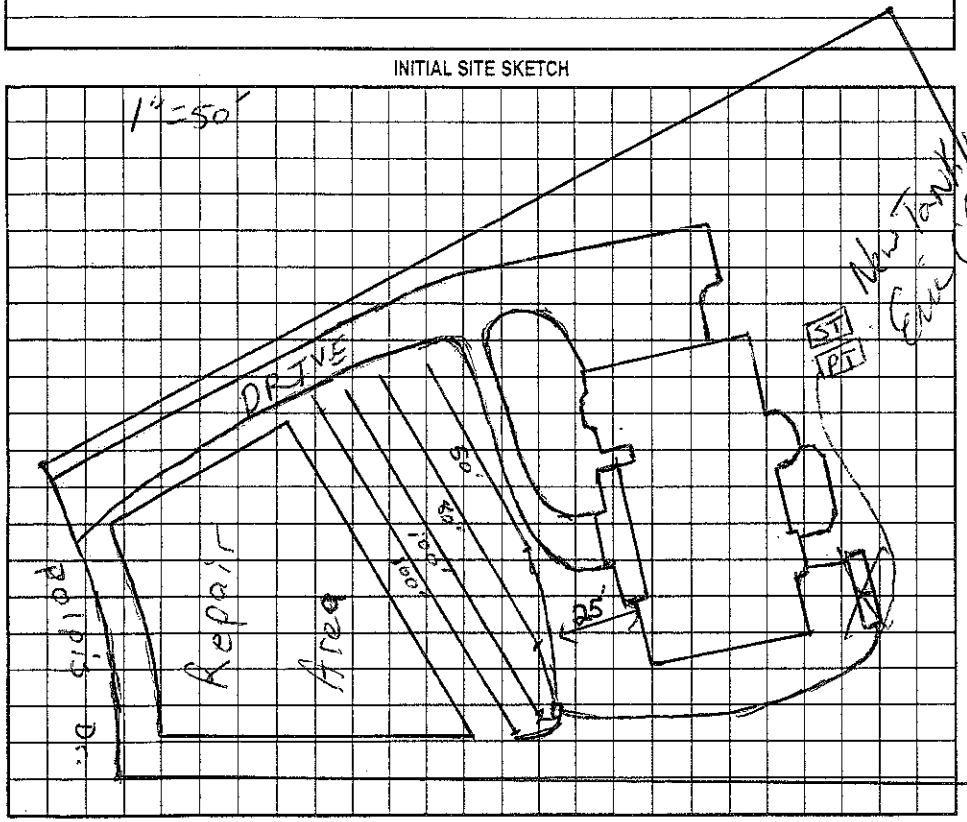

AS BUILT SKETCH

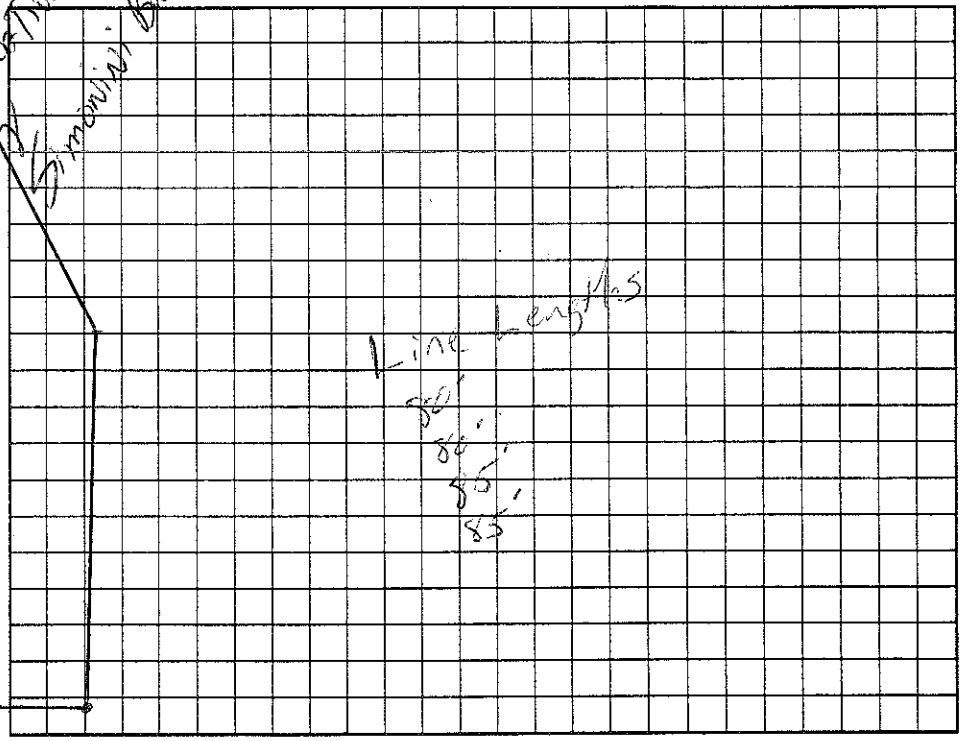

Permit can be suspended or revoked if any false information is supplied toward securing the permit/any unauthorized changes are made to the site/any unauthorized changes are made in the installation of the system. Improvement Permit with plat valid without expiration. Improvement Permit with site plan valid for sixty months. Authorization to Construct is valid for a period equal to that of Improvement Permit – not to exceed sixty months.

Signed: [signature] date 7/31/03

Improvement Permit by: [signature] RS date 7/28/03

Authorization to Construct by: [signature] RS date 7/28/03

Installed by: R+H RS

Operation Permit by: [signature] date 6/23/04

Existing System Inspection by: date

HEALTH DEPT. COPY: WHITE OWNER COPY (FINAL): YELLOW OWNER COPY (INITIAL): PINK