IREDELL COUNTY HEALTH DEPARTMENT

STATESVILLE 704-878-5305 #325 MOORESVILLE 704-664-5281

ORRISON 1'00-

IMPROVEMENT PERMIT / AUTHORIZATION TO CONSTRUCT / OPERATION PERMIT / EXISTING SYSTEM INSPECTION

PERMIT# 08173 PIN# 4625947684 (pt) 4625-86-7337 DATE June 21, 99

OWNER OR CONTRACTOR Crescent Resources LLC / The Preston Norman PHONE: Business 660-1165 Home

ADDRESS 2214 Brawley Sch Rd Mooresville

LOCATION Brawley Sch Rd IR Polaris Rd on Right

SUBDIVISION The Point BLOCK / SECTION 5 LOT 509 LOT AREA 35,756 SITE CLASS RS DESIGN FLOW 480gpd L.T.A.R. .25-.3

Septic Tank: 1000+ Gallons; STB 328 Date 4/4/01

Pump Tank: 1000 Gallons; PT 27 Date 3/6/01

Pump Make: Gowlds Model WE0-5121 Pump No. 6015836

Nitrification Field: No Fields 1 Square Feet 900 Linear Feet 300

No Lines 4 & 5 Trench Width 36" Max Trench Bottom Depth 36" Gravel Depth N/A

☑ New System ☐ Repair System Type: I, II, III, IV, V, VI

System Description: LP Panel Block

Repair System Description: Same

Maintenance Agreement Required: ☑ Yes ☐ No

☑ House/Mod. Home No. Bedrooms 4

☐ Mobile Home No. Bathrooms 4

☐ Business No. Employees

☐ Other

☑ Slab ☑ Crawl Space ☑ Basement w/plumbing ☐ Basement wo/plumbing

Water Supply: ☐ Individual ☑ Public ☐ Community


Comments:/Conditions: Remove any old terraces.

4-2001 Reviewed floor plan - appears substantially in compliance w/ IP. House to be adjusted on submitted site plan 3' towards Lake. OK to set Tanks on Right Side


Comments:/Conditions: (PARTIAL)

Tanks, lines & pressure checked by WS

INITIAL SITE SKETCH

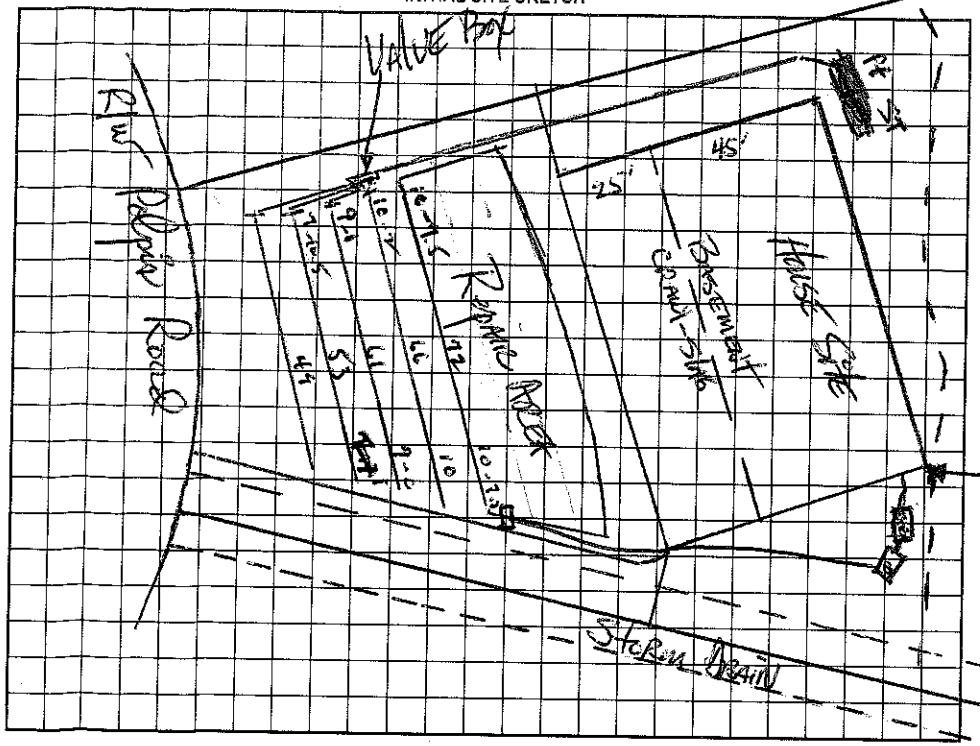

AS BUILT SKETCH

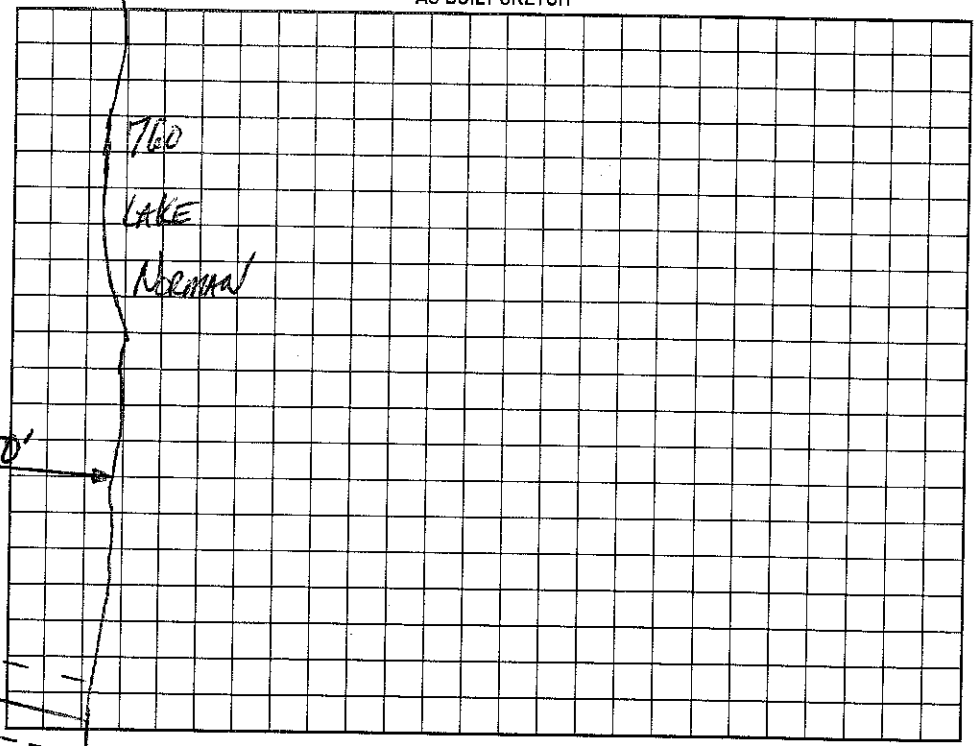

Permit can be suspended or revoked if any false information is supplied toward securing the permit/any unauthorized changes are made to the site/any unauthorized changes are made in the installation of the system. Improvement Permit with plat valid without expiration. Improvement Permit with site plan valid for sixty months. Authorization to Construct is valid for a period equal to that of Improvement Permit – not to exceed sixty months.

Signed: [signature] date 9-10-99

Improvement Permit by: [signature], RS date 6-21-99

Authorization to Construct by: [signature], RS date 4-20-01

Installed by: Orrison Const. Co. RS

Operation Permit by: [signature] date 7/25/2002

Existing System Inspection by: date

HEALTH DEPT. COPY: WHITE OWNER COPY (FINAL): YELLOW OWNER COPY (INITIAL): PINK