# IREDELL COUNTY HEALTH DEPARTMENT

STATESVILLE 704-878-5305 MOORESVILLE 704-664-5281

## IMPROVEMENT PERMIT / AUTHORIZATION TO CONSTRUCT / OPERATION PERMIT / EXISTING SYSTEM INSPECTION

PERMIT# 12E384 PIN# 4625 86 8707.000 DATE 4/27/05

OWNER OR CONTRACTOR Arcadia Homes - Dammick PHONE: Business 704-201-7181 Home

ADDRESS PO Box 471941 Charlotte NC 28247

LOCATION 1100 R Marston Mill L White Horse L Buckingstone L Brownstone cul-de-sac (R)

SUBDIVISION Point BLOCK / SECTION 4 LOT 460 LOT AREA 38038 SITE CLASS. PS DESIGN FLOW 600 L.T.A.R. .3

Septic Tank: 1500 Gallons; STB 338 Date 2/16/05

Pump Tank: 1000 Gallons; PT 283 Date 9/30/05

Pump Make: MYERS Model ME-5E Serial No.

Nitrification Field: No Fields 1 Square Feet 1500 Linear Feet 500

No Lines 5@100' Trench Width 3' Max Trench Bottom Depth 3' Gravel Depth N/A

[X] New System [ ] Repair System Type: I, II, III, IV, V, VI

System Description: PM → 2590 Reduced

Repair System Description: Pressure 16" PPBPS

Maintenance Agreement Required: [ ] Yes [X] No

[X] House/Mod. Home No. Bedrooms 5

[ ] Mobile Home No. Bathrooms 5

[ ] Business No. Employees

[ ] Other

[ ] Slab [ ] Crawl Space [X] Basement w/plumbing [ ] Basement wo/plumbing


Water Supply: [ ] Individual [ ] Public [X] Community POINT

Comments:/Conditions: Drainfield must be verified by installer installed previously on wrong Easement area


Comments:/Conditions:

(1" = 50')

INITIAL SITE SKETCH

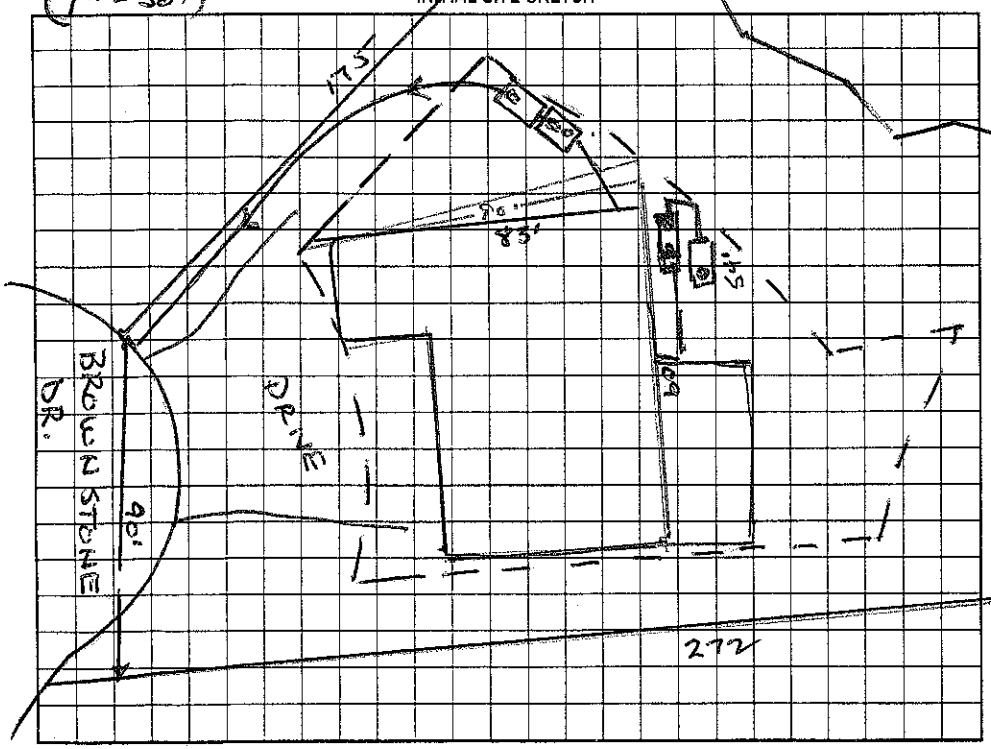


AS BUILT SKETCH

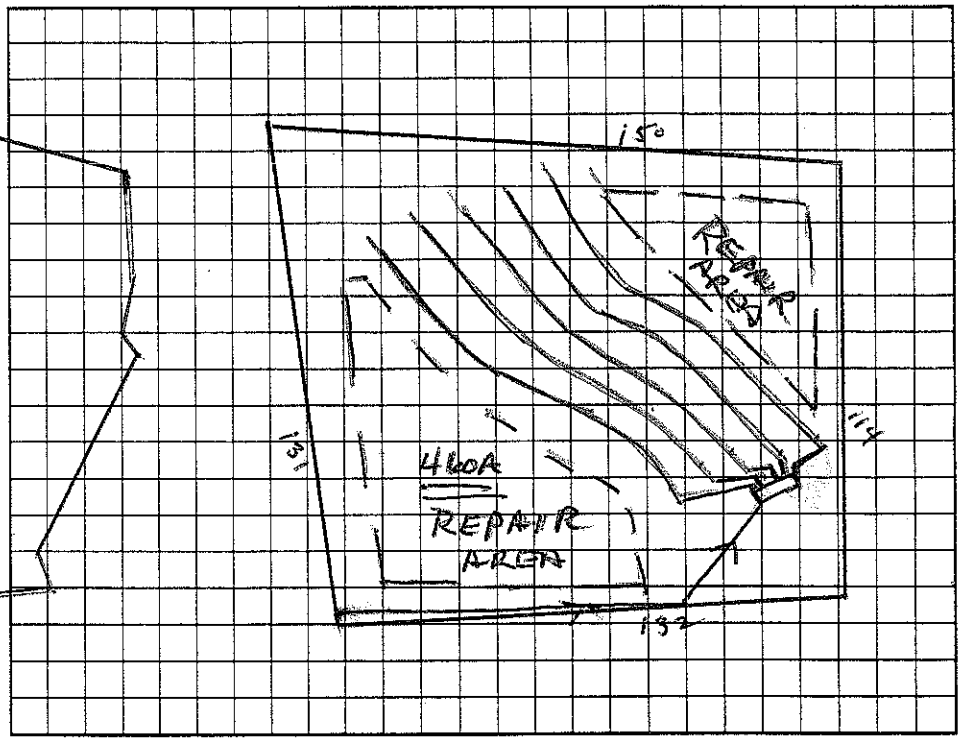


Permit can be suspended or revoked if any false information is supplied toward securing the permit/any unauthorized changes are made to the site/any unauthorized changes are made in the installation of the system. Improvement Permit with plat valid without expiration. Improvement Permit with site plan valid for sixty months. Authorization to Construct is valid for a period equal to that of Improvement Permit – not to exceed sixty months.

Signed: [signature] date 4/29/05 Installed by: R+N

Improvement Permit by: Wesley Sparks R.S. date 4/27/05 Operation Permit by: Wesley Sparks R.S. date 5/12/05

Authorization to Construct by: Wesley Sparks R.S. date 4/27/05 Existing System Inspection by: date

HEALTH DEPT. COPY: WHITE OWNER COPY (FINAL): YELLOW OWNER COPY (INITIAL): PINK