IREDELL COUNTY HEALTH DEPARTMENT

STATESVILLE 704-878-5305 MOORESVILLE 704-664-5281

IMPROVEMENT PERMIT / AUTHORIZATION TO CONSTRUCT / OPERATION PERMIT / EXISTING SYSTEM INSPECTION

DATE 7/20/07

PERMIT# 142314 PIN# 4625 87 2067

OWNER OR APPLICANT Amonini Bldrs. PHONE: Business 704-358-9940 Home

ADDRESS 1900 South Blvd. St. 200 Charlotte, NC. 28203

LOCATION 124 Brownstone Dr. Mooresville, NC. 28117

SUBDIVISION Point BLOCK / SECTION 4 LOT 450 LOT AREA 53676 Ft² SITE CLASS. PS DESIGN FLOW 600 L.T.A.R. .3

Septic Tank: 1500 Gallons; STB 379 Date 03/15/08

Pump Tank: 1500 Gallons; PT 379 Date 3/1/08

Pump Make: Myers Model ME 585-50 Serial No. 0668

Nitrification Field: No Fields 1 Square Feet 1005 Linear Feet 335

No Lines 5@67' Trench Width 3' Max Trench Bottom Depth 3' Gravel Depth NA

☒ New System ☐ Repair ☐ Expansion System Type: I II III (IV) V VI

System Description: Pressure - 16" PPBDS

Repair System Description: SAME TYPE

Maintenance Agreement Required: ☒ Yes ☐ No

☒ House/Mod. Home ☐ Mobile Home ☐ Business ☐ Other

No. Bedrooms 5 No. Persons No. Employees


Water Supply: ☐ Individual ☐ Public ☒ Community

☐ Gravity ☐ Pressure ☐ Slab ☐ Crawl Space ☒ Basement w/plumbing ☐ Basement wo/plumbing


Comments:/Conditions: Remove elbows and bends from this site.

Comments:/Conditions: Okay to move tanks MK
Check lead tanks & lines 5/7/08 RM

INITIAL SITE SKETCH (1" = 50')

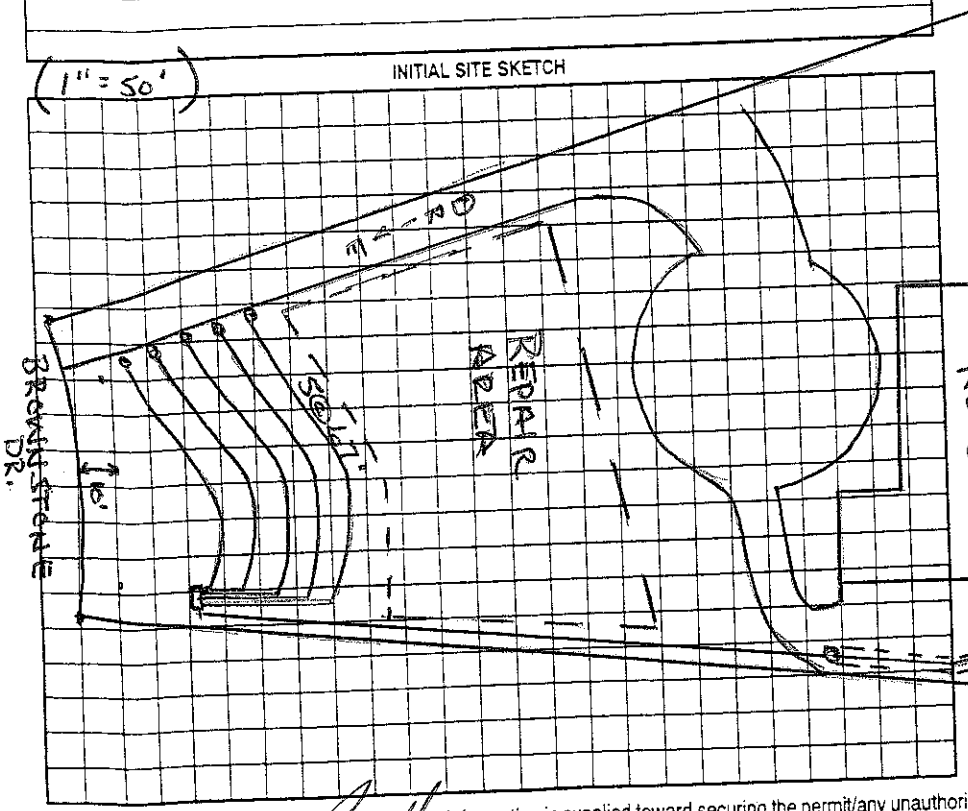

AS BUILT SKETCH

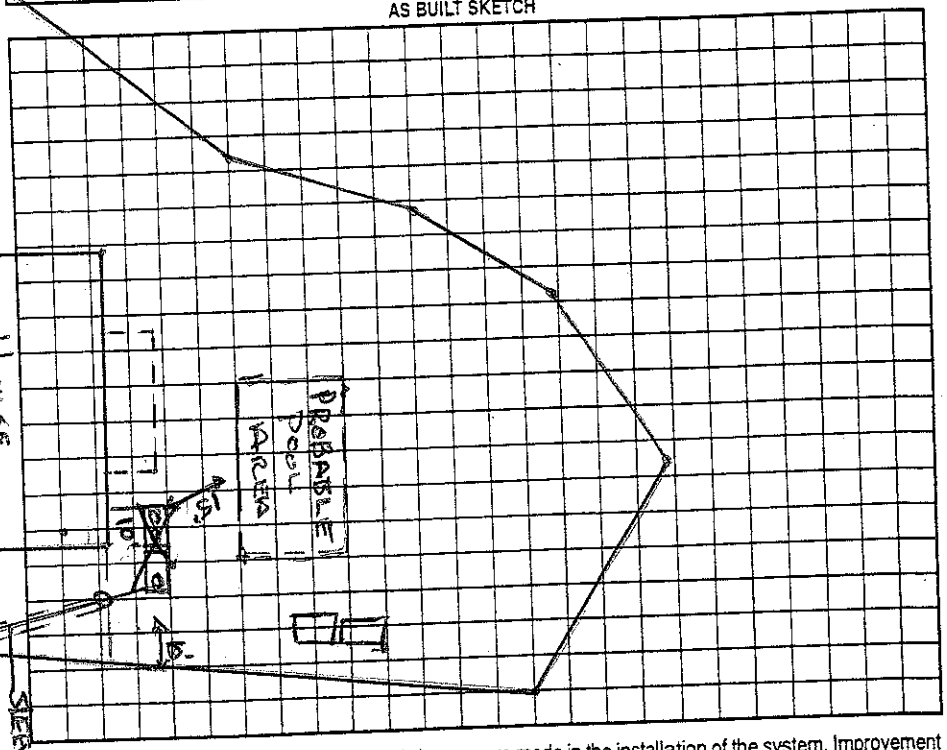

Permit can be suspended or revoked if any false information is supplied toward securing the permit/any unauthorized changes are made to the site/any unauthorized changes are made in the installation of the system. Improvement Authorization to Construct is valid for a period equal to that of Improvement Permit – not to exceed sixty months.

Permit with plat valid without expiration ☐ Improvement Permit with site plan valid for sixty months ☐

Signed: ☒ date 8/8/07

Improvement Permit by: Wesley Sparks RS. date 7/20/07

Authorization to Construct by: Wesley Sparks RS. date 7/20/07

Installed by: date

Operation Permit by: date 7/1/08

Existing System Inspection by: date

HEALTH DEPT. COPY: WHITE OWNER COPY (FINAL): YELLOW OWNER COPY (INITIAL): PINK