Expansion

IREDELL COUNTY HEALTH DEPARTMENT - *ENVIRONMENTAL HEALTH* ☐ STATESVILLE OFFICE 704-878-5305 ☐ MOORESVILLE OFFICE 704-664-5281

IMPROVEMENT PERMIT / AUTHORIZATION TO CONSTRUCT / OPERATION PERMIT / EXISTING SYSTEM INSPECTION

PERMIT # _____ PIN # 4625873251 DATE 4/4/2012

OWNER Andy Trott APPLICANT: Michael Athanas PHONE: Home/Cell # Mike 704576-3887 Business # A. Trott 704799-9645

SITE ADDRESS 128 Brownstone M'Ville OWNER / APPLICANT ADDRESS _____

SITE DIRECTIONS Brawley School Rd TR Marstons Mill TL Whitehorse TL Ballston TR Brownstone on left

SUBDIVISION The Point BLOCK / SECTION 4 LOT # 451 LOT AREA _____ DESIGN FLOW 600gpd L.T.A.R. .3

Ex Septic Tank 1500 Gallons: STB _____ Date _____

Pump Tank ~~1000~~ Gallons: P T _____ Date _____

Pump Make _____ Model _____ Serial # _____

No. Nitrification Fields: 1 No. Lines 1 Linear Feet 35

add Trench Width min 24" Max. Trench Bottom Depth 36" Gravel Depth N/A

☐ New System ☐ Repair ☐ Expansion System Type I II III (IV) V VI

System Description: Pump-Up Panel Block

Repair System Description: Same

Maintenance Agreement Required ☒ YES ☐ NO

☐ GRAVITY ☒ PRESSURE

☒ Residence No. Bedrooms 5

☐ Business No. Persons _____

☐ Other No. Employees _____

☐ Slab ☐ Crawl Space


☒ Basement w/plumbing ☐ Basement w/o plumbing

Water Supply: ☐ Private ☐ Public ☒ Community


Comments / Conditions: Upgrading from 4 Bedrooms to 5 Bedrooms Already had 300ft of Drainfield installed therefore only needed 35ft more for total of 335ft. Scale 1:50

Okay to use existing PT per calculations in Section .1900 15A NCAC 18A .1952(c)(1)(D). However must divert stormwater/surface water away from tanks

INITIAL SITE SKETCH

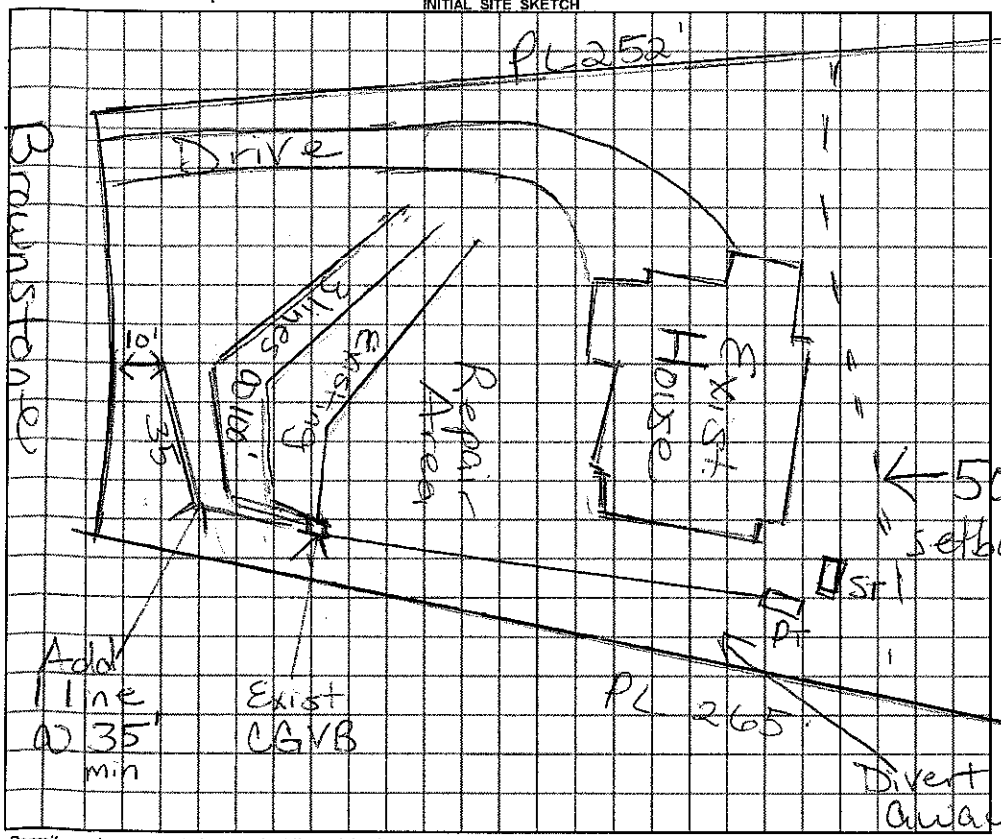

AS BUILT SKETCH

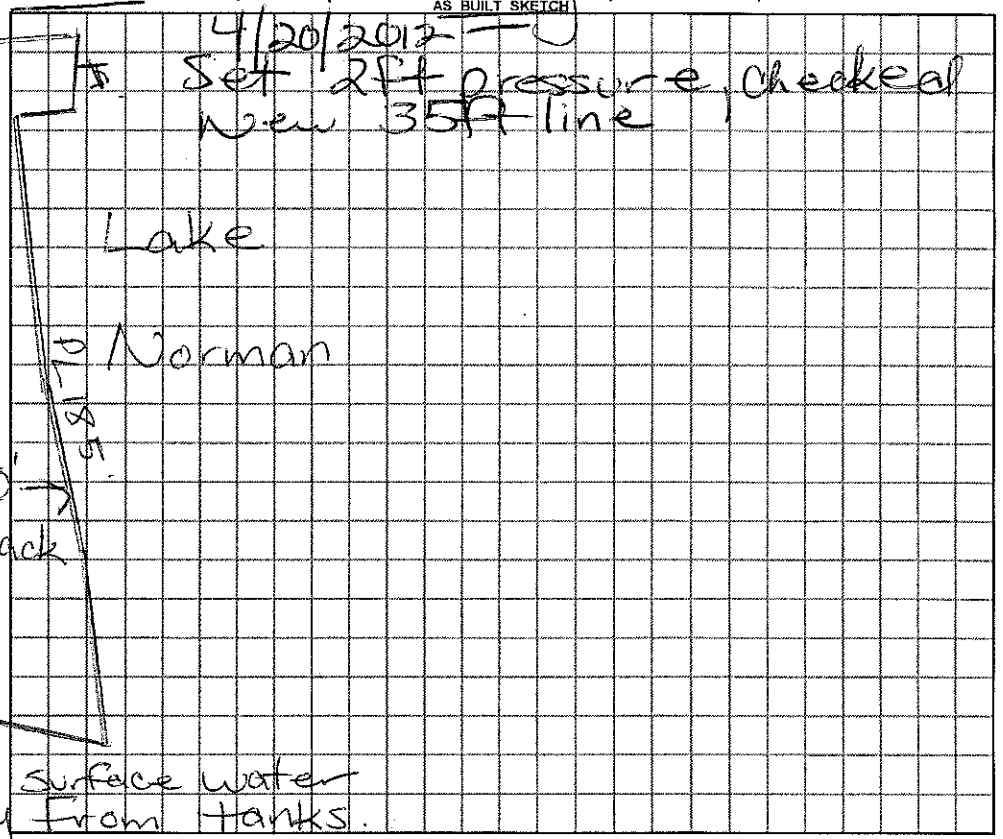

Permit can be suspended or revoked if any false information is supplied toward securing the permit / any unauthorized changes are made to the site / any unauthorized changes are made in the installation of the system.

☐ ***IMPROVEMENT PERMIT*** with plat valid without expiration. ☐ ***IMPROVEMENT PERMIT*** with plat valid without expiration. site plan valid 60 mo. ☐ ***AUTHORIZATION TO CONSTRUCT*** valid for period equal to IMPROVEMENT PERMIT--not to exceed 60 mo.

Owner / Applicant Signature: Andy Trott Date 4/10/2012 Installed by: Hallman Construction

IMPROVEMENT PERMIT by: _____ REHS Date 4/5/2012 OPERATION PERMIT by: _____ REHS Date 4/20/2012

AUTHORIZATION TO CONSTRUCT by: _____ REHS Date 4/5/2012 Existing System Inspected by: _____ REHS Date _____

YOU SHOULD CONTACT A LOCATOR SERVICE PRIOR TO ANY EXCAVATION

White Copy – Environmental Health YELLOW COPY (Final) Owner / Applicant PINK COPY (Initial) Owner / Applicant