IREDELL COUNTY HEALTH DEPARTMENT

STATESVILLE 704-878-5305 MOORESVILLE 704-664-5281

IMPROVEMENT PERMIT / AUTHORIZATION TO CONSTRUCT / OPERATION PERMIT / EXISTING SYSTEM INSPECTION

PERMIT# 82410 PIN# 4625941684 PT DATE 5-12-05

OWNER OR CONTRACTOR Mecklenberg Homeworks PHONE: Business Home

ADDRESS

LOCATION Brawley School Rd TR Marstons Mill TL White Horse TL Ballston TR Brownstone on left

SUBDIVISION Point BLOCK / SECTION 4 LOT 452 LOT AREA 36,694 SITE CLASS PS DESIGN FLOW 180gpd L.T.A.R. .3

Septic Tank: 1500 Gallons; STB 338 Date 2-29-05 [X] New System [ ] Repair System Type: I, II, III, IV, V, VI

Pump Tank: 1000 Gallons; PT 27 Date 3-20-05 System Description: Pump-LP-Panel Blk

Pump Make: Model Serial No. Repair System Description: Same

Nitrification Field: No Fields 1 Square Feet 900 Linear Feet 300 Maintenance Agreement Required: [X] Yes [ ] No

No Lines 6 @ 50' Trench Width 36" Max Trench Bottom Depth 36 Gravel Depth N/A

[X] House/Mod. Home No. Bedrooms 4 [ ] Slab [X] Crawl Space [ ] Basement w/plumbing [ ] Basement wo/plumbing

[ ] Mobile Home No. Bathrooms 4

[ ] Business No. Employees

[ ] Other

Water Supply: [ ] Individual [X] Public [X] Community


Comments:/Conditions:

Comments:/Conditions:

Scale 1:50'

INITIAL SITE SKETCH

AS BUILT SKETCH

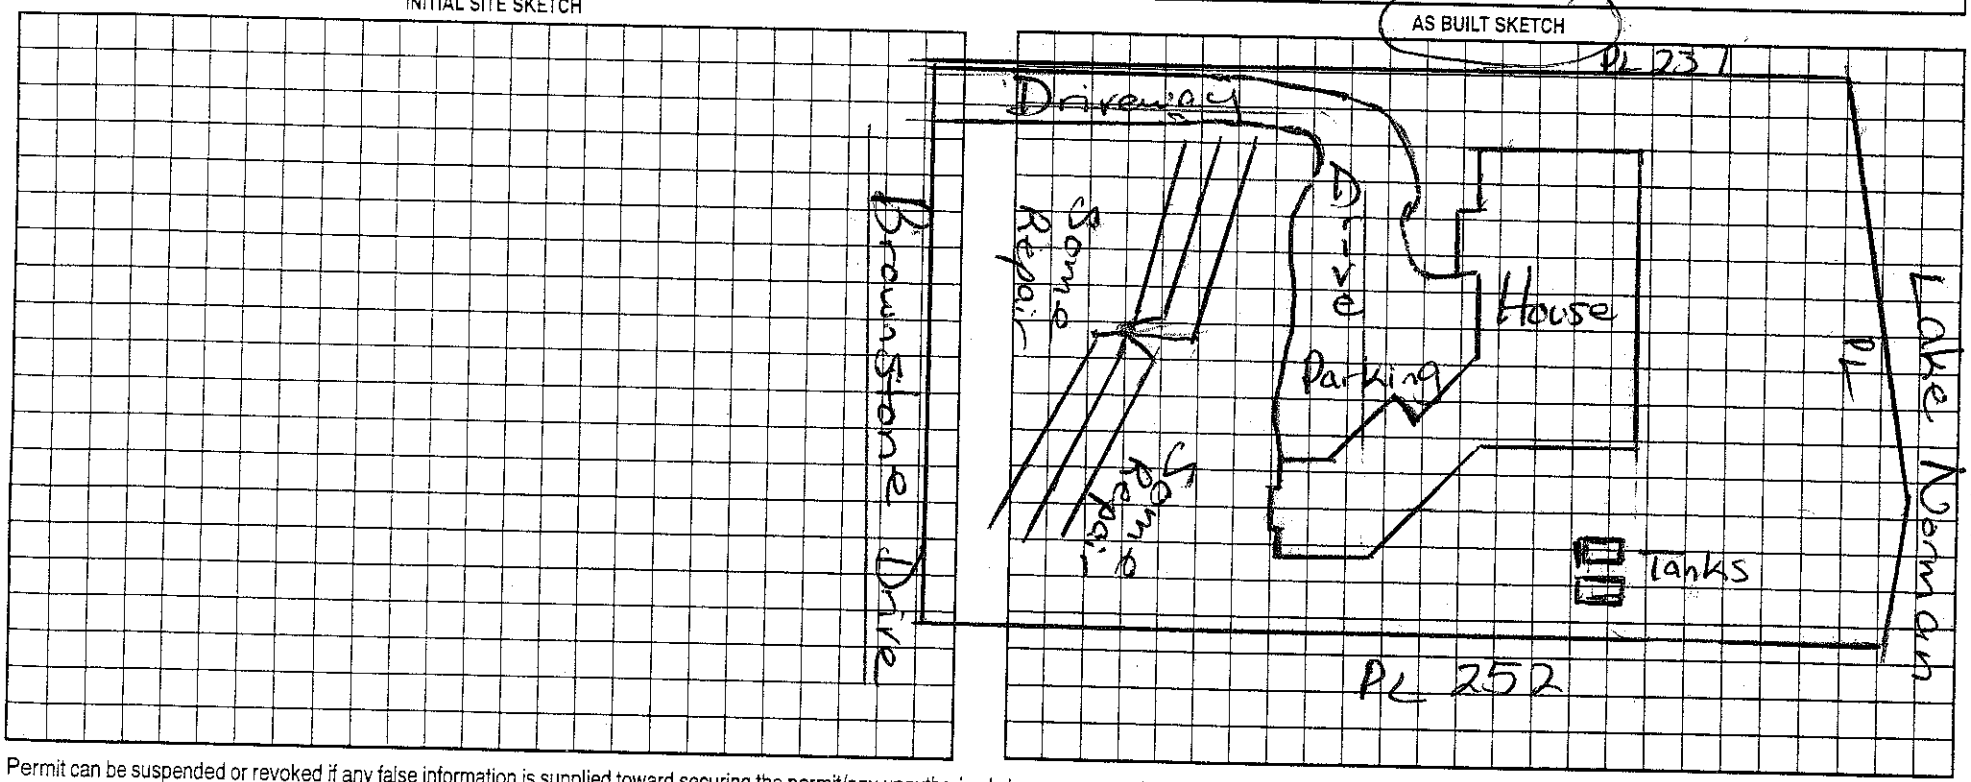

Permit can be suspended or revoked if any false information is supplied toward securing the permit/any unauthorized changes are made to the site/any unauthorized changes are made in the installation of the system. Improvement Permit with plat valid without expiration. Improvement Permit with site plan valid for sixty months. Authorization to Construct is valid for a period equal to that of Improvement Permit – not to exceed sixty months.

Signed: date

Improvement Permit by: date

Authorization to Construct by: Maria H. Dotson RS date 5/12/05

Installed by: R & F RS

Operation Permit by: Maria H. Dotson date 5/13/05

Existing System Inspection by date

HEALTH DEPT. COPY: WHITE OWNER COPY (FINAL): YELLOW OWNER COPY (INITIAL): PINK