IREDELL COUNTY HEALTH DEPARTMENT

STATESVILLE 704-878-5305 MOORESVILLE 704-664-5201

3:00

IMPROVEMENT PERMIT / AUTHORIZATION TO CONSTRUCT / OPERATION PERMIT / EXISTING SYSTEM INSPECTION

PERMIT# 82410 PIN# 4625941684 PT 4625-87-4315 DATE 1/7/00

OWNER OR CONTRACTOR CRESCENT RESOURCES/Mecklenberg Homes PHONE: Business 663-6905 JACOBS Home

ADDRESS BRAWLEY SCHOOL; TR MARSONS MILL - TL WHITE HORSE - TL BALLSTON - TR BROWNSTONE - ON LT

LOCATION

SUBDIVISION POINT BLOCK / SECTION 4 LOT 452 LOT AREA 36694 SITE CLASS. PS DESIGN FLOW 480 GPD L.T.A.R. .30 GPD/FT2

Septic Tank: ~~1000 + 1500~~ Gallons; STB 338 Date 2-29-05

Pump Tank: 1000 + Gallons; PT 27 Date 3-20-05

Pump Make: Model Serial No.

Nitrification Field: No Fields 1 Square Feet 900 Linear Feet 300

No Lines 3 @ 100' Trench Width 36" Max Trench Bottom Depth 36" Gravel Depth N/A

☑ New System ☐ Repair System Type: I, II, III, IV, V, VI

System Description: LP PANEL

Repair System Description: SAME

Maintenance Agreement Required: ☑ Yes ☐ No

☑ House/Mod. Home No. Bedrooms 4

☐ Mobile Home No. Bathrooms 4

☐ Business No. Employees

☐ Other

☐ Slab ☑ Crawl Space ☑ Basement w/plumbing ☐ Basement wo/plumbing

Water Supply: ☐ Individual ☐ Public ☑ Community

Comments/Conditions: REMOVE ALL TERRACES AND BERMS.


Note: Grader overcut for drive causing Drainfield to be more farther from house.

Comments/Conditions: ½ BASEMENT ONLY

Installed 6 - 50' lines (Center-fed)

Checked tanks & lines 4/28/05 MD

INITIAL SITE SKETCH 1"=50'

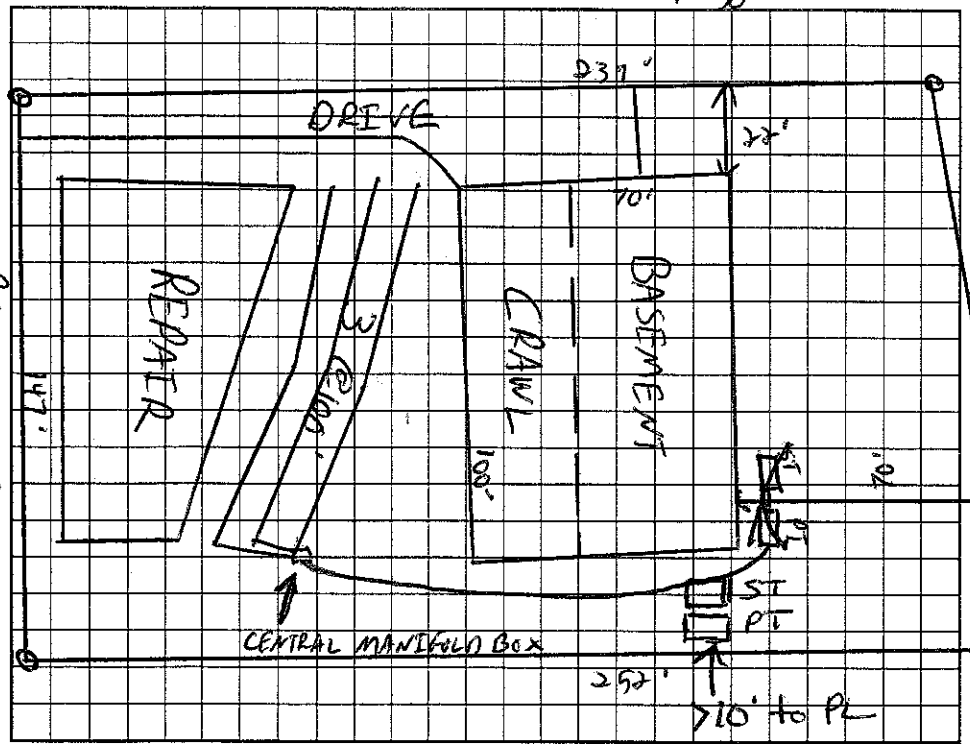

AS BUILT SKETCH

★ See Attached "As Built" Sketch

Permit can be suspended or revoked if any false information is supplied toward securing the permit/any unauthorized changes are made to the site/any unauthorized changes are made in the installation of the system. Improvement Permit with ~~plat valid without~~ expiration. Improvement Permit with site plan valid for sixty months. Authorization to Construct is valid for a period equal to that of Improvement Permit – not to exceed sixty months.

Signed: date 1-21-0

Improvement Permit by: C. B RS date 1/7/00

Authorization to Construct by: RS date 6/14/04

Installed by: R & H RS

Operation Permit by: Maria H Dolan RS date 5/13/05

Existing System Inspection by: date

HEALTH DEPT. COPY: WHITE OWNER COPY (FINAL): YELLOW OWNER COPY (INITIAL): PINK