IREDELL COUNTY HEALTH DEPARTMENT

STATESVILLE 704-878-5305 MOORESVILLE 704-664-5281

IMPROVEMENT PERMIT / AUTHORIZATION TO CONSTRUCT / OPERATION PERMIT / EXISTING SYSTEM INSPECTION

Sht 1 of 1

PERMIT# 82411 PIN# 4625941684 PT 4625874487 DATE 1/4/00

OWNER OR CONTRACTOR CRESCENT RESOURCES/David Dibble PHONE: Business 663-6905 JACOBS Home

ADDRESS PO BOX 1003 CHARLOTTE 28202

LOCATION BRAWLEY SCHOOL - TR MARSONSMILL - TL WHITE HORSE - TL BALLSON - TR BROWNSTONE ON LT

SUBDIVISION POINT BLOCK / SECTION 4 LOT 453 LOT AREA 31473 SITE CLASS RS DESIGN FLOW 480GPD L.T.A.R. .3 gpd/ft2

Septic Tank: 1000+ Gallons; STB 338 Date 7-27-04

Pump Tank: 1000+ Gallons; PT 283 Date 7-27-04

Pump Make: Goulds Model WE0512HH Serial No. F0463124

Nitrification Field: No Fields 1 Square Feet 1200 Linear Feet 400

No Lines 4@100' Trench Width 36" Max Trench Bottom Depth 36" Gravel Depth

☑ New System ☐ Repair System Type: I, II, III, IV, V, VI

System Description: PUMP 25% REDUCTION

Repair System Description: LP PANEL

Maintenance Agreement Required: ☐ Yes ☑ No

☑ House/Mod. Home No. Bedrooms 4

☐ Mobile Home No. Bathrooms 4

☐ Business No. Employees

☐ Other


☐ Slab ☑ Crawl Space ☑ Basement w/plumbing ☐ Basement wo/plumbing

Water Supply: ☐ Individual ☐ Public ☑ Community

Comments:/Conditions: REMOVE ALL TERRACES AND BERMS.

Comments:/Conditions: PARTIAL BASEMENT ONLY
EZ Flow installed for Drainfield
Checked tank (ST) & lines 8/31/04 MD
Checked PT & pressure 9/1/04

INITIAL SITE SKETCH 1"=50'

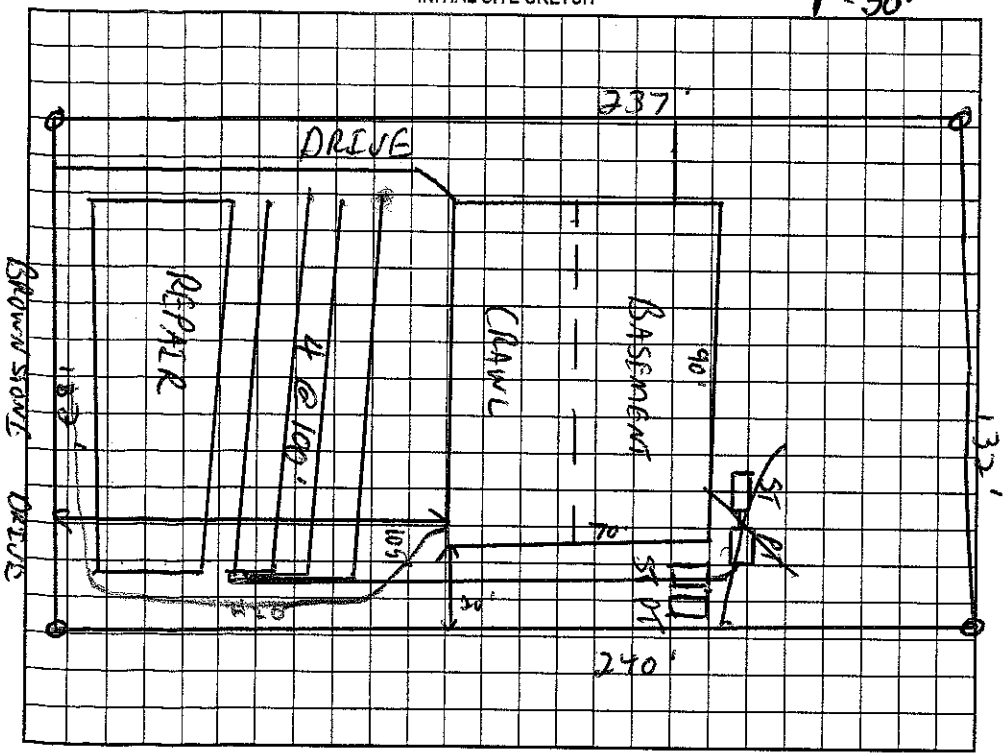

AS BUILT SKETCH

Permit can be suspended or revoked if any false information is supplied toward securing the permit/any unauthorized changes are made to the site/any unauthorized changes are made in the installation of the system. Improvement Permit with plat valid without expiration. Improvement Permit with site plan valid for sixty months. Authorization to Construct is valid for a period equal to that of Improvement Permit – not to exceed sixty months.

[signature] date 1-21-00 Installed by: C. Wayne Orbison

Permit by: C. Bill Team RS date 1/4/00 Operation Permit by: Wesley Sparks RS date 10/21/04

Construct by: Wesley Sparks RS date 1/22/04 Existing System Inspection by: date

HEALTH DEPT. COPY: WHITE OWNER COPY (FINAL): YELLOW OWNER COPY (INITIAL): PINK