TYPE III (b)

IREDELL COUNTY HEALTH DEPARTMENT

STATESVILLE 704-878-5305 MOORESVILLE 704-664-5[illegible]

IMPROVEMENT PERMIT / AUTHORIZATION TO CONSTRUCT / OPERATION PERMIT / EXISTING SYSTEM INSPECTION

PERMIT# 82414/116424 PIN# ~~4625947684 PT~~ 4625-87-7331 DATE 1/12/00

OWNER OR CONTRACTOR CRESCENT RESOURCES (Signature Homes) PHONE: Business 663 6905 JACOBS Home

ADDRESS PO BOX 1003 CHARLOTTE NC 28202 | 176 BROWNSTONE DR

LOCATION BRAWLEY SCHOOL - TR MARSTONS MILL - TL WHITE HORSE - TL BALLSTON - TL BROWNSTONE ON RT

SUBDIVISION POINT BLOCK / SECTION 4 LOT 456 LOT AREA 30763 SITE CLASS. DS DESIGN FLOW ~~600~~ 460 GPD L.T.A.R. ~.256 GPD/FT2

Septic Tank: 1500 Gallons; STB 338 Date

Pump Tank: ~~1500~~ 1000 Gallons; PT 283 Date 4/19/04

Pump Make: Myers Model 100S-21 Serial No.

Nitrification Field: No Fields 1 Square Feet 1500 Linear Feet 500

No Lines 5@100' Trench Width 36" Max Trench Bottom Depth 36" Gravel Depth N/A

☑ New System ☐ Repair System Type: I, II, III, IV, V, VI

System Description: PUMP 25% REDUCTION

Repair System Description: SAME

Maintenance Agreement Required: ☐ Yes ☑ No OFFSITE

☑ House/Mod. Home No. Bedrooms ~~3~~ 4

☐ Mobile Home No. Bathrooms ~~3~~ 4

☐ Business No. Employees

☐ Other

☐ Slab ☐ Crawl Space ☑ Basement w/plumbing ☐ Basement wo/plumbing


Water Supply: ☐ Individual ☐ Public ☑ ~~Community~~

Comments/Conditions: REMOVE ALL TERRACES AND BERMS


Comments/Conditions: P/T OK - 6/8/04

7/16/04 - ±3 Lin Ft Rock

INITIAL SITE SKETCH

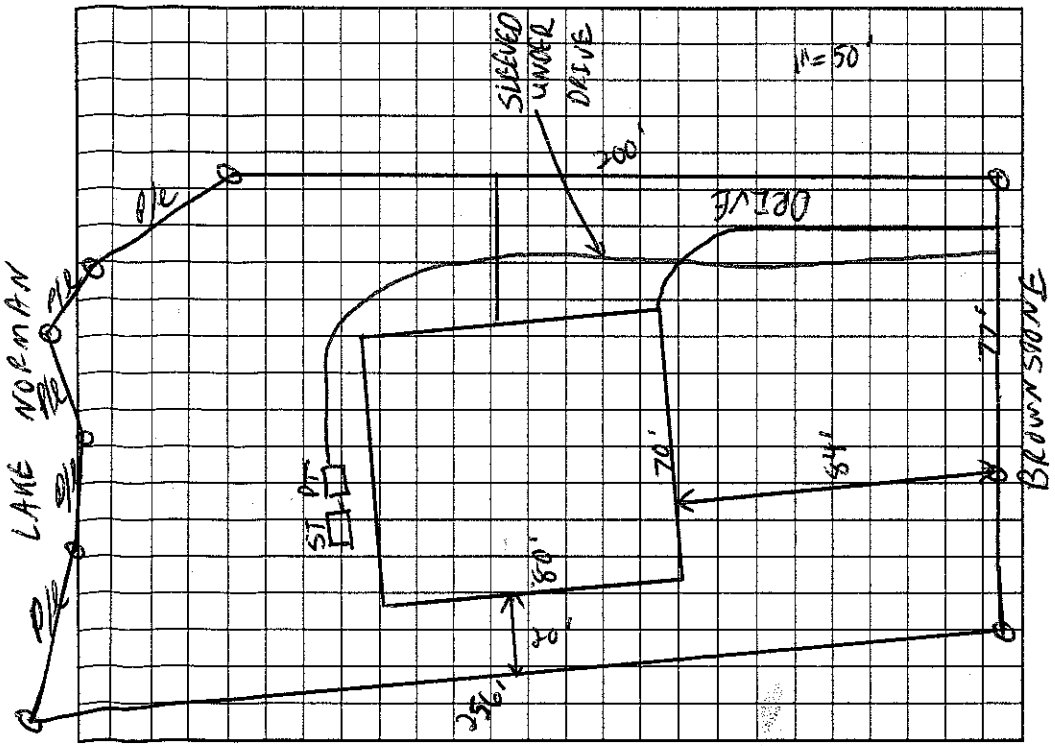

AS BUILT SKETCH

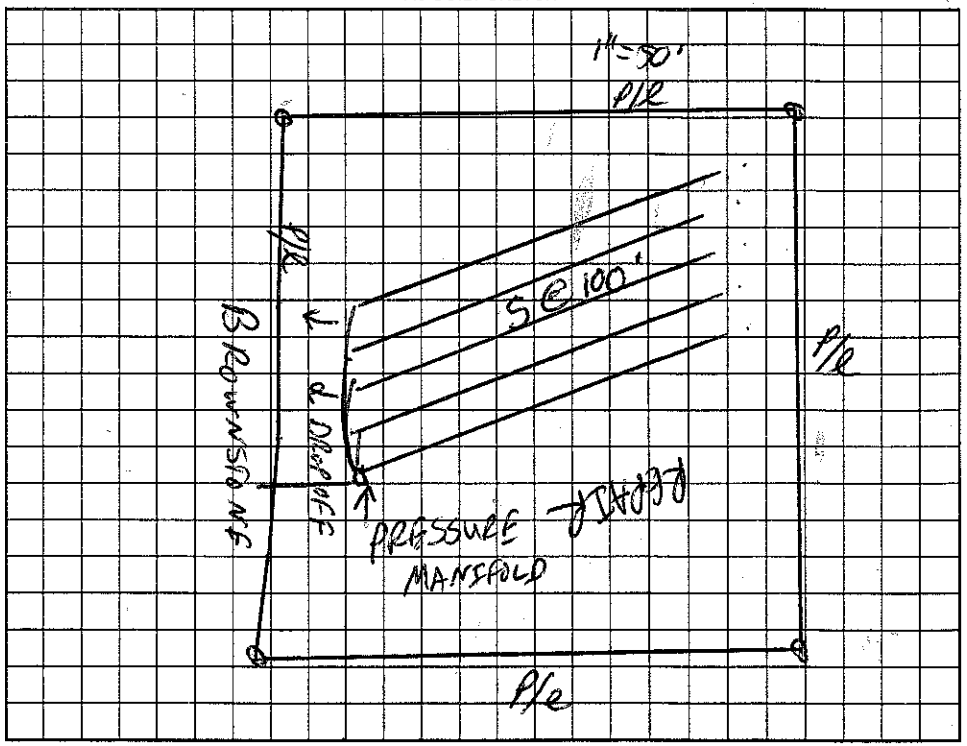

Permit can be suspended or revoked if any false information is supplied toward securing the permit/any unauthorized changes are made to the site/any unauthorized changes are made in the installation of the system. Improvement Permit with ~~plat valid~~ without ~~expiration~~. Improvement Permit with site plan valid for sixty months. Authorization to Construct is valid for a period equal to that of Improvement Permit - not to exceed sixty months.

Signed: [signature] date 1-21-00 Installed by: Pendleton Const. (Replaced w/ HALLMAN CONST.)

Improvement Permit by: C. Blackwelder RS date 1/12/00 Operation Permit by: Wesley Sparks RS date 9/16/04

Authorization to Construct by: [signature] Timmons IRS date Existing System Inspection by: date

HEALTH DEPT. COPY: WHITE OWNER COPY (FINAL): YELLOW OWNER COPY (INITIAL): PINK