IREDELL COUNTY HEALTH DEPARTMENT

STATESVILLE 704-878-5305 50.00 Paid MOORESVILLE 704-664-5281

IMPROVEMENT PERMIT / AUTHORIZATION TO CONSTRUCT / OPERATION PERMIT / EXISTING SYSTEM INSPECTION

PERMIT# 082413 PIN# ~~4625-94-1684~~ 4625-87-7561 DATE 9/7/04

OWNER OR CONTRACTOR Elrod Custom Homes Inc. PHONE: Business 704 987 5072 Home

ADDRESS 16405-C Northcross Dr. Huntersville NC 28078

LOCATION BSR, TR Marstons Mill, TL White Horse TL Ballston, TL Brownstone on Rt

SUBDIVISION Point BLOCK / SECTION 4 LOT 455 LOT AREA 46,687 Ft² SITE CLASS PS DESIGN FLOW 480 L.T.A.R. 0.25

Septic Tank: ~~1000~~ 1500 Gallons; STB 335 Date 5/29/05

Pump Tank: 1000 Gallons; PT 27 Date 5/30/05

Pump Make: Goulds Model 07HH4 Serial No.

Nitrification Field: No Fields 1 Square Feet 960 Linear Feet 320

No Lines 6 Trench Width 36" Max Trench Bottom Depth 36" Gravel Depth —

☒ New System ☐ Repair System Type: I, II, III, (IV), V, VI

System Description: LP Panel Block

Repair System Description: Same

Maintenance Agreement Required: ☒ Yes ☐ No

☒ House/Mod. Home No. Bedrooms 4

☐ Mobile Home No. Bathrooms

☐ Business No. Employees

☐ Other

☐ Slab ☐ Crawl Space ☒ Basement w/plumbing ☐ Basement wo/plumbing

Water Supply: ☐ Individual ☐ Public ☒ Community


Comments:/Conditions:

Comments:/Conditions:


74 Panel

3/16" holes

INITIAL SITE SKETCH

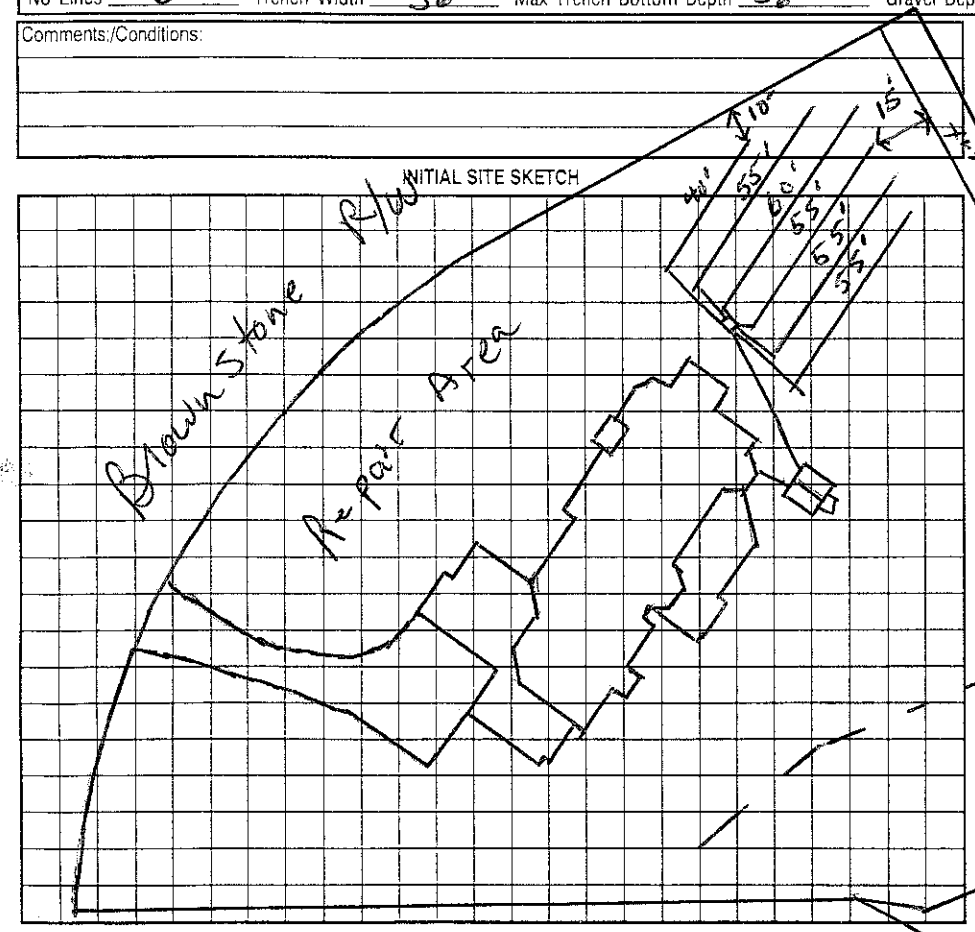

AS BUILT SKETCH

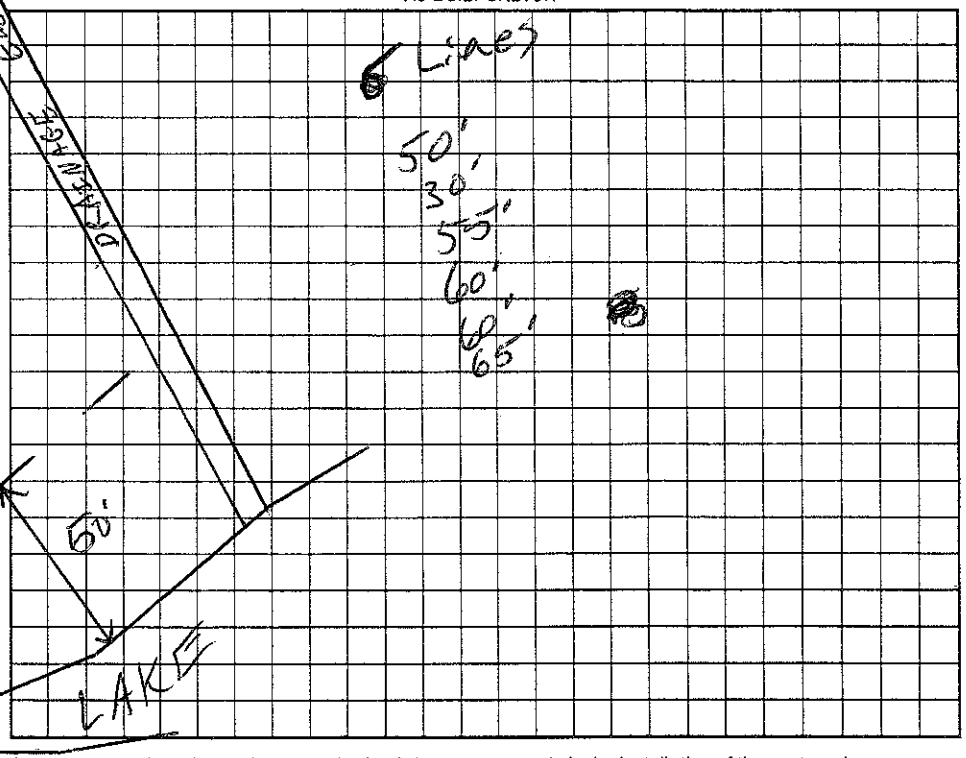

Permit can be suspended or revoked if any false information is supplied toward securing the permit/any unauthorized changes are made to the site/any unauthorized changes are made in the installation of the system. Improvement Permit with plat valid without expiration. Improvement Permit with site plan valid for sixty months. Authorization to Construct is valid for a period equal to that of Improvement Permit – not to exceed sixty months.

Signed: date 9/6/04 Installed by: Orbison

Improvement Permit by: RS date 9/7/04 Operation Permit by: RS date 10/18/05

Authorization to Construct by: RS date 9/7/04 Existing System Inspection by: date

HEALTH DEPT. COPY: WHITE OWNER COPY (FINAL): YELLOW OWNER COPY (INITIAL): PINK