3.00

IREDELL COUNTY HEALTH DEPARTMENT

STATESVILLE 704-878-5305 MOORESVILLE 704-664-5281

IMPROVEMENT PERMIT / AUTHORIZATION TO CONSTRUCT / OPERATION PERMIT / EXISTING SYSTEM INSPECTION

PERMIT# 82429 PIN# 4625941684 RT 4625-87-9729 DATE 1/4/00

OWNER OR CONTRACTOR CRESCENT RESOURCES / GM Helms PHONE: Business 663-6905 JACOBS Home

ADDRESS PO BOX 1003 - CHARLOTTE NC 28202

LOCATION BRAWLEY SCHOOL - TR MARSONS MLC - TL WHITEHORSE - TL BALLSTON - TL BROWNSTONE ON LT

SUBDIVISION POINT BLOCK / SECTION 4 LOT 470 LOT AREA 53926 SITE CLASS. PS DESIGN FLOW 480 L.T.A.R. .3 gal/ft²

Septic Tank: ~~1000 +~~ 1500 Gallons; STB 338 Date 5-19-01

Pump Tank ~~1000 +~~ Gallons; PT Date

Pump Make: Model Serial No.

Nitrification Field: No Fields 1 Square Feet 1200 Linear Feet 400

No Lines 4@100' Trench Width 36" Max Trench Bottom Depth 36" Gravel Depth N/A

☑ New System ☐ Repair System Type: I, II, III, IV, V, VI

System Description: GRAVITY 25% REDUCTION

Repair System Description: LP PANEL

Maintenance Agreement Required: ☐ Yes ☑ No

☑ House/Mod. Home ☐ Mobile Home ☐ Business ☐ Other

No. Bedrooms 4 No. Bathrooms 4 No. Employees


Water Supply: ☐ Individual ☐ Public ☑ ~~Community~~

☐ Slab ☑ ~~Crawl Space~~ ☑ Basement w/plumbing ☐ Basement wo/plumbing

Comments:/Conditions: REMOVE ALL TERRACES AND BERMS.

1"=50'

INITIAL SITE SKETCH

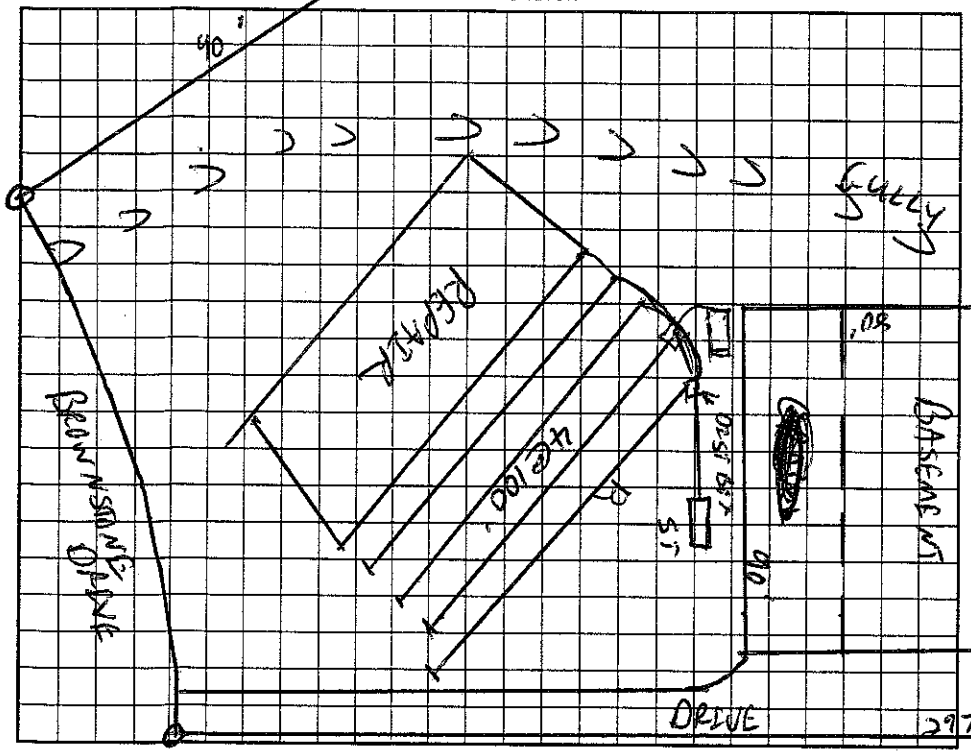


Comments:/Conditions: ~~BASEMENT~~

4/28/00 BF - FULL BASEMENT

11/21/00 No Basement

Plan mostly complies with Soil Plan Auth.

AS BUILT SKETCH

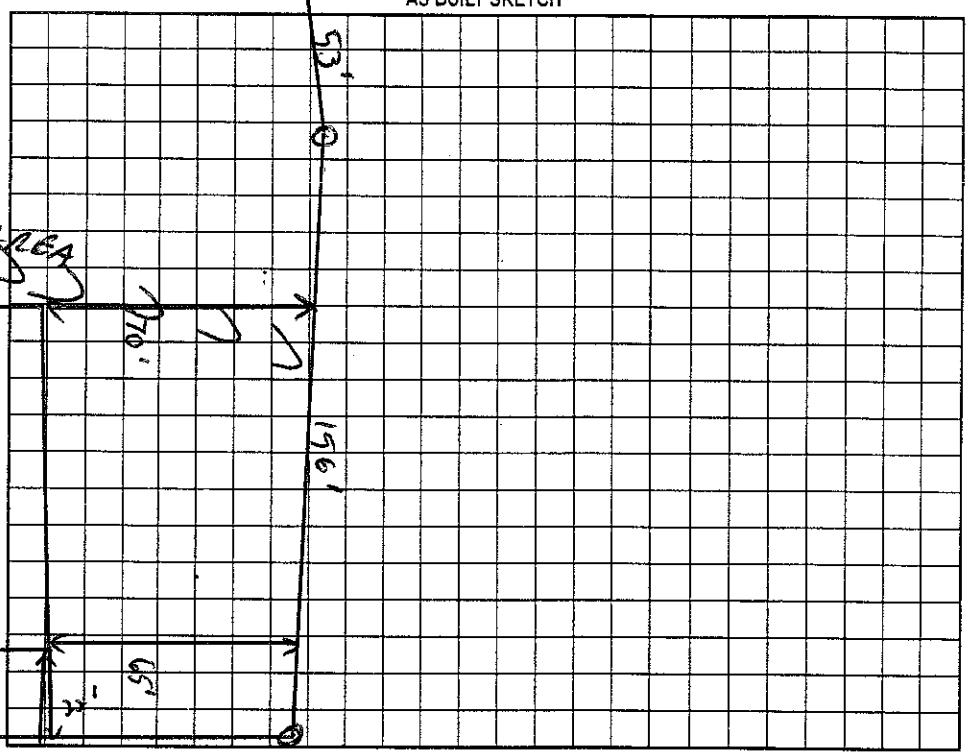

Permit can be suspended or revoked if any false information is supplied toward securing the permit/any unauthorized changes are made to the site/any unauthorized changes are made in the installation of the system. Improvement Permit with plat valid without ~~expiration~~. Improvement Permit with site plan valid for sixty months. Authorization to Construct is valid for a period equal to that of Improvement Permit – not to exceed sixty months.

Signed: date 1-21-00

Improvement Permit by: KS date 1/4/00

Authorization to Construct by: Wilson Sparks RS. date 11/21/00

Installed by: R & H

Operation Permit by: Maria H. Dotson RS date 7/3/2001

Existing System Inspection by: date

HEALTH DEPT. COPY: WHITE OWNER COPY (FINAL): YELLOW OWNER COPY (INITIAL): PINK