IREDELL COUNTY HEALTH DEPARTMENT

STATESVILLE 704-878-5305 MOORESVILLE 704-664-5281

IMPROVEMENT PERMIT / AUTHORIZATION TO CONSTRUCT / OPERATION PERMIT / EXISTING SYSTEM INSPECTIO

PERMIT# 82355 PIN# 462594/684 PT 4625-88-1170 DATE 1/12/00

OWNER OR CONTRACTOR CRESCENT RESOURCES/Hughes, Hamelink PHONE: Business 663-6905 JACOBS Home

ADDRESS PO BOX 1003 CHARLOTTE NC 28201 & Lande

LOCATION BRAWLEY SCHOOL - TR MARSTONS MILL - TL WHITE HORSE TL BALLSTON ON RT

SUBDIVISION POINT BLOCK / SECTION 4 LOT 433 LOT AREA 46651 SITE CLASS. PS DESIGN FLOW 450 GPD L.T.A.R. .25 gpd/ft2

Septic Tank: 1000+ Gallons; STB 338 Date 1/24/64
Pump Tank: 1000+ Gallons; PT 283 Date 1/11/64
Pump Make: Gouldes Model WE0512 H#### Serial No. AC456575
Nitrification Field: No Fields 1 Square Feet 960 Linear Feet 320
No Lines 4 Trench Width 36" Max Trench Bottom Depth 30" Gravel Depth #4

☑ New System ☐ Repair System Type: I, II, III, (IV), V, VI
System Description: LP PANEL OFFSITE
Repair System Description: LPP OFFSITE
Maintenance Agreement Required: ☑ Yes ☐ No


☑ House/Mod. Home No. Bedrooms 4
☐ Mobile Home No. Bathrooms 4
☐ Business No. Employees
☐ Other
☐ Slab ☐ Crawl Space ☑ Basement w/plumbing ☐ Basement wo/plumbing

Water Supply: ☐ Individual ☐ Public ☑ Community


Comments:/Conditions: REMOVE ALL TERRACES AND BERMS. Reviewed building plans & floor plans; essentially in compliance with original permit.

Comments:/Conditions: Installed in 3 lines - 100, 110, 110

INITIAL SITE SKETCH

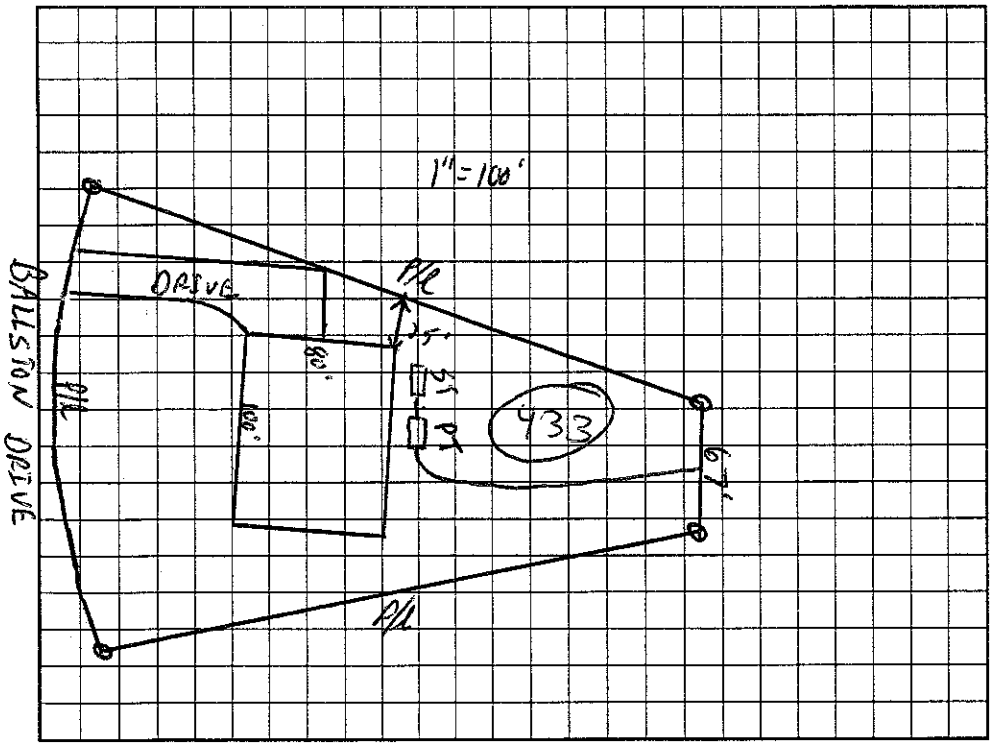

AS BUILT SKETCH

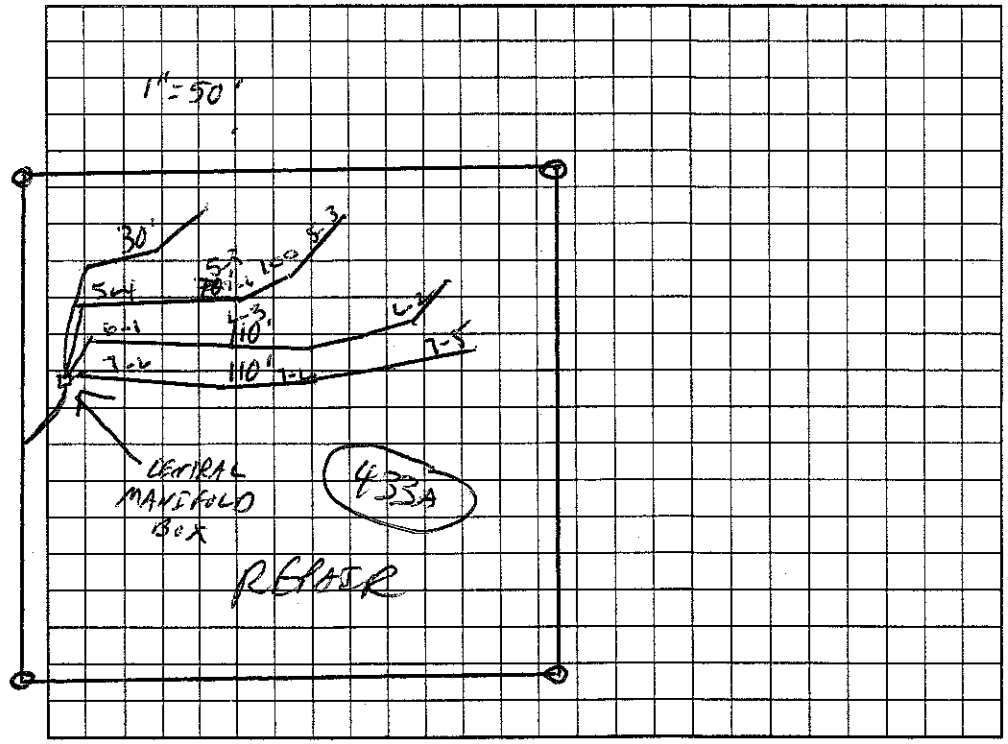

Permit can be suspended or revoked if any false information is supplied toward securing the permit/any unauthorized changes are made to the site/any unauthorized changes are made in the installation of the system. Improvement Permit with plat valid without expiration. Improvement Permit with site plan valid for sixty months. Authorization to Construct is valid for a period equal to that of Improvement Permit – not to exceed sixty months.

Signed: [signature] date 1-21-00 Installed by: David Clark

Improvement Permit by: C. Ray Freeman RS date 1/12/00 Operation Permit by: Wesley Sparks RS date 4/29/64

Authorization to Construct by: Mark H. Dobson RS date 1/25/03 Existing System Inspection by: date

HEALTH DEPT. COPY: WHITE OWNER COPY (FINAL): YELLOW OWNER COPY (INITIAL): PINK