IREDELL COUNTY HEALTH DEPARTMENT

STATESVILLE 704-878-5305 MOORESVILLE 704-664-5281

IMPROVEMENT PERMIT / AUTHORIZATION TO CONSTRUCT / OPERATION PERMIT / EXISTING SYSTEM INSPECT

PERMIT# 82462 PIN# 4625941684 PT 4625-88-1407 DATE 1/5/00

OWNER OR CONTRACTOR CRESCENT RESOURCES Lake Norman SIGNATURE PHONE: Business 663-6905 JACOBS Home

ADDRESS PO BOX 1003 CHARLOTTE NC 28202 HOMES

LOCATION BRAWLEY SCHOOL - TR MARSONS MILL - TL WHITE HORSE - TL BALLSTON - ON LT

SUBDIVISION POINT BLOCK / SECTION 4 LOT 479 LOT AREA 32,942 SITE CLASS. DS DESIGN FLOW 480 GPD L.T.A.R. .3 GAD/FT-2

Septic Tank: ~~1000~~ + 1500 Gallons; STB 335 Date 11/5/01

Pump Tank: 1000 T Gallons; PT 27 Date 11/10/01

Pump Make: Myers Model ME SUS-2 Serial No.

Nitrification Field: No Fields 1 Square Feet 1200 Linear Feet 400

No Lines 4@100' Trench Width 36" Max Trench Bottom Depth 36" Gravel Depth N/A

☑ New System ☐ Repair System Type: I, II, III, IV, V, VI

System Description: PUMP 25% REDUCTION

Repair System Description: LP PANEL

Maintenance Agreement Required: ☐ Yes ☑ No

☑ House/Mod. Home No. Bedrooms 4

☐ Mobile Home No. Bathrooms 4

☐ Business No. Employees

☐ Other

☐ Slab ☑ Crawl Space ☐ Basement w/plumbing ☐ Basement wo/plumbing


Water Supply: ☐ Individual ☐ Public ☑ Community

Comments:/Conditions: REMOVE ALL TERRACES AND BERMS.
Building plans reviewed 5/31/2001 MD
Seem to be in compliance.


Comments:/Conditions: CRAWL ONLY

1"=50'

INITIAL SITE SKETCH

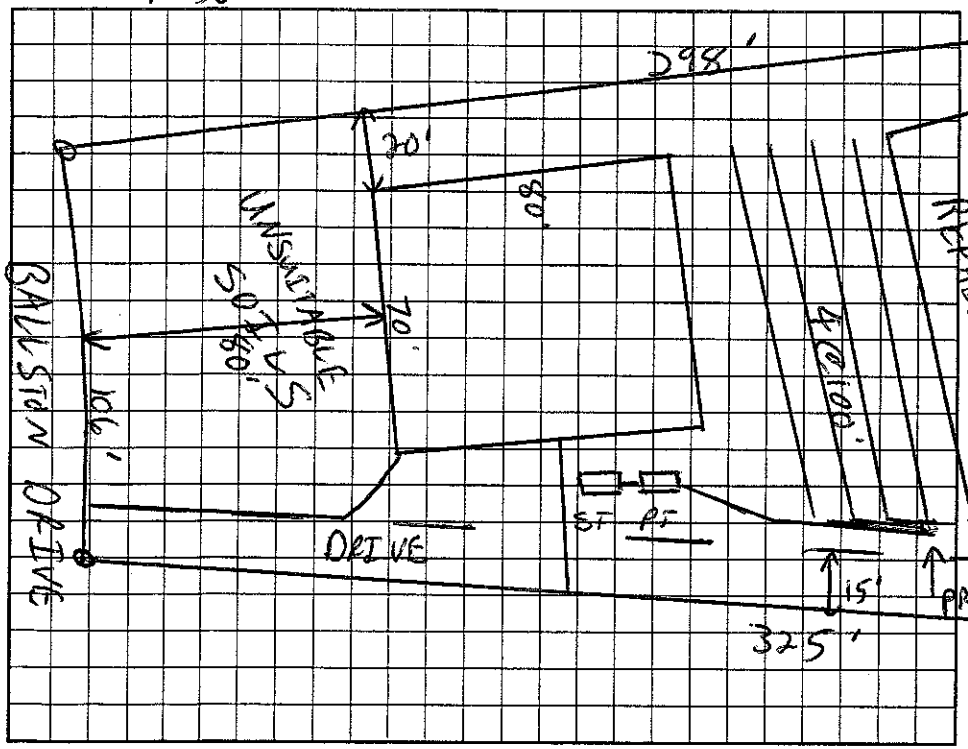

AS BUILT SKETCH

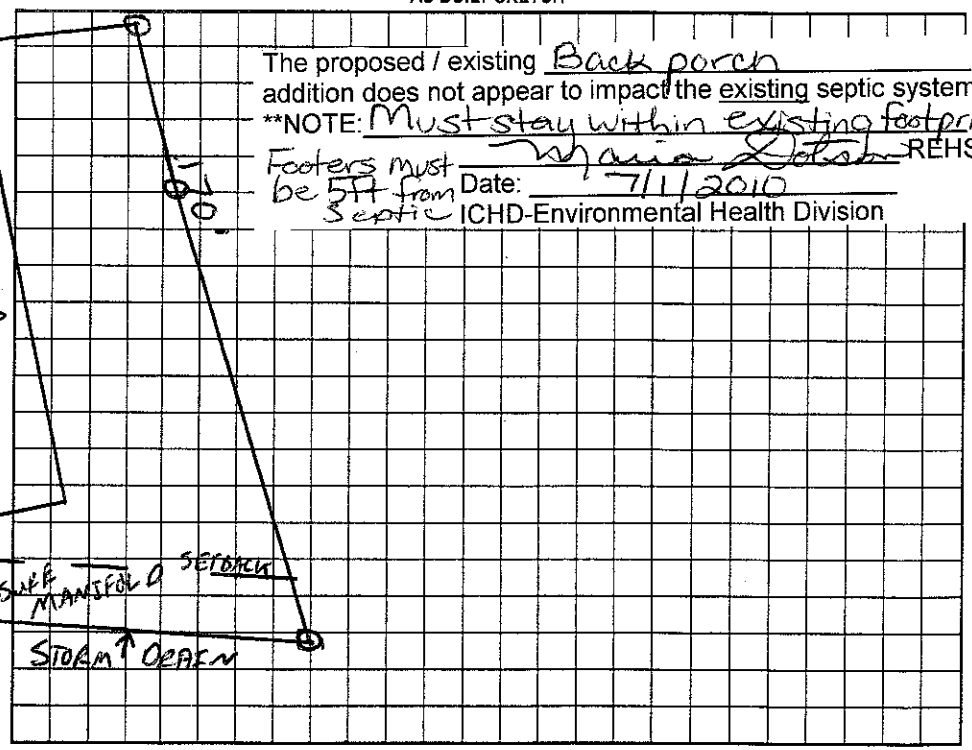

The proposed / existing Back porch addition does not appear to impact the existing septic system.

**NOTE: Must stay within existing footprint

Footers must be 5ft from septic

Maria Dotson REHS

Date: 7/1/2010

ICHD-Environmental Health Division

Permit can be suspended or revoked if any false information is supplied toward securing the permit/any unauthorized changes are made to the site/any unauthorized changes are made in the installation of the system. Improvement Permit with plat valid without expiration. Improvement Permit with site plan valid for sixty months. Authorization to Construct is valid for a period equal to that of Improvement Permit – not to exceed sixty months.

Signed: date 1-21-00 Installed by: Holman Const

Improvement Permit by: C. Bulthuis RS date 1/5/00 Operation Permit by: RS date 2/4/02

Authorization to Construct by: Maria H. Dotson RS date 5/31/2001 Existing System Inspection by: date

HEALTH DEPT. COPY: WHITE OWNER COPY (FINAL): YELLOW OWNER COPY (INITIAL): PINK