IREDELL COUNTY HEALTH DEPARTMENT

4-08

SVILLE 704-878-5305 MOORESVILLE 704-664-5281

IMPROVEMENT PERMIT / AUTHORIZATION TO CONSTRUCT / OPERATION PERMIT / EXISTING SYSTEM INSPECTION

PERMIT# 8/914/118853 PIN# 4625941684 PT 4626703227 DATE 1/18/00

OWNER OR CONTRACTOR CRESCENT RESOURCES/Arcadia Homes PHONE: Business 663 6905 Home

ADDRESS PO BOX 1003 CHARLOTTE NC 28202

LOCATION BRAWLEY SCHOOL TR MARSTONS MILL - TR WHITE HORSE - TR TUCKER NUCK - TR WELL FLEET AT END

SUBDIVISION DOENT BLOCK / SECTION 4 LOT 396 LOT AREA 7657 S. SITE CLASS. PS DESIGN FLOW 480 GPD L.T.A.R. .3 gpd/ft2

Septic Tank: 1000 T Gallons; STB 338 Date 11-29-04
Pump Tank: 1000 T Gallons; PT 283 Date 11-29-04
Pump Make: Goulds Model WE0312M1 Serial No.
Nitrification Field: No Fields 1 Square Feet 1200 Linear Feet 400
No Lines 4@100' Trench Width 36" Max Trench Bottom Depth 36" Gravel Depth N/A

☑ New System ☐ Repair System Type: I, II, III, IV, V, VI
System Description: PUMP 25% REDUCTION
Repair System Description: LP PANEL
Maintenance Agreement Required: ☐ Yes ☑ No

☑ House/Mod. Home No. Bedrooms 4
☐ Mobile Home No. Bathrooms 4
☐ Business No. Employees
☐ Other

☐ Slab ☑ Crawl Space ☑ Basement w/plumbing ☐ Basement wo/plumbing


Water Supply: ☐ Individual ☐ Public ☑ Community

Comments:/Conditions: REMOVE ALL TERRACES AND BERMS

Comments:/Conditions: (PARTIAL BASEMENT ONLY Installed as Drawn Used EZ Flow

INITIAL SITE SKETCH

The proposed / existing Pool addition does not appear to impact the existing septic system.
**NOTE:
S-A-08-8 R.S.
Date: 12-17-2010
ICHD-Environmental Health Division

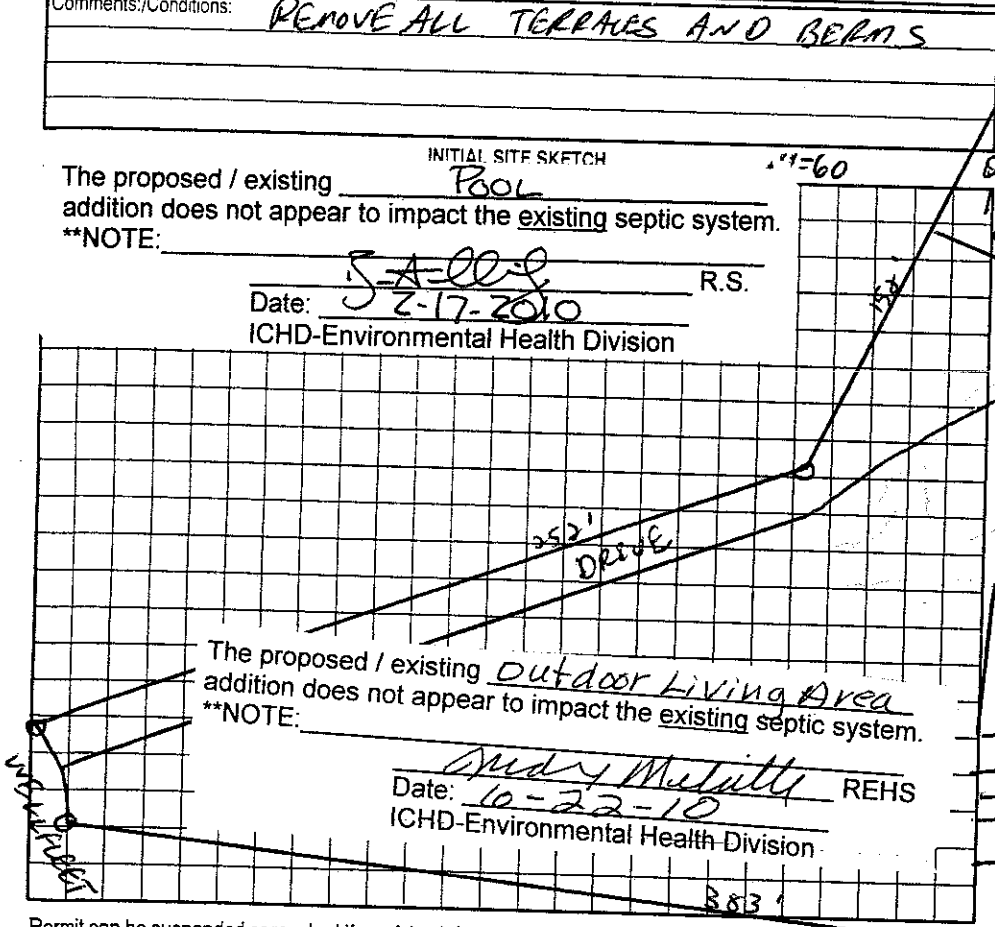

AS BUILT SKETCH

The proposed / existing Outdoor Living Area addition does not appear to impact the existing septic system.
**NOTE:
Andy Mutatt REHS
Date: 10-22-10
ICHD-Environmental Health Division

Permit can be suspended or revoked if any false information is supplied toward securing the permit/any unauthorized changes are made to the site/any unauthorized changes are made in the installation of the system. Improvement Permit with plat valid without expiration. Improvement Permit with site plan valid for sixty months. Authorization to Construct is valid for a period equal to that of Improvement Permit – not to exceed sixty months.

Signed: date 1-21-05
Improvement Permit by: RS date 1/18/00
Authorization to Construct by: RS date 2/4/04
Installed by: R&H
Operation Permit by: Maria H. Dolan RS date 2/9/05
Existing System Inspection by: date

HEALTH DEPT. COPY: WHITE OWNER COPY (FINAL): YELLOW OWNER COPY (INITIAL): PINK