IREDELL COUNTY HEALTH DEPARTMENT

STATESVILLE 704-878-5305 MOORESVILLE 704-664-5281

IMPROVEMENT PERMIT / AUTHORIZATION TO CONSTRUCT / OPERATION PERMIT / EXISTING SYSTEM INSPECTION

PERMIT# 127567 PIN# 4625 88 2457 DATE 3/17/05

OWNER OR CONTRACTOR Stuart Rehfuss PHONE: Business Home 704-904-1664

ADDRESS 10208 Willingdon Rd. Huntersville, NC. 28078

LOCATION Ballyston Drive - 1100 TR Mayston's Mill TR White Horse TR Ballston on (L)

SUBDIVISION Point BLOCK / SECTION 4 LOT 478 LOT AREA ~1.3 Ac SITE CLASS PS DESIGN FLOW 480 L.T.A.R. .3

Septic Tank: 1500 Gallons; STB 338 Date 11/22/05
Pump Tank: 1500 Gallons; PT 477 Date 12/6/05
Pump Make: Zoeller Model W60-712 Serial No. L05683133
Nitrification Field: No Fields 1 Square Feet 1200 Linear Feet 333
No Lines 3 @ 111' Trench Width 3' Max Trench Bottom Depth 3' Gravel Depth NA

☒ New System ☐ Repair System Type: I, II, III, IV, V, VI
System Description: Pressured - 16" PPBPS
Repair System Description: Same as Recm
Maintenance Agreement Required: ☒ Yes ☐ No

☒ House/Mod. Home No. Bedrooms 4 ~~3~~ 5
☐ Mobile Home No. Bathrooms 4
☐ Business No. Employees
☐ Other
☐ Slab ☐ Crawl Space ☒ Basement w/plumbing ☐ Basement wo/plumbing


Water Supply: ☐ Individual ☐ Public ☒ Community Point

Comments/Conditions: Remove all terraces and berms before installation is started.


Comments/Conditions:

1" = 50'

INITIAL SITE SKETCH

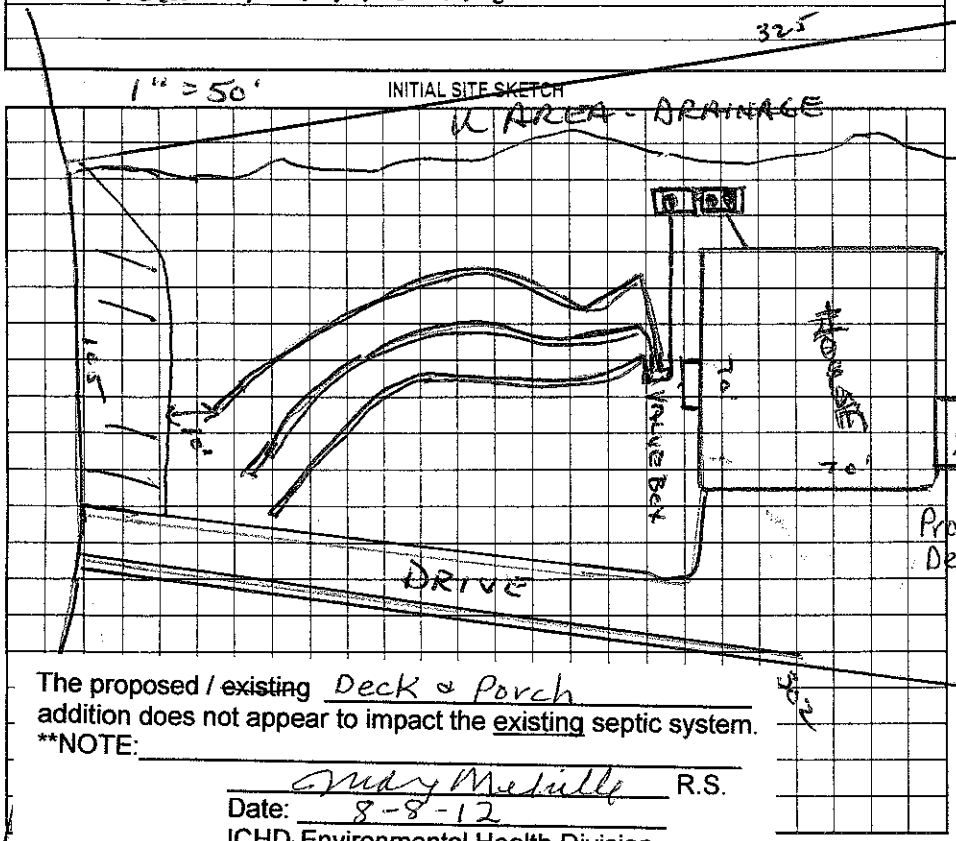

AS BUILT SKETCH

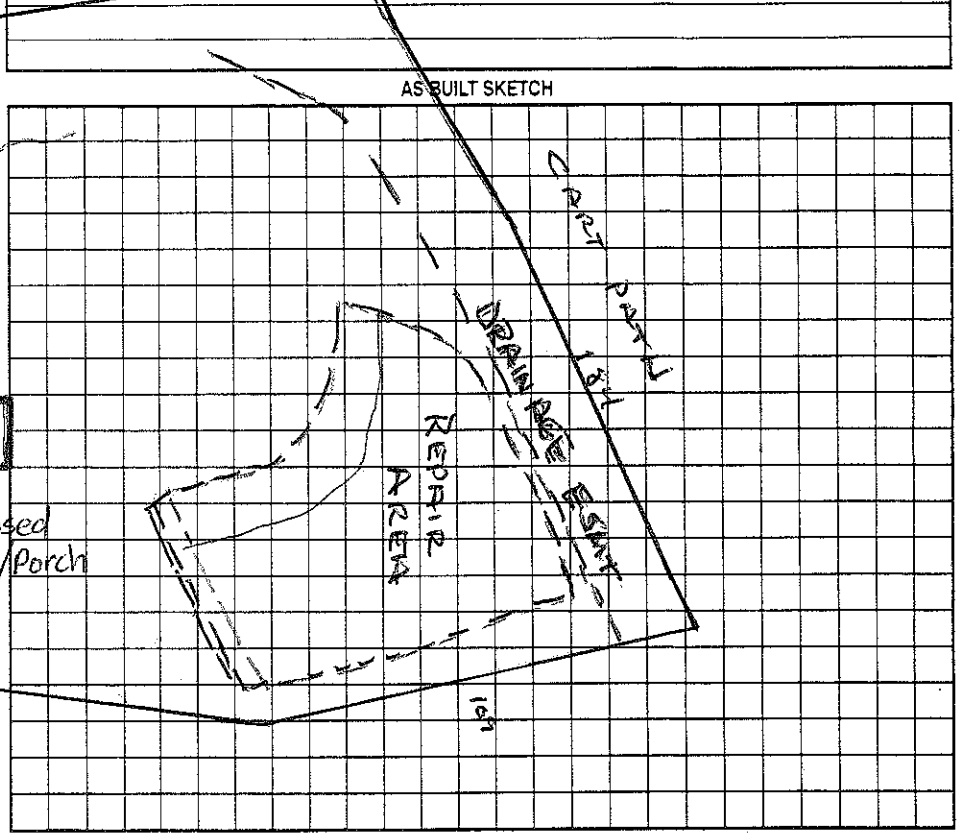

The proposed / ~~existing~~ Deck & Porch addition does not appear to impact the existing septic system.

**NOTE:

Andy Melville R.S.

Date: 8-8-12

ICHD-Environmental Health Division

Permit can be suspended or revoked if any false information is supplied toward securing the permit/any unauthorized changes are made to the site/any unauthorized changes are made in the installation of the system. Improvement Permit with plat valid without expiration. Improvement Permit with site plan valid for sixty months. Authorization to Construct is valid for a period equal to that of Improvement Permit – not to exceed sixty months.

Signed: Agent date 3/18/05

Improvement Permit by: Wesley Sparks R.S. date 3/17/05

Authorization to Construct by: Wesley Sparks R.S. date 3/17/05

Installed by: Hallman Const.

Operation Permit by: RS date 2/17/06

Existing System Inspection by: date

HEALTH DEPT. COPY: WHITE OWNER COPY (FINAL): YELLOW OWNER COPY (INITIAL): PINK