IREDELL COUNTY HEALTH DEPARTMENT

STATESVILLE 704-878-5305 MOORESVILLE 704-664-

IMPROVEMENT PERMIT / AUTHORIZATION TO CONSTRUCT / OPERATION PERMIT / EXISTING SYSTEM INSPEC

DATE 1/5/DEC

PERMIT# 1190001/82469 PIN# ~~4625941684 PT~~ 4625882974

OWNER OR CONTRACTOR CRESCENT RESOURCES / AUGUSTA HOMES PHONE: Business 663 6905 JACOBS Home

ADDRESS PO BOX 1003 CHARLOTTE NC 28202

LOCATION BRAWLEY SCHOOL J R MARSONS MILL - ON LT

SUBDIVISION POINT BLOCK / SECTION 4 LOT 485 LOT AREA .33880 SITE CLASS. PS DESIGN FLOW 480 GPD L.T.A.R. .3000/FT2

Septic Tank: 1000 + Gallons; STB 338 Date 8-17-04

Pump Tank: 1000 + Gallons; PT 283 Date 8-17-04

Pump Make: Model Serial No.

Nitrification Field: No Fields 1 Square Feet 1200 Linear Feet 400

No Lines 5@80' Trench Width 36" Max Trench Bottom Depth 36" Gravel Depth N/A

☑ New System ☐ Repair System Type: I, II, III, IV, V, VI

System Description: PUMP 25% REDUCTION PUMP PANEL

Repair System Description:

Maintenance Agreement Required: ☐ Yes ☑ No

☑ House/Mod. Home ☐ Mobile Home ☐ Business ☐ Other

No. Bedrooms 4 No. Bathrooms 4 No. Employees

☐ Slab ☑ Crawl Space ☐ Basement w/plumbing ☐ Basement wo/plumbing


Water Supply: ☐ Individual ☐ Public ☑ Community

Comments:/Conditions: REMOVE ALL TERRACES AND BERMS

* Drive on other side.

Comments:/Conditions: Checked tanks & lines 9/21/04 MD

INITIAL SITE SKETCH 1"=50'

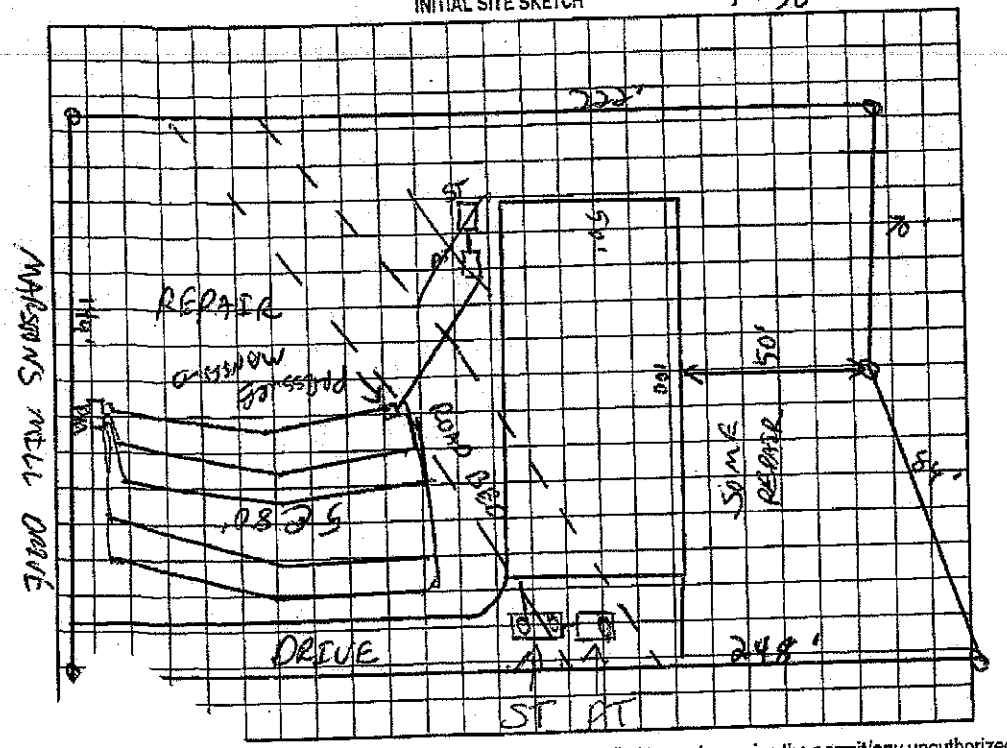

AS BUILT SKETCH

The proposed / existing Pool addition does not appear to impact the existing septic system.

**NOTE: Pool Must Be 15' From TANKS

R.S. 207405

Date: APPROVED DEC 29 2014

ICHD-Environmental Health Division


or revoked if any false information is supplied toward securing the permit/any unauthorized changes are made to the site/any unauthorized changes are made in the installation of the system. Improvement expiration. Improvement Permit with site plan valid for sixty months. Authorization to Construct is valid for a period equal to that of Improvement Permit – not to exceed sixty months.

date 12-21-04 Installed by: R & H Inc Wesley Sparks RS date 12/30/04

RS date 1/5/00 Operation Permit by: date

Sparks RS date 1/5/04 Existing System Inspection by: date

HEALTH DEPT. COPY: WHITE OWNER COPY (FINAL): YELLOW OWNER COPY (INITIAL): PINK

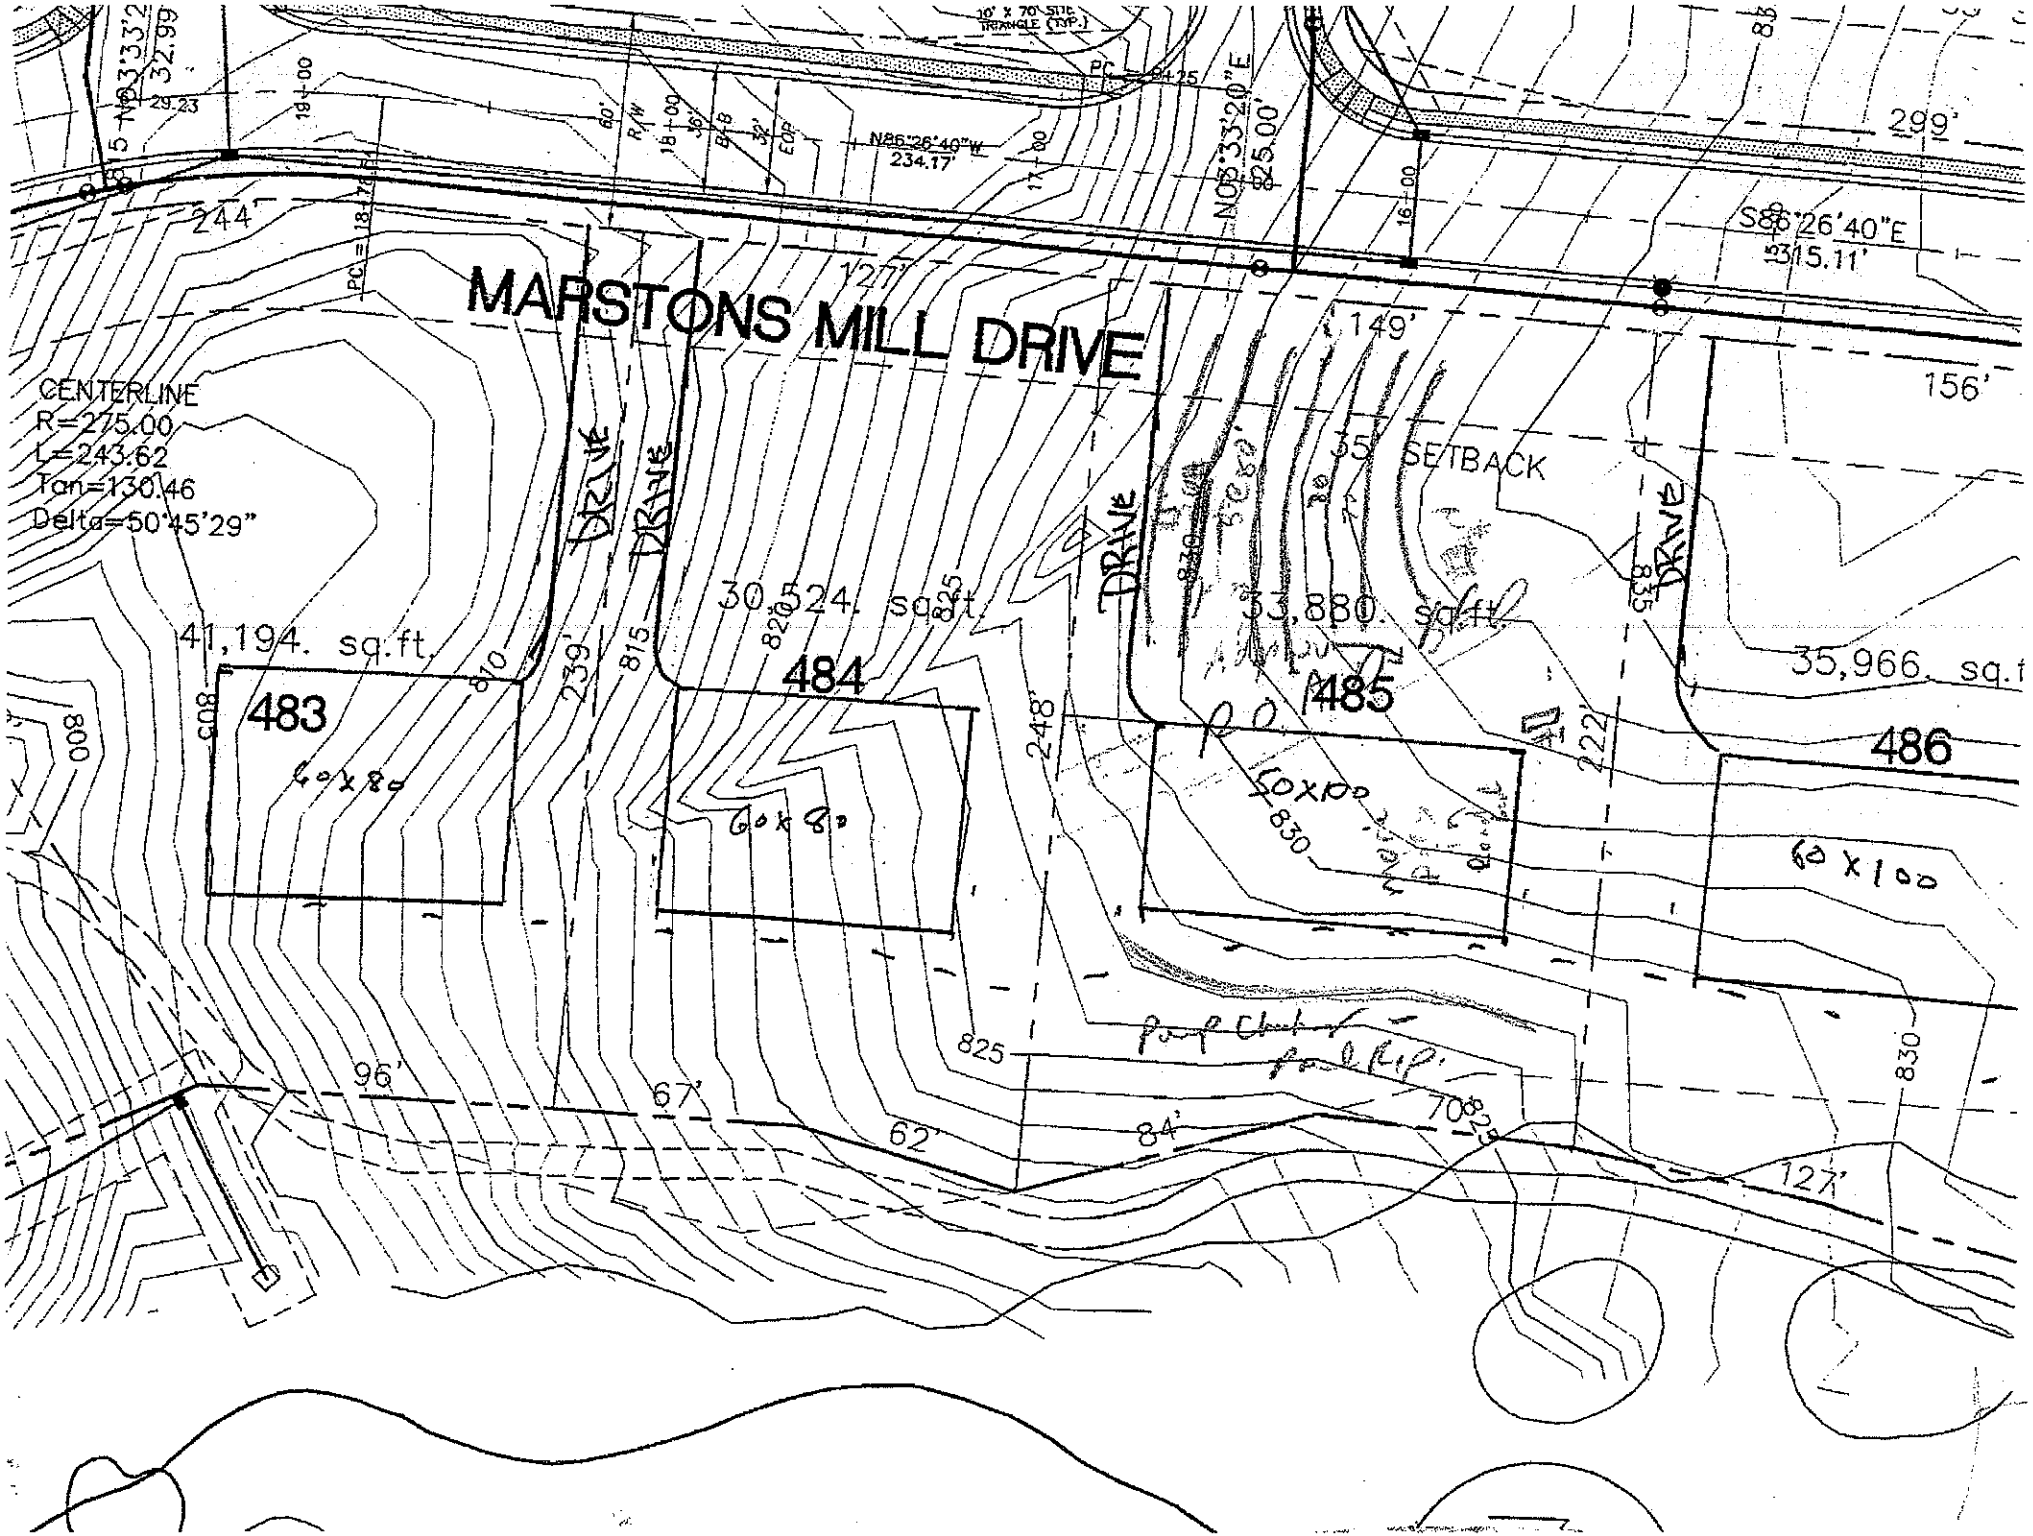
MARSTONS MILL DRIVE
CENTERLINE
R=275.00
L=243.62
Tan=130.46
Delta=50°45'29"
483
484
485
486
41,194. sq.ft.
30,524. sq.ft.
33,880. sq.ft.
35,966. sq.f
60x80
60x80
60x100
60 x 100
35' SETBACK
DRIVE
DRIVE
DRIVE
DRIVE
N86°26'40"W
234.17'
S86°26'40"E
315.11'
N03°33'20"E
325.00'
244'
127'
149'
156'
299'
248'
222'
96'
67'
62'
84'
70'
127'
825
830
Pool Ctr
Pool Ctr.