IREDELL COUNTY HEALTH DEPARTMENT

STATESVILLE 704-878-5305 MOORESVILLE 704-664-

IMPROVEMENT PERMIT / AUTHORIZATION TO CONSTRUCT / OPERATION PERMIT / EXISTING SYSTEM INSPEC

DATE 1/5/

PERMIT# 119000 / 82469 PIN# 4625941684 PT 4625882974

OWNER OR CONTRACTOR CRESCENT RESOURCES / AUGUSTA HOMES PHONE: Business 663 6905 JACOBS Home

ADDRESS PO BOX 1003 CHARLOTTE NC 28202

LOCATION BRAWLEY SCHOOL TR MARSTONS MILL - ON LT

SUBDIVISION POINT BLOCK / SECTION 4 LOT 485 LOT AREA 33880 SITE CLASS. PS DESIGN FLOW 480 GPD L.T.A.R. .3000/FT2

Septic Tank: 1000 + Gallons; STB 338 Date 8-17-04

Pump Tank: 1000 T Gallons; PT 283 Date 8-17-04

Pump Make: Model Serial No.

Nitrification Field: No Fields 1 Square Feet 1200 Linear Feet 400

No Lines 5@80' Trench Width 36" Max Trench Bottom Depth 36" Gravel Depth N/A

☑ New System ☐ Repair System Type: I, II, III, IV, V, VI

System Description: PUMP 25% REDUCTION

Repair System Description: PUMP PANEL

Maintenance Agreement Required: ☐ Yes ☑ No

☑ House/Mod. Home No. Bedrooms 4

☐ Mobile Home No. Bathrooms 4

☐ Business No. Employees

☐ Other

☐ Slab ☑ Crawl Space ☐ Basement w/plumbing ☐ Basement wo/plumbing


Water Supply: ☐ Individual ☐ Public ☑ Community

Comments:/Conditions: REMOVE ALL TERRACES AND BERMS


* Drive on other side.

Comments:/Conditions: Checked tanks & lines 9/21/04 MA

INITIAL SITE SKETCH 1"=50'

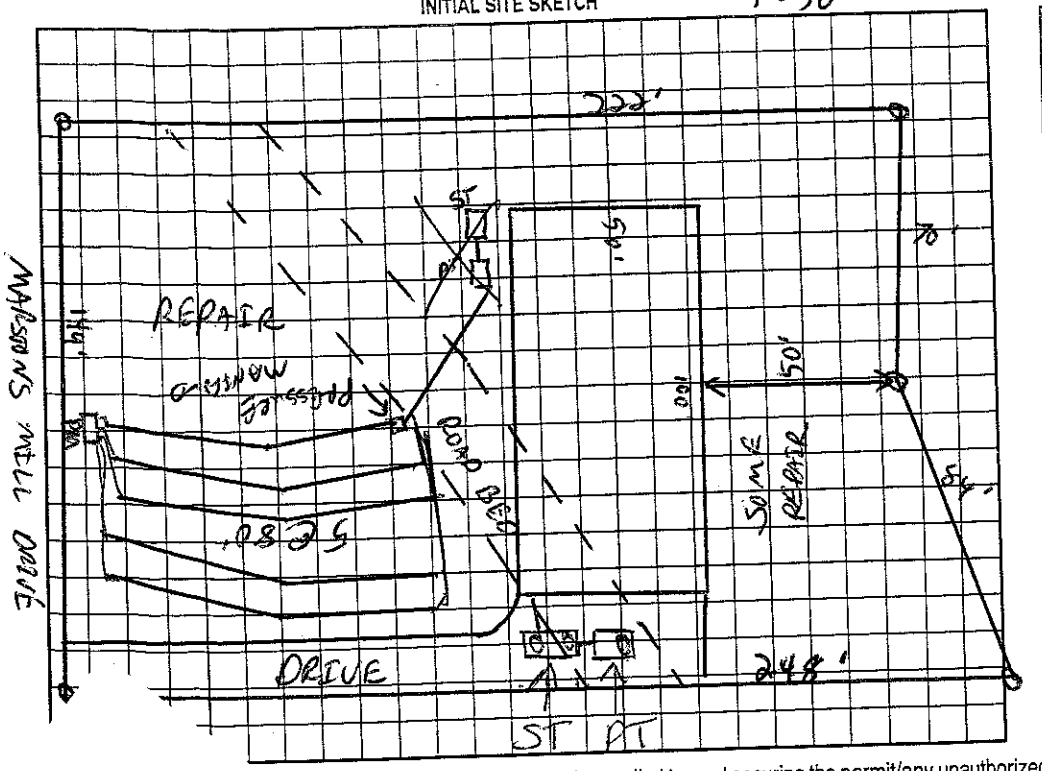

AS BUILT SKETCH

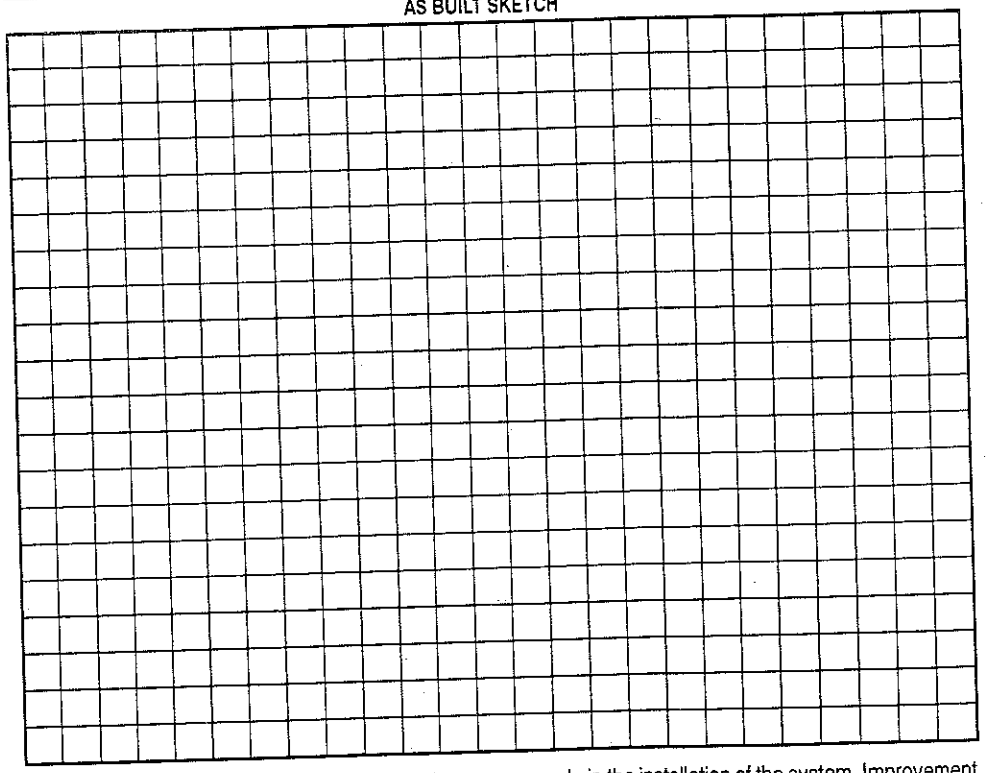

...or revoked if any false information is supplied toward securing the permit/any unauthorized changes are made to the site/any unauthorized changes are made in the installation of the system. Improvement ...expiration. Improvement Permit with site plan valid for sixty months. Authorization to Construct is valid for a period equal to that of Improvement Permit – not to exceed sixty months.

date 1-21-00

date 1/5/00

date 1/5/04

Installed by: R & H INC

Operation Permit by: Wesley Sparks RS date 12/30/04

Existing System Inspection by: date

HEALTH DEPT. COPY: WHITE OWNER COPY (FINAL): YELLOW OWNER COPY (INITIAL): PINK