2:00

IREDELL COUNTY HEALTH DEPARTMENT

STATESVILLE 704-878-5305 MOORESVILLE 704-664-5281

IMPROVEMENT PERMIT / AUTHORIZATION TO CONSTRUCT / OPERATION PERMIT / EXISTING SYSTEM INSPECTION

PERMIT# 82459 PIN# 4625 94 1684 PT 4625-88-4254 DATE 1/4/00

OWNER OR CONTRACTOR CRESCENT RESOURCES / Cornerstone PHONE Business 663-6905 JACOBS Home

ADDRESS PO BOX 1003 CHARLOTTE NC 28202

LOCATION BRAWLEY SCHOOL TL MARSDONS MILL TL WHITE HORSE TL BALLSTON ON LT

SUBDIVISION POINT BLOCK / SECTION 4 LOT 476 LOT AREA 4.33 SITE CLASS. PS DESIGN FLOW 480GPD L.T.A.R. ~, 300 PD/FT²

Septic Tank: ~~1000~~ Gallons; STB 338 Date 12-7-01

Pump Tank: 150 Gallons; PT Date

Pump Make: Model Serial No. 440

Nitrification Field: No Fields 1 Square Feet 1320 Linear Feet ~~1320~~

No Lines 4@110' Trench Width 36" Max Trench Bottom Depth 36" Gravel Depth NA

☑ New System ☐ Repair System Type: I, II, III, IV, V, VI

System Description: GRAVITY 25% REDUCTION

Repair System Description: LP PANEL

Maintenance Agreement Required: ☐ Yes ☑ No

☑ House/Mod. Home No. Bedrooms 4

☐ Mobile Home No. Bathrooms 4

☐ Business No. Employees

☐ Other


☐ Slab ☐ ~~Crawl Space~~ ☐ Basement w/plumbing ☐ Basement wo/plumbing

Water Supply: ☐ Individual ☐ Public ☐ ~~Community~~


Comments:/Conditions: REMOVE ALL TERRACES AND BERMS.
2/9/01 - Reviewed plans, substantially comply with I.P. Auth

Comments:/Conditions: Installed EZ flow Drainlines. Filter installed.

INITIAL SITE SKETCH 1" = 50'

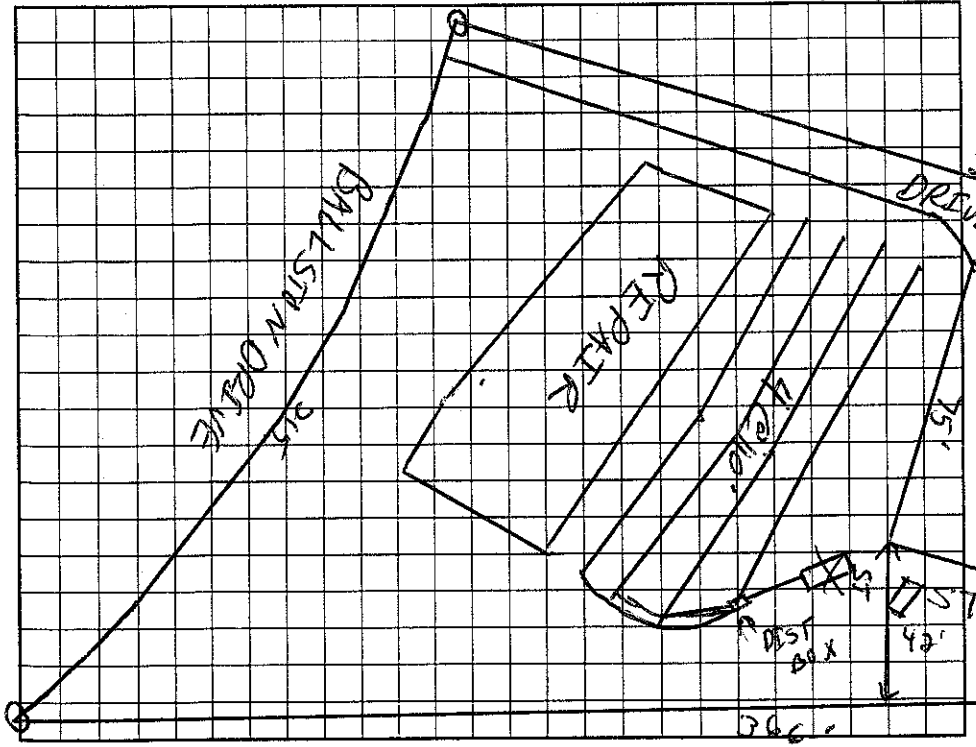

AS BUILT SKETCH

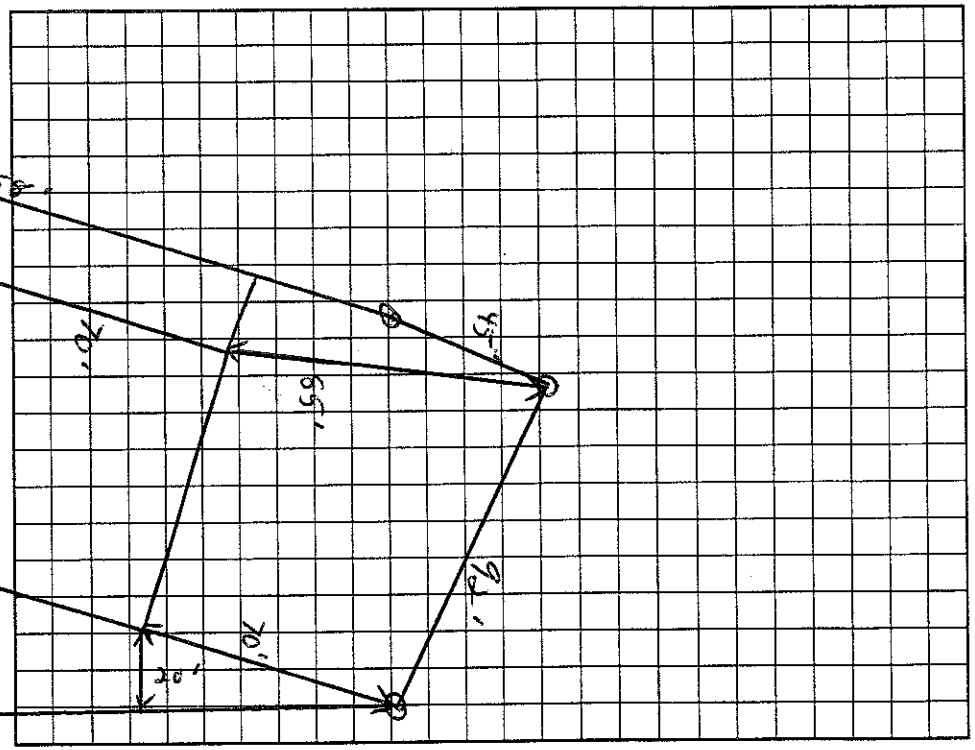

Permit can be suspended or revoked if any false information is supplied toward securing the permit/any unauthorized changes are made to the site/any unauthorized changes are made in the installation of the system. Improvement Permit with plat valid without expiration. Improvement Permit with site plan valid for sixty months. Authorization to Construct is valid for a period equal to that of Improvement Permit – not to exceed sixty months.

Signed: date 1-21-00

Improvement Permit by: RS date 1/4/00

Authorization to Construct by: Wesley Sparks RS. date 2/9/01

Installed by: R&H Inc RS

Operation Permit by: Maria Dalton date 1/18/2001

Existing System Inspection by: date

HEALTH DEPT. COPY: WHITE OWNER COPY (FINAL): YELLOW OWNER COPY (INITIAL): PINK