IREDELL COUNTY HEALTH DEPARTMENT

STATESVILLE 704-878-5305 250.00 Paid MOORESVILLE 704-664-5281

IMPROVEMENT PERMIT / AUTHORIZATION TO CONSTRUCT / OPERATION PERMIT / EXISTING SYSTEM INSPECTION

PERMIT# 82458 PIN# 4625941684 PT 4625-88-5199 DATE 10/31/2000

OWNER OR CONTRACTOR Crescent Resources / Hughes & Assoc. PHONE: Business 542-6816 Home

ADDRESS PO Box 1003 Charlotte, NC 28207

LOCATION Brawley School TR, Marstons Mill TL, White Horse TL, Ballston TL, Billingsgate CN

SUBDIVISION The Point BLOCK / SECTION 4 LOT 475 LOT AREA 39,355 SITE CLASS. PS DESIGN FLOW 720 gpd L.T.A.R. .3 4 corner

Septic Tank: 1500 Gallons; STB 338 Date 3-25-01

Pump Tank: 1500 Gallons; PT 338 Date 3-21-01

Pump Make: Model Serial No.

Nitrification Field: No Fields 1 Square Feet 1200' Linear Feet 400'

No Lines 4 at 100' Trench Width 36" Max Trench Bottom Depth 30" Gravel Depth N/A

☒ New System ☐ Repair System Type: I, II, III, IV, V, VI

System Description: Pump-LP-Panel Blk

Repair System Description: Same

Maintenance Agreement Required: ☒ Yes ☐ No

☒ House/Mod. Home ☐ Mobile Home ☐ Business ☐ Other

No. Bedrooms 6 No. Bathrooms 5.5 No. Employees


☐ Slab ☐ Crawl Space ☐ Basement w/plumbing ☐ Basement wo/plumbing

Water Supply: ☐ Individual ☒ Public ☐ Community


Comments:/Conditions: Remove all terraces and berms.
*Okay to "Center Feed" drainlines instead.

Comments:/Conditions: *50% Reduction in Drainfield area.
Installed as Drawn
Recheck tree-Moore okay 7/18/2001 MD

INITIAL SITE SKETCH Scale 1":50'

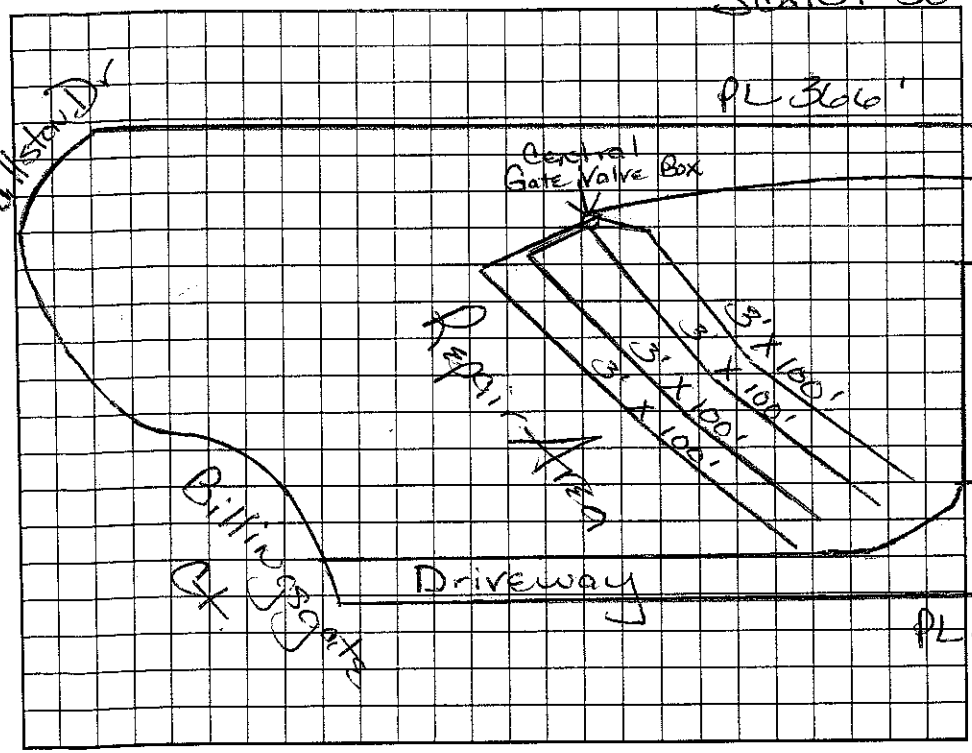

AS BUILT SKETCH

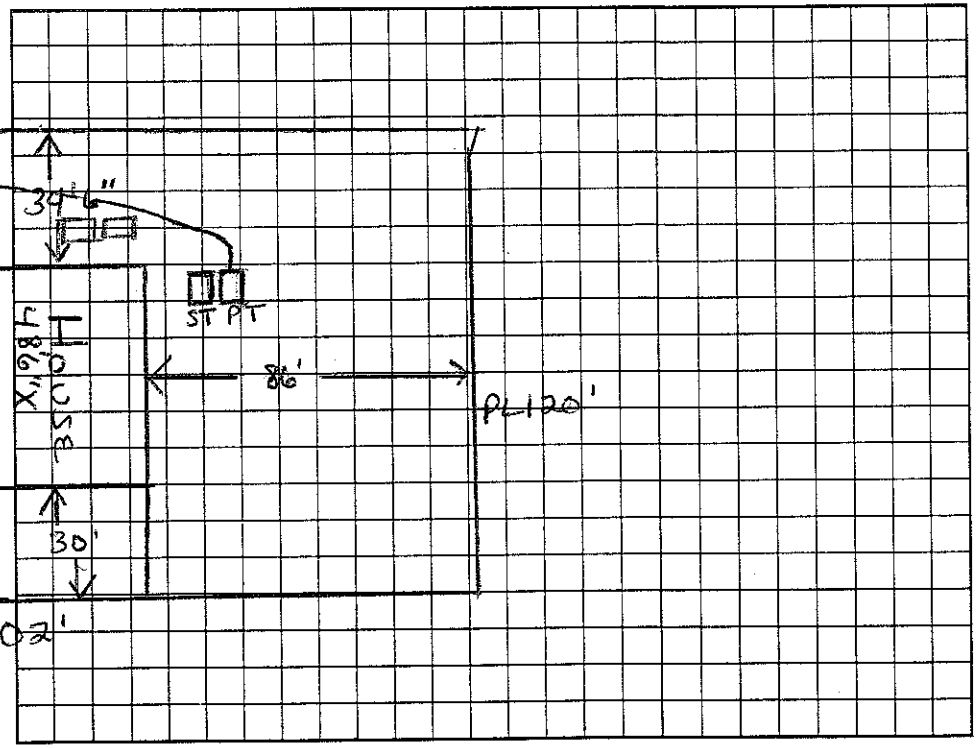

Permit can be suspended or revoked if any false information is supplied toward securing the permit/any unauthorized changes are made to the site/any unauthorized changes are made in the installation of the system. Improvement Permit with plat valid without expiration. Improvement Permit with site plan valid for sixty months. Authorization to Construct is valid for a period equal to that of Improvement Permit – not to exceed sixty months.

Signed: [signature] date 11-3-2000 Installed by: R&H

Improvement Permit by: Maria H. Dotson RS date 11/1/2000 Operation Permit by: Maria H. Dotson date 7/18/2001

Authorization to Construct by: Maria H. Dotson RS date 11/1/2000 Existing System Inspection by: date

HEALTH DEPT. COPY: WHITE OWNER COPY (FINAL): YELLOW OWNER COPY (INITIAL): PINK