COPY

IREDELL COUNTY HEALTH DEPARTMENT

STATESVILLE 704-878-5305 MOORESVILLE 704-664-5281

IMPROVEMENT PERMIT / AUTHORIZATION TO CONSTRUCT / OPERATION PERMIT / EXISTING SYSTEM INSPECTIO

PERMIT# 82471 PIN# 4625 94 1684 4625-88-6934 DATE 3/31/03

OWNER OR CONTRACTOR Tom Stevenson Bldg. Co. PHONE: Business 704-660-6638 Home

ADDRESS 631 Brawley School Rd, Mooresville, NC 28117

LOCATION 1100 TR Marstons Mill on (L)

SUBDIVISION Point BLOCK / SECTION 4 LOT 487 LOT AREA 39649 SITE CLASS PS DESIGN FLOW 480 L.T.A.R. .3

Septic Tank: 1500 Gallons; STB 338 Date 1-6-03
Pump Tank: 1000 Gallons; PT 283 Date 7-5-03
Pump Make: Model Serial No.
Nitrification Field: No Fields 1 Square Feet 1200 Linear Feet 400
No Lines 4 @ 100' Trench Width 3' Max Trench Bottom Depth 3'

[X] New System [ ] Repair System Type: I II (III) IV V VI
System Description: PM — 25% Reduced
Repair System Description: 16" PPBPS
Maintenance Agreement Required: [ ] Yes [X] No


[X] House/Mod. Home No. Bedrooms 4
[ ] Mobile Home No. Bathrooms 3.5
[ ] Business No. Employees
[ ] Other
Gravel Depth NA [ ] Slab [X] Crawl Space [ ] Basement w/plumbing [ ] Basement wo/plumbing

Water Supply: [ ] Individual [ ] Public [X] Community

Comments:/Conditions:

Comments:/Conditions: Note: Spaced out drainlines to meet 10' Setback to water meter. Tanks Checked 8/13/03

INITIAL SITE SKETCH (1" = 50')

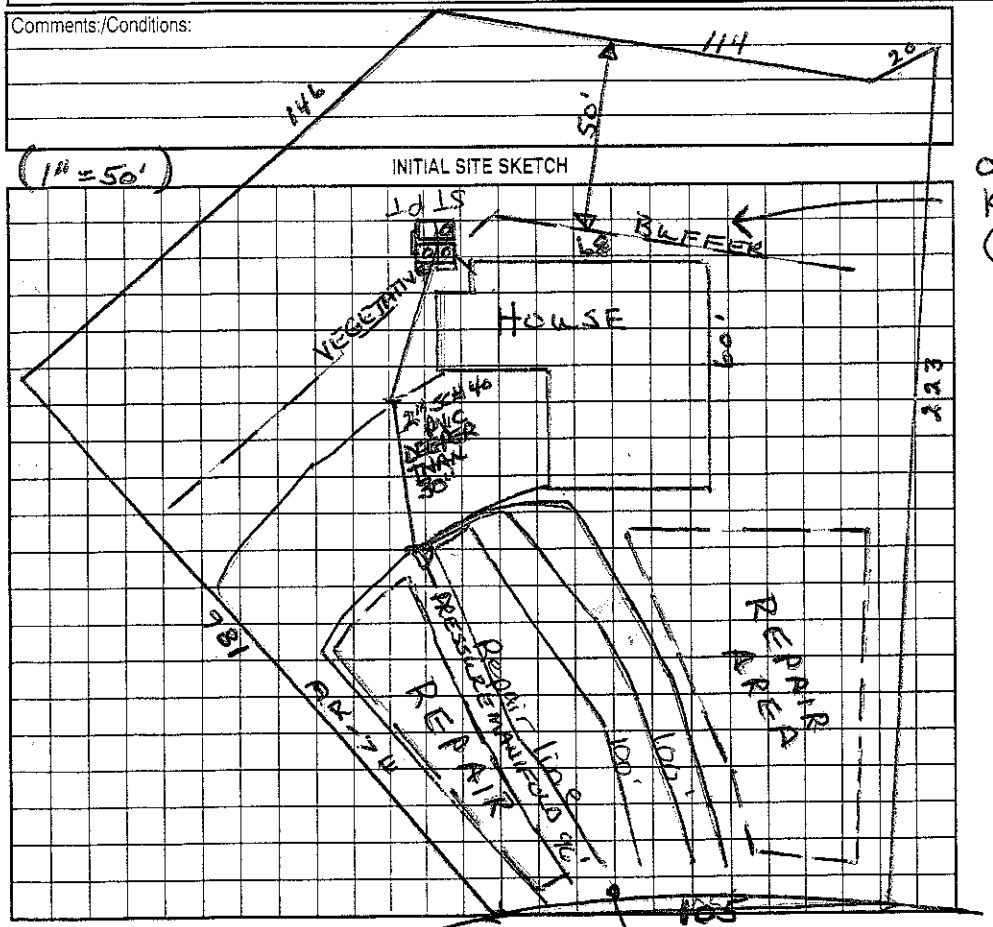

AS BUILT SKETCH

OUTDOOR KITCHEN (SEE ATTACHED)

EZ Flow Drainfield Installed 7/8/03

The proposed / existing OUTDOOR KITCHEN addition does not appear to impact the existing septic system.
**NOTE:
REHS
Date: 5-25-14
ICHD-Environmental Health Division

Permit can be suspended or revoked if any false information is supplied toward securing the permit/any unauthorized changes are made to the site/any unauthorized changes are made in the installation of the system. Improvement Permit with plat valid without expiration. Improvement Permit with site plan valid for sixty months. Authorization to Construct is valid for a period equal to that of Improvement Permit – not to exceed sixty months.

Signed: Dan Russell date
Improvement Permit by: Wesley Sparks RS date 3/31/03
Authorization to Construct by: Wesley Sparks RS date 3/31/03

Installed by: R & H Inc
Operation Permit by: RS date 11/12/03
Existing System Inspection by: date

HEALTH DEPT. COPY: WHITE OWNER COPY (FINAL): YELLOW OWNER COPY (INITIAL): PINK