DELL COUNTY HEALTH DEPARTMENT

STATESVILLE 704-878-5305 MOORESVILLE 704-664-5281

ROVEMENT PERMIT / AUTHORIZATION TO CONSTRUCT / OPERATION PERMIT / EXISTING SYSTEM INSPECTION

# 82471	PIN# 4625 94 1684 4625-88-6934
DATE	3/31/03
OR CONTRACTOR	Tom Stevenson Bldg. Co.
PHONE: Business	704-660-6638
Home	
SS	631 Brawley School Rd, Mooresville, NC 28117
ON	1100 TR Marstons Mill on (L)
VISION	Point
BLOCK / SECTION	4
LOT	487
LOT AREA	39649
SITE CLASS.	PS
DESIGN FLOW	480
L.T.A.R.	.3

Tank: 1500 Gallons; STB 338 Date 1-6-03
Tank: 1000 Gallons; PT 283 Date 7-5-03
Make: Model Serial No.
cation Field: No Fields 1 Square Feet 1200 Linear Feet 400
nes 4 @ 100' Trench Width 3' Max Trench Bottom Depth 3' Gravel Depth NA

☒ New System ☐ Repair System Type: I II (III) IV V VI
System Description: PM – 25% Reduced
Repair System Description: 16" PPBPS
Maintenance Agreement Required: ☐ Yes ☒ No

☒ House/Mod. Home ☐ Mobile Home ☐ Business ☐ Other
No. Bedrooms 4 No. Bathrooms 3.5 No. Employees


Water Supply: ☐ Individual ☐ Public ☒ Community

☐ Slab ☒ Crawl Space ☐ Basement w/plumbing ☐ Basement wo/plumbing

ents:/Conditions:

Comments:/Conditions: Note: Spaced out drainlines to meet 10' Setback to water meter. Tanks Checked 8/13/03

INITIAL SITE SKETCH

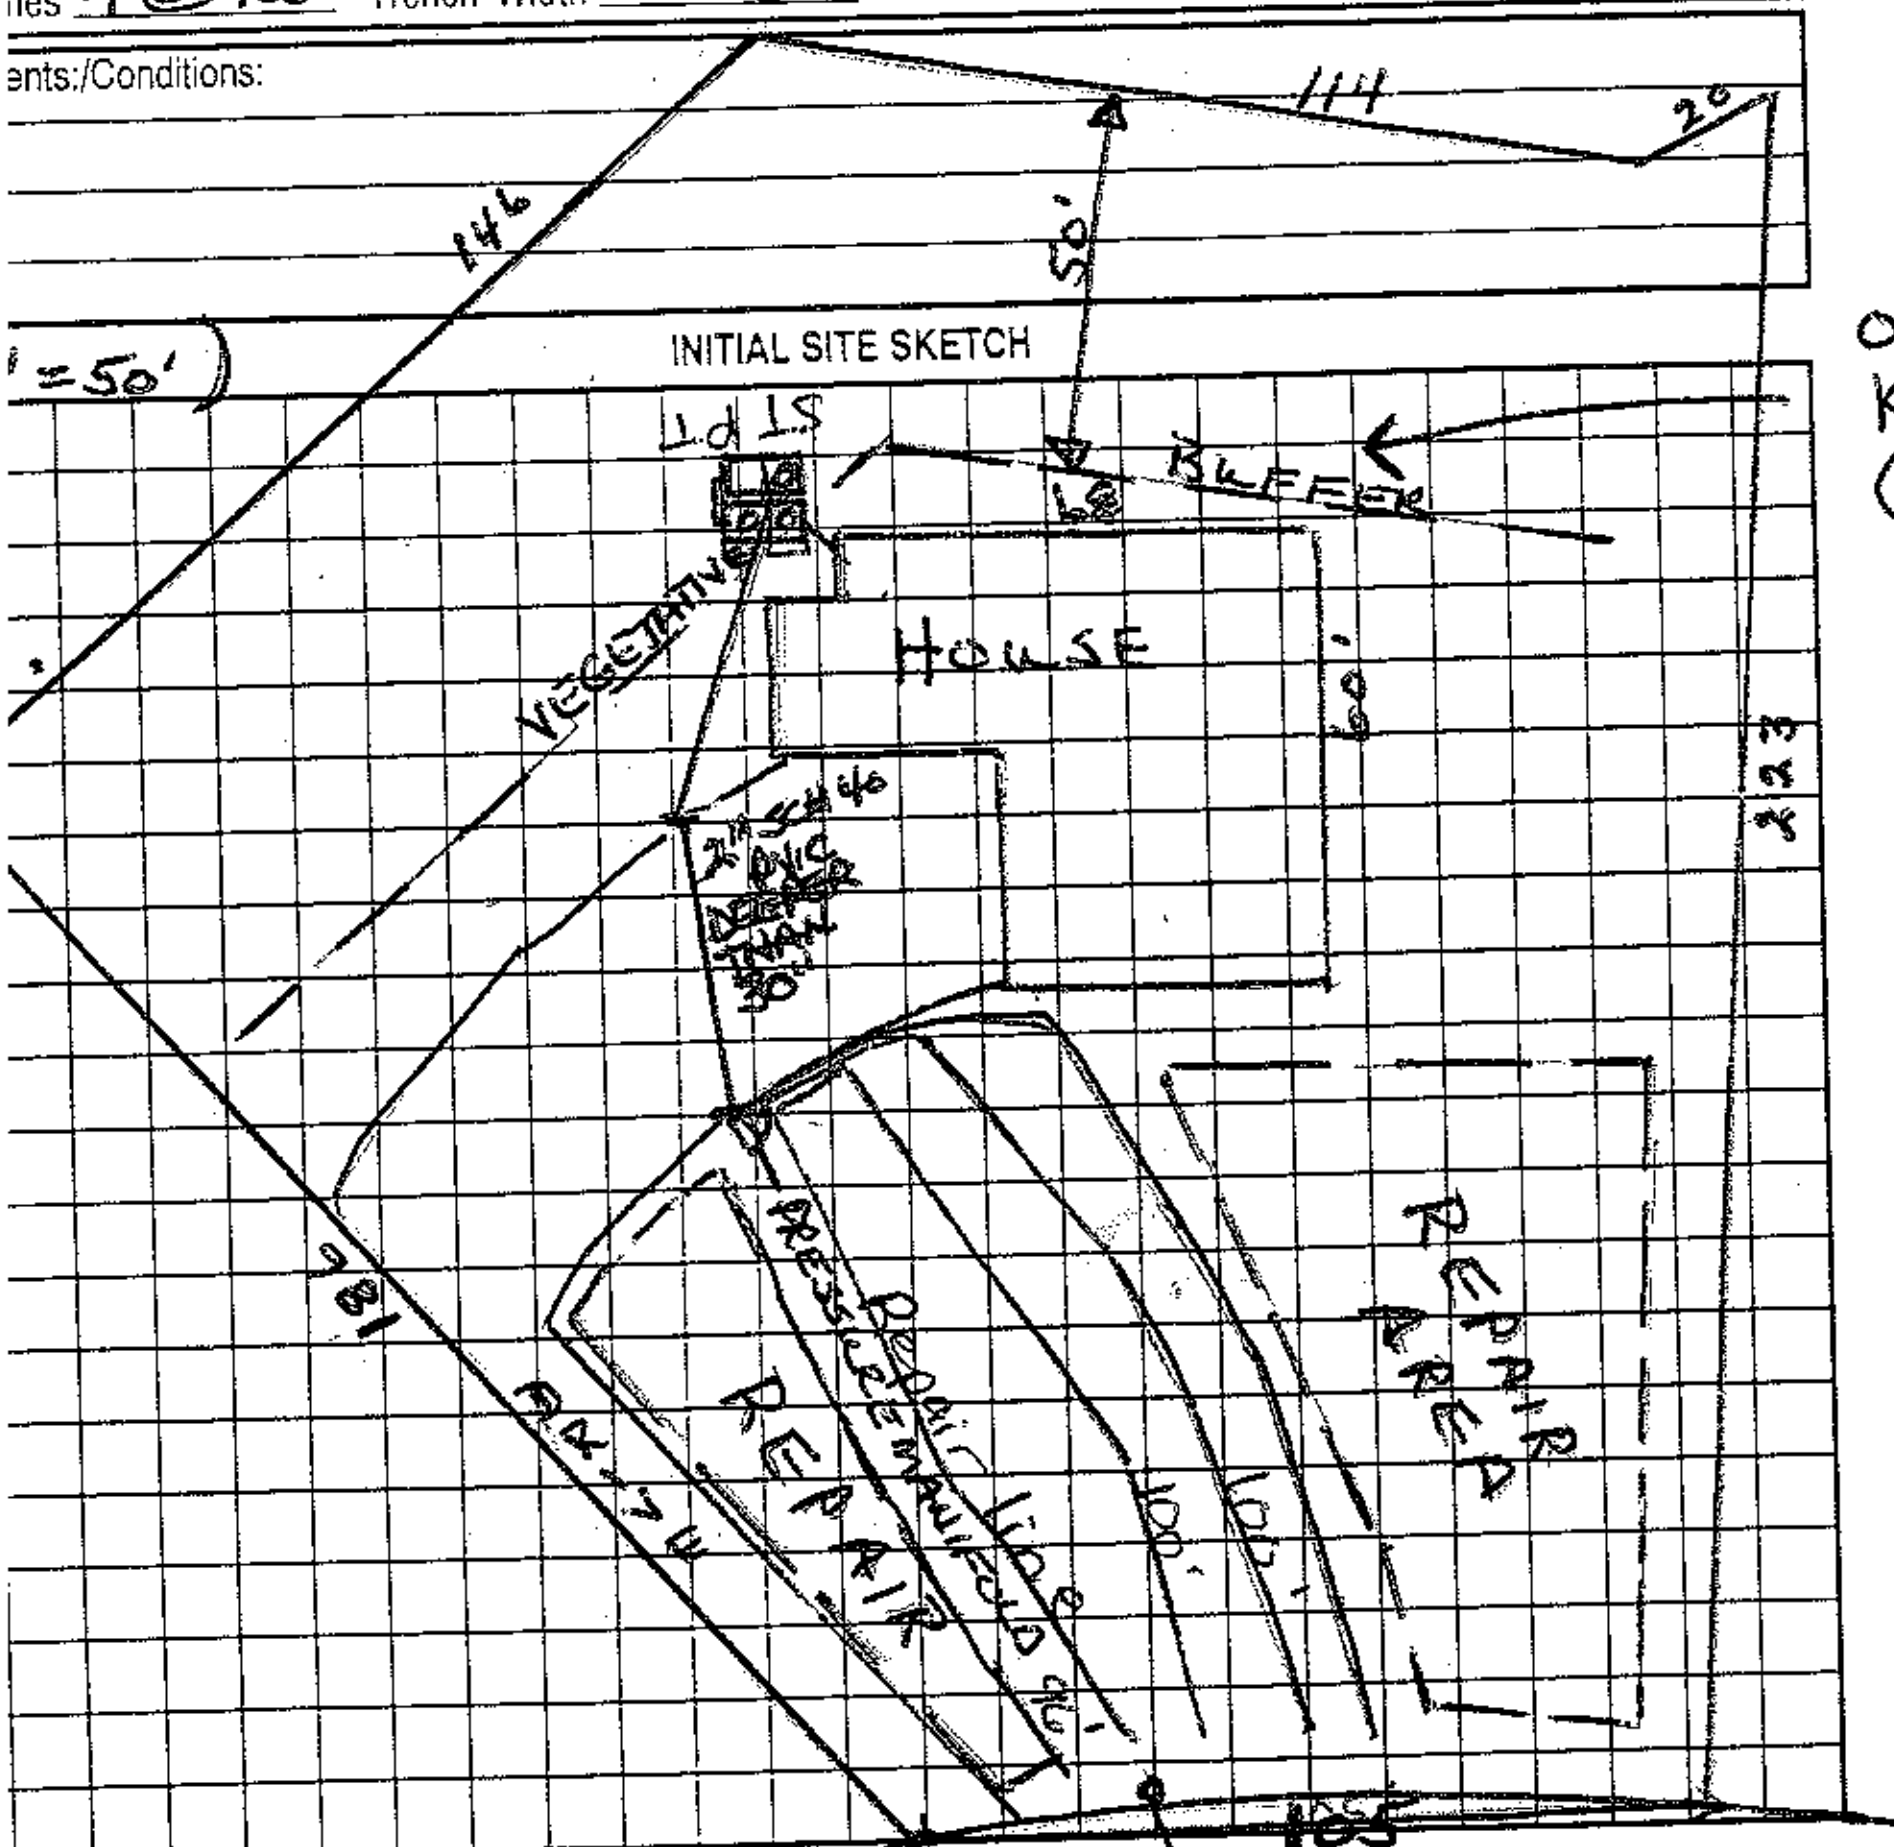

AS BUILT SKETCH

OUTDOOR KITCHEN (SEE ATTACHED)

EZ Flow Drainfield Installed 7/8/03

The proposed / existing OUTDOOR KITCHEN addition does not appear to impact the existing septic system.
**NOTE: REHS
Date: 5-25-14
ICHD-Environmental Health Division

mit can be suspended or revoked if any false information is supplied toward securing the permit/any unauthorized changes are made to the site/any unauthorized changes are made in the installation of the system. Improvement mit can be suspended or revoked if any false information is supplied toward securing the permit/any unauthorized changes are made to the site/any unauthorized changes are made in the installation of the system. Improvement Permit with site plan valid for sixty months. Authorization to Construct is valid for a period equal to that of Improvement Permit – not to exceed sixty months.
mit with plat valid without expiration.

ned: * Don Russell date
provement Permit by: Wesley Sparks RS date 3/31/03
Wesley Sparks RS date 3/31/03

Installed by: R & H Inc
Operation Permit by: RS date 11/12/03
Existing System Inspection by: date

PROPERTY ID #: