IREDELL COUNTY HEALTH DEPARTMENT

STATESVILLE 704-878-5305 MOORESVILLE 704-664-5281

IMPROVEMENT PERMIT / AUTHORIZATION TO CONSTRUCT / OPERATION PERMIT / EXISTING SYSTEM INSPECTION

PERMIT# 82457 PIN# 4625941684 PT 4625-88-7177 DATE 8/6/01

OWNER OR CONTRACTOR CRESCENT RESOURCES / AUGUSTA HOMES PHONE: Business 637-0845 Home

ADDRESS PO BOX 1003 CHARLOTTE NC 28202

LOCATION BRAWLEY SCHOOL - TR MARSTONS MILL - TL WHITE HORSE - TL BALLSTON - TL BELLEMEADE - AT END

SUBDIVISION THE POINT BLOCK / SECTION 4 LOT 474 LOT AREA 50,539 SITE CLASS PS DESIGN FLOW 480 GPD L.T.A.R. .3 GPD/FT²

Septic Tank: 1000 Gallons; STB 338 Date 7-2-01

Pump Tank: Gallons; PT Date

Pump Make: Model Serial No.

Nitrification Field: No Fields 1 Square Feet 1200 Linear Feet 400

No Lines 4@100' Trench Width 36" Max Trench Bottom Depth 36" Gravel Depth N/A

☑ New System ☐ Repair System Type: I, II, III, IV, V, VI

System Description: GRAVITY 25% REDUCTION

Repair System Description: GRADE CONVENTIONAL

Maintenance Agreement Required: ☐ Yes ☒ No

☒ House/Mod. Home ☐ Mobile Home ☐ Business ☐ Other

No. Bedrooms 4 No. Bathrooms 4 No. Employees

Water Supply: ☐ Individual ☐ Public ☒ Community

☐ Slab ☑ Crawl Space ☐ Basement w/plumbing ☐ Basement wo/plumbing


Comments:/Conditions:

Comments:/Conditions: Filter & Speed levelers Installed


1) WESLEY SHARKS REVIEWED PLANS FOR HOUSE ON 12/1/00

2) BUILDERS ELECTS TO CHANGE FROM CONVENTIONAL TO 25% REDUCTION.

1"=50' INITIAL SITE SKETCH

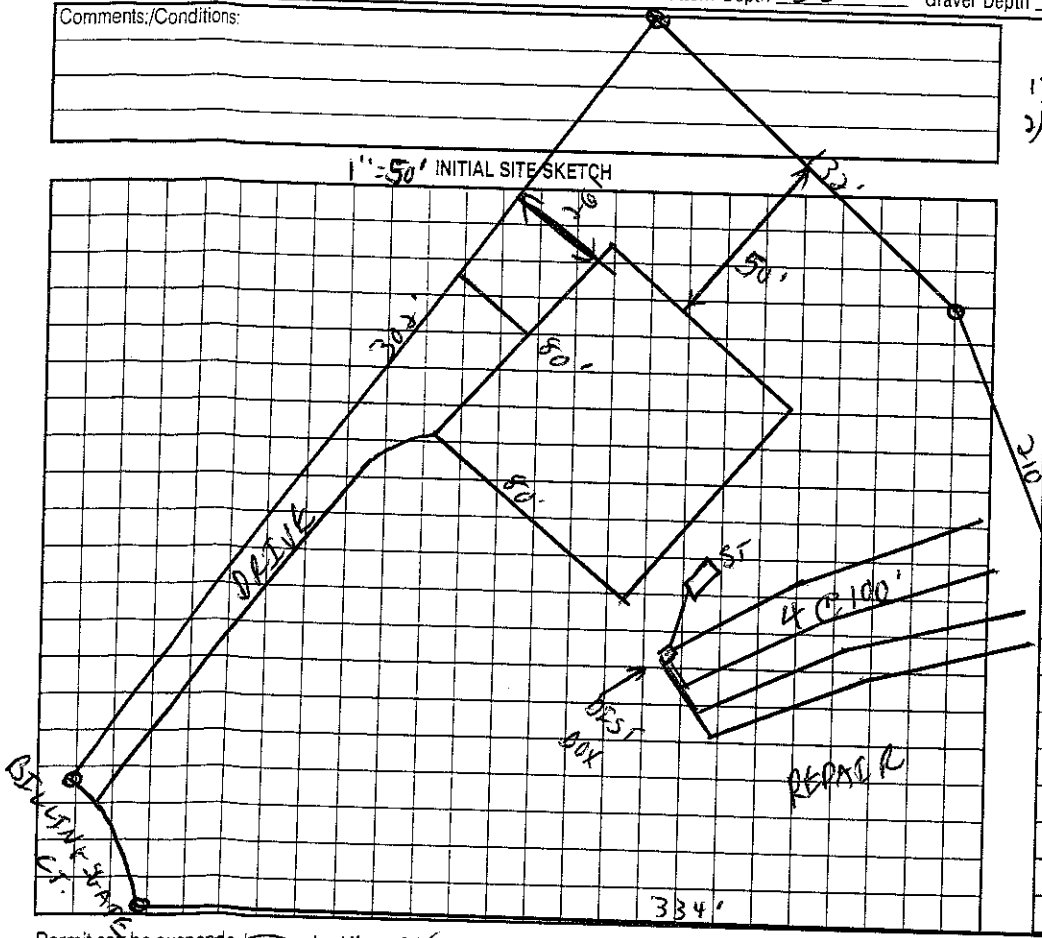

AS BUILT SKETCH

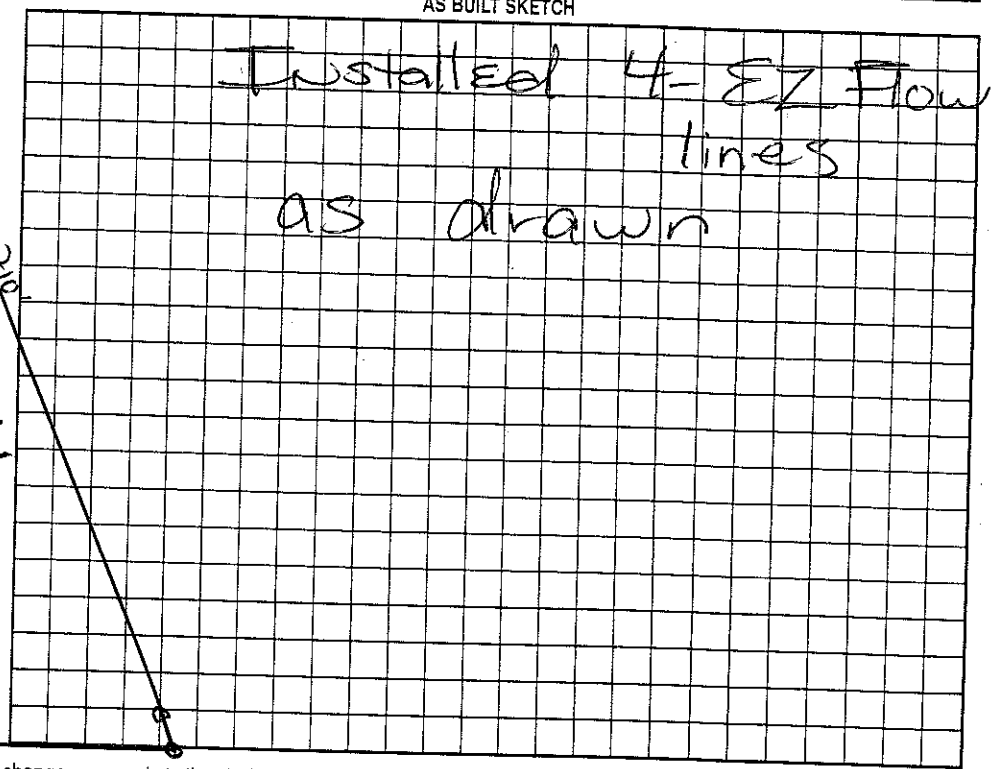

Permit can be suspended or revoked if any false information is supplied toward securing the permit/any unauthorized changes are made to the site/any unauthorized changes are made in the installation of the system. Improvement Permit with plat valid without expiration. Improvement Permit with site plan valid for sixty months. Authorization to Construct is valid for a period equal to that of Improvement Permit – not to exceed sixty months.

Signed: date

Improvement Permit by: C. Lyon RS date 8/6/01

Authorization to Construct by: C. Lyon RS date 8/6/01

Installed by: R & H Inc.

Operation Permit by: Marian Wilson RS date 8/7/2001

Existing System Inspection by: date

HEALTH DEPT COPY: WHITE OWNER COPY