IREDELL COUNTY HEALTH DEPARTMENT

STATESVILLE 704-878-5305 MOORESVILLE 704-664-5[illegible]

IMPROVEMENT PERMIT / AUTHORIZATION TO CONSTRUCT / OPERATION PERMIT / EXISTING SYSTEM [illegible]SPECTION

PERMIT# ~~81935~~ 81837 PIN# 462594684 PT 4625-89-1524 DATE 12/10/99

OWNER OR CONTRACTOR CRESCENT RESOURCES / Divest Custom PHONE: Business 663-6905 T JACOBS Home

ADDRESS PO Box 1003 CHARLOTTE NC 28202

LOCATION BRAWLEY SCHOOL - TR MARSTON MILL - TR MADDAKAT LOOP ON RT

SUBDIVISION POINT BLOCK / SECTION 4 LOT 385 LOT AREA 58471 ft² SITE CLASS. PS DESIGN FLOW 480gpl L.T.A.R. .3 gpl/ft²

Septic Tank: 1000 + Gallons; STB 338 Date 1-9-05
Pump Tank: 1000 + Gallons; PT 27 Date 1-8-05
Pump Make: Goulds Model WE0312M Serial No.
Nitrification Field: No Fields 1 Square Feet 1200 Linear Feet 400
No Lines 4@100' Trench Width 36" Max Trench Bottom Depth 30" Gravel Depth N/A

☑ New System ☐ Repair System Type: I, II, III, IV, V, VI
System Description: PUMP 25% REDUCTION
Repair System Description: PUMP SAME
Maintenance Agreement Required: ☐ Yes ☑ No

☑ House/Mod. Home No. Bedrooms 4
☐ Mobile Home No. Bathrooms 4
☐ Business No. Employees
☐ Other


☐ Slab ☑ Crawl Space ☐ Basement w/plumbing ☐ Basement wo/plumbing

Water Supply: ☐ Individual ☐ Public ☑ Community


Comments/Conditions: REMOVE ALL TERRACES AND BERMS

Comments/Conditions: Installed EZ-Flow drainfield as Drawn MS 1/3/05
Tanks checked 2/11/05

INITIAL SITE SKETCH 1"=50'

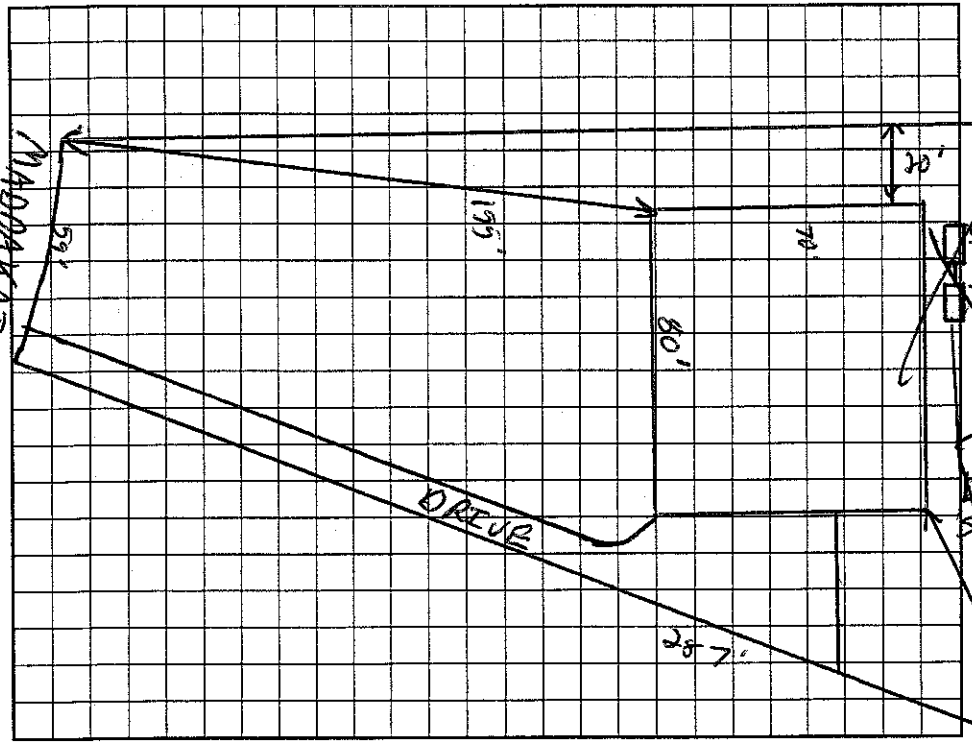

AS BUILT SKETCH

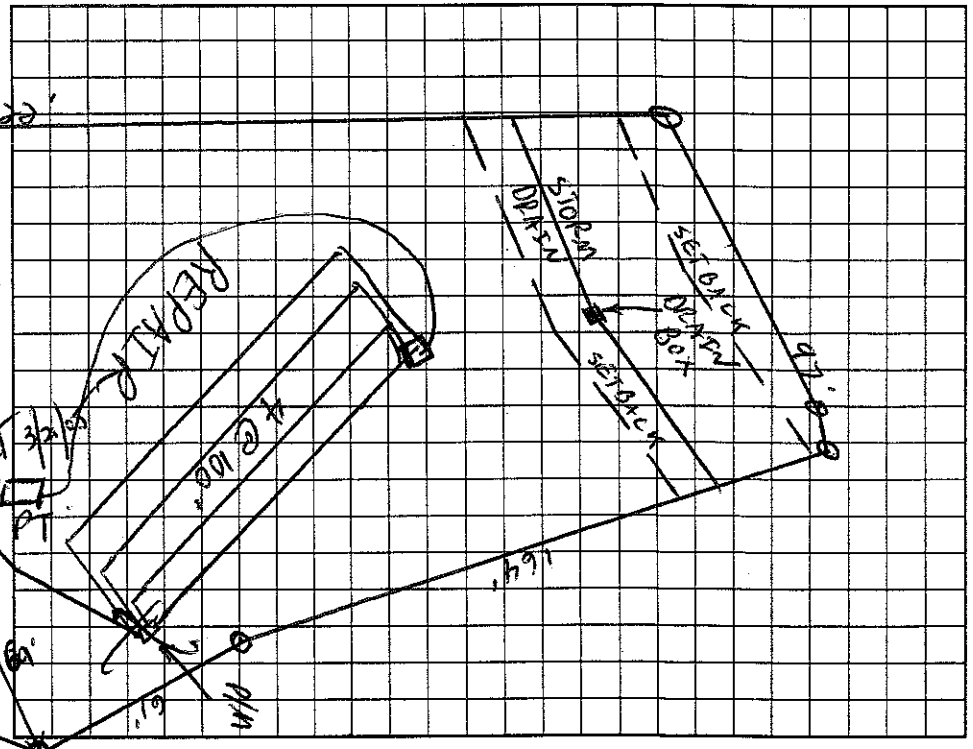

Permit can be suspended or revoked if any false information is supplied toward securing the permit/any unauthorized changes are made to the site/any unauthorized changes are made in the installation of the system. Improvement Permit with ~~plat valid without expiration~~. Improvement Permit with site plan valid for sixty months. Authorization to Construct is valid for a period equal to that of Improvement Permit – not to exceed sixty months.

Signed: [signature] date 1-21-00

Improvement Permit by: C. Bateman RS date 12/10/99

Authorization to Construct by: [signature] RS date 6/8/04

Installed by: R. Hall RS

Operation Permit by: Maria H. Dotson date 3/21/05

Existing System Inspection by: date

HEALTH DEPT. COPY: WHITE OWNER COPY (FINAL): YELLOW OWNER COPY (INITIAL): PINK