IREDELL COUNTY HEALTH DEPARTMENT

Statesville Office (704) 878-5305 Mooresville Office (704) 660-3625 PERMIT # 177810

IMPROVEMENT PERMIT / AUTHORIZATION TO CONSTRUCT / OPERATION PERMIT / EXISTING SYSTEM

PIN # 4625891524

APPLICANT: [illegible] APPLICANT ADDRESS: [illegible]

SITE ADDRESS: [illegible] PHONE: [illegible] ALT. PHONE: [illegible]

SITE DIRECTIONS: [illegible]


SUBDIVISION: [illegible] SECTION: 4 LOT # 385 LOT AREA: [illegible] DESIGN FLOW: [illegible] L.T.A.R.: 3

Septic Tank 1500 (gal)	STB	Date	☐ New System ☐ Repair ☐ Expansion System Type: I II III IV V VI	☒ Residence	No. Bedrooms 4	Water Supply
Pump Tank 1050 (gal)	PT	Date	System Description: [illegible]	☐ Business	No. Persons	☐ Private
Pump Make	Model	Serial #	Repair System Description: [illegible]	☐ Other	No. Employees	☐ Public
# Nitrification Fields 1	# Lines 4	Linear Ft: 480	Maintenance Agreement Required: ☐ YES ☒ NO	☐ Slab	☒ Crawl Space	☒ Community
Trench Width 36	Max. Trench Bottom Depth [illegible]	Gravel Depth N/A	☐ GRAVITY ☐ PRESSURE	☐ Basement w/plumbing	☐ Basement w/o plumbing	


Comments / Conditions:

* Must keep pool at least 15ft from septic System

INITIAL SITE SKETCH

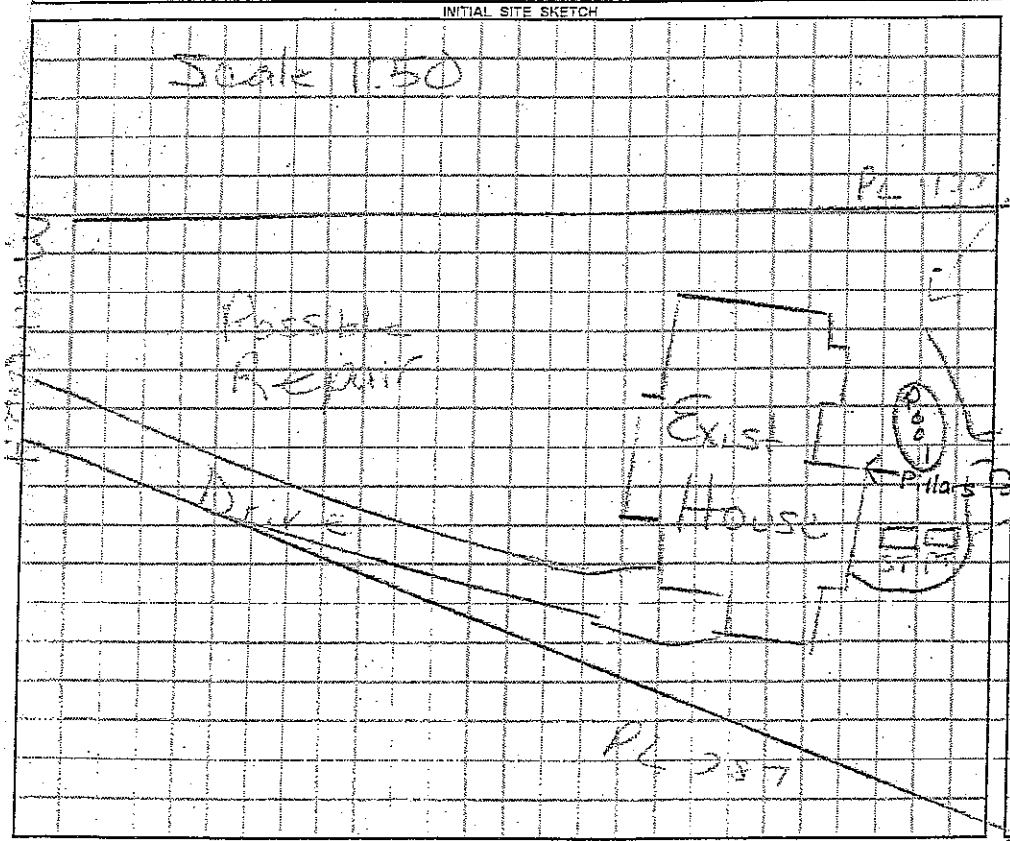

AS BUILT SKETCH

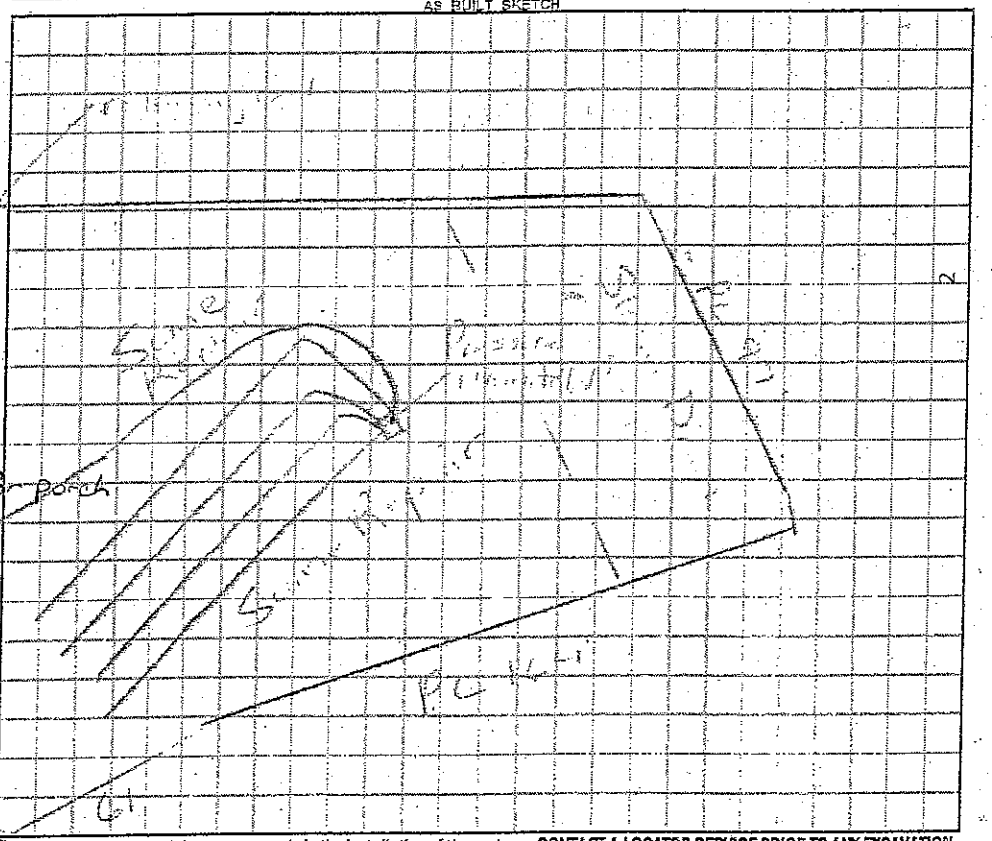

Permit can be suspended or revoked if any false information is supplied toward securing the permit / any unauthorized changes are made to the site / any unauthorized changes are made in the installation of the system. CONTACT A LOCATOR SERVICE PRIOR TO ANY EXCAVATION

☐ IMPROVEMENT PERMIT *with plat* valid without expiration. ☐ IMPROVEMENT PERMIT *with site plan* valid for 60 mos. ☐ [illegible] 60 mo.

Location of the proposed Inground Swimming Pool addition does not appear to impact the existing on-site septic system.**NOTE: Must keep Pool at least 15ft from [illegible]

Owner / Applicant Signature: Date: Installed by:

IMPROVEMENT PERMIT by: Date: OPERATION PERMI

AUTHORIZATION TO CONSTRUCT by: Date: Existing System In

REHS

IREDELL COUNTY HEALTH DEPARTMENT

Statesville Office (704) 878-5305 Mooresville Office (704) 660-3625 PERMIT # 177810

IMPROVEMENT PERMIT / AUTHORIZATION TO CONSTRUCT / OPERATION PERMIT / EXISTING SYSTEM

PIN # 4625891524

APPLICANT: Mark & Mary Rebasz APPLICANT ADDRESS: 112 Mill Lake Mooresville NC 28117

SITE ADDRESS: 112 Mill Lake Trail PHONE: [illegible] ALT. PHONE: [illegible]

SITE DIRECTIONS: Brawley School Rd to TR Mooresville to LEFT Mill Lake On Rt.


SUBDIVISION: The Point SECTION: 4 LOT # 355 LOT AREA: DESIGN FLOW: 450 L.T.A.R.: 3

Septic Tank	1500 (gal)	STB	Date	☐ New System	☐ Repair	☐ Expansion	System Type: I II III IV V VI	☒ Residence	No. Bedrooms	4	Water Supply
Pump Tank	1000 (gal)	PT	Date	System Description:				☐ Business	No. Persons		☐ Private
Pump Make		Model	Serial #	Repair System Description:				☐ Other	No. Employees		☐ Public
# Nitrification Fields	1	# Lines	4	Linear Ft: 400	Maintenance Agreement Required:	☐ YES	☒ NO	☐ Slab	☒ Crawl Space		☒ Community
Trench Width	36	Max. Trench Bottom Depth	36	Gravel Depth	N/A	☐ GRAVITY	☐ PRESSURE	☐ Basement w/plumbing		☐ Basement w/o plumbing	


Comments / Conditions:

*Must keep pool at least 15ft from Septic System

INITIAL SITE SKETCH

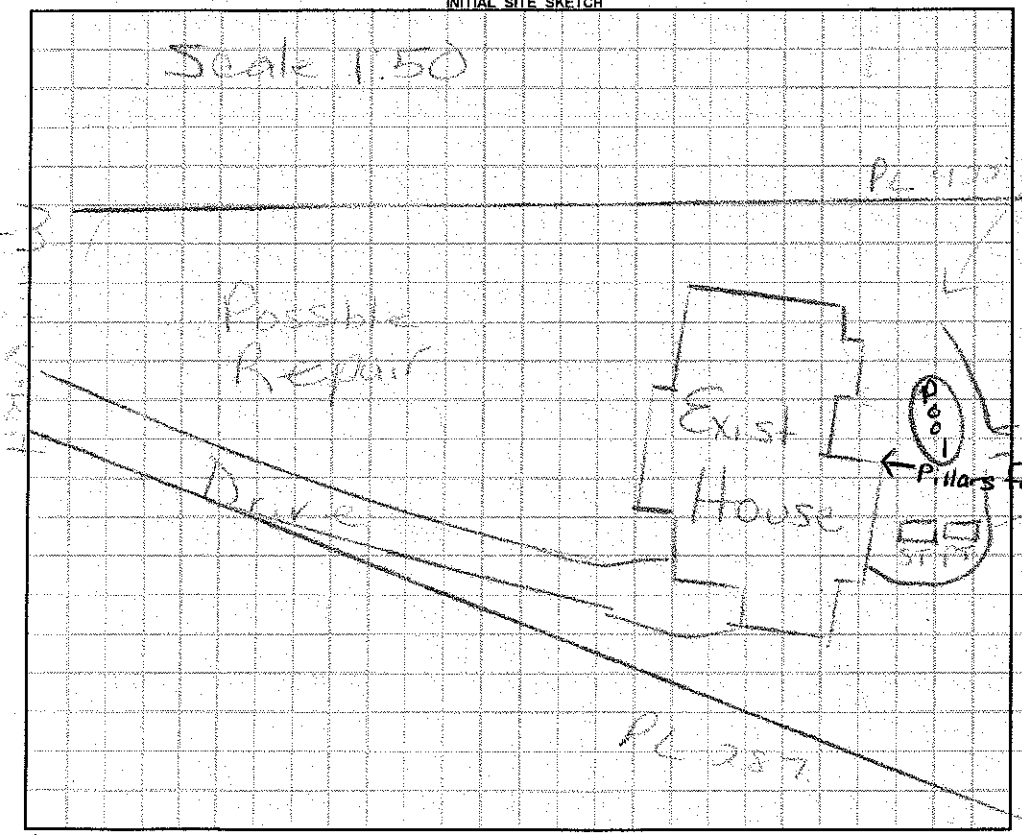

AS BUILT SKETCH

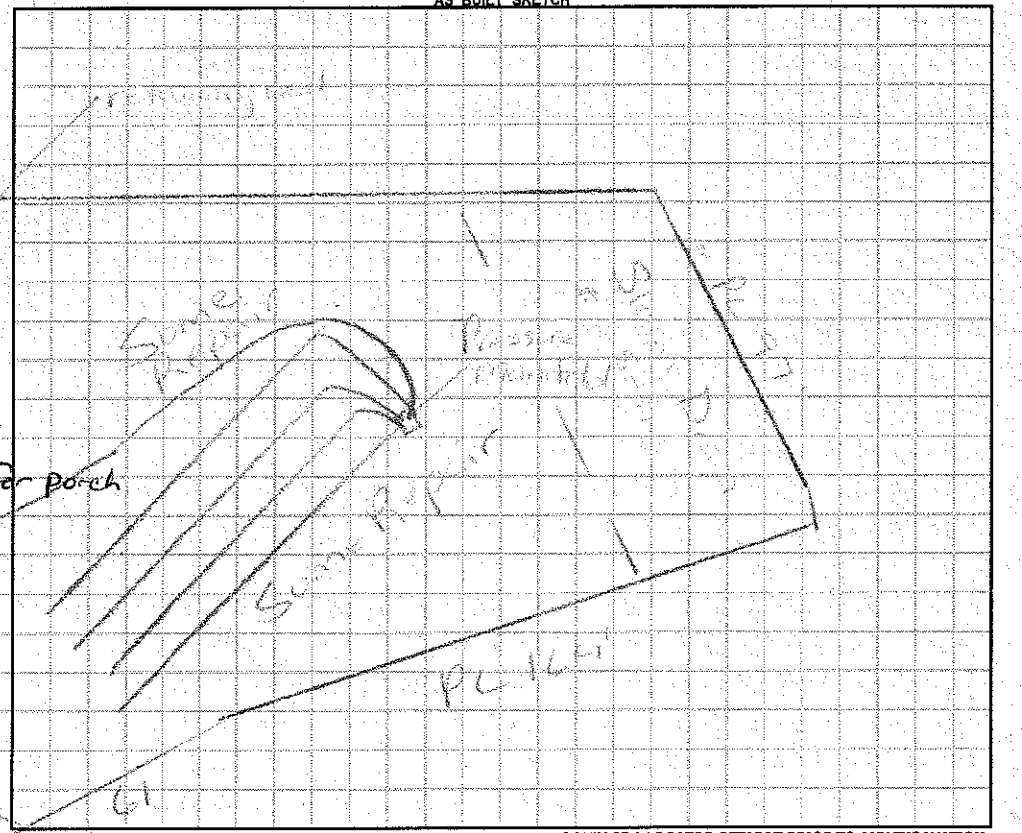

Permit can be suspended or revoked if any false information is supplied toward securing the permit / any unauthorized changes are made to the site / any unauthorized changes are made in the installation of the system. **CONTACT A LOCATOR SERVICE PRIOR TO ANY EXCAVATION**

☐ **IMPROVEMENT PERMIT** ***with plat*** *valid without expiration.* ☐ **IMPROVEMENT PERMIT** ***with site plan*** *valid for 60 mos.* ☐ [illegible] *60 mo.*

Owner / Applicant Signature: Date: Installed by:

IMPROVEMENT PERMIT by: Date: OPERATION PERMI

AUTHORIZATION TO CONSTRUCT by: Date: Existing System In

Health Dept. Copy - WHITE Applicant (Final Approval) - YELLOW Applican

Location of the proposed Inground Swimming Pool addition does not appear to impact the existing on-site septic system.**NOTE: Must keep Pool at least 15ft from Septic

REHS

Date: 5/10/13

ICHD-Environmental Health Division