IREDELL COUNTY HEALTH DEPARTMENT

STATESVILLE 704-878-5305 MOORESVILLE 704-664-5281

IMPROVEMENT PERMIT / AUTHORIZATION TO CONSTRUCT / OPERATION PERMIT / EXISTING SYSTEM INSPECTION

PERMIT # ~~4605860~~ 20631 PIN # 4625 89 2451 DATE April 4, 2011

OWNER or APPLICANT William Allen/Steve Waters PHONE: Business 704-746-6497 Home: 704 746 4531

OWNER or APPLICANT ADDRESS 111 B Raceway Dr. Mooresville 28117

LOCATION / DIRECTIONS Brawley School Rd. TR Marston Mill TR Maddeket on Right * 108 MADDAKET

SUBDIVISION The Point BLOCK / SECTION 4 LOT # 384 LOT AREA .95 Ac DESIGN FLOW 480 gpd L.T.A.R. .3gpd/ft²:25

Repair

Septic Tank ~~1000 min.~~ 1500 Gallons: STB 444 Date 6/5/15

Pump Tank ____ Gallons: P T ____ Date ____

Pump Make ____ Model ____ Serial # ____

Nitrification Field No Fields 1 No Lines 5 Linear Feet 400

Trench Width 36" Max. Trench Bottom Depth 36" Gravel Depth NA ☒ GRAVITY ☐ PRESSURE

☒ New System ☐ Repair ☐ Expansion System Type I (II) III IV V VI

System Description: 25% Reduction Gravity

Repair System Description: LP PPBPS 30" Max. Trench Bottom

Maintenance Agreement Required ☐ YES ☒ NO

☒ Residence No. Bedrooms 4 ☐ Business No. Persons ____ ☐ Other No. Employees ____

☐ Slab ☒ Crawl Space ☐ Basement w/plumbing ☐ Basement w/o plumbing

Water Supply: ☐ Private ☐ Public ☒ Community

Comments / Conditions

System must be installed as located on site plan


Comments / Conditions

8/8/14 Reviewed Floor plans, in Compliance with Septic plan. House Slightly deeper but Shouldn't impact Septic

INITIAL SITE SKETCH

See Plan from Michael Athanas & Associates Approved by ICHD

AS BUILT SKETCH

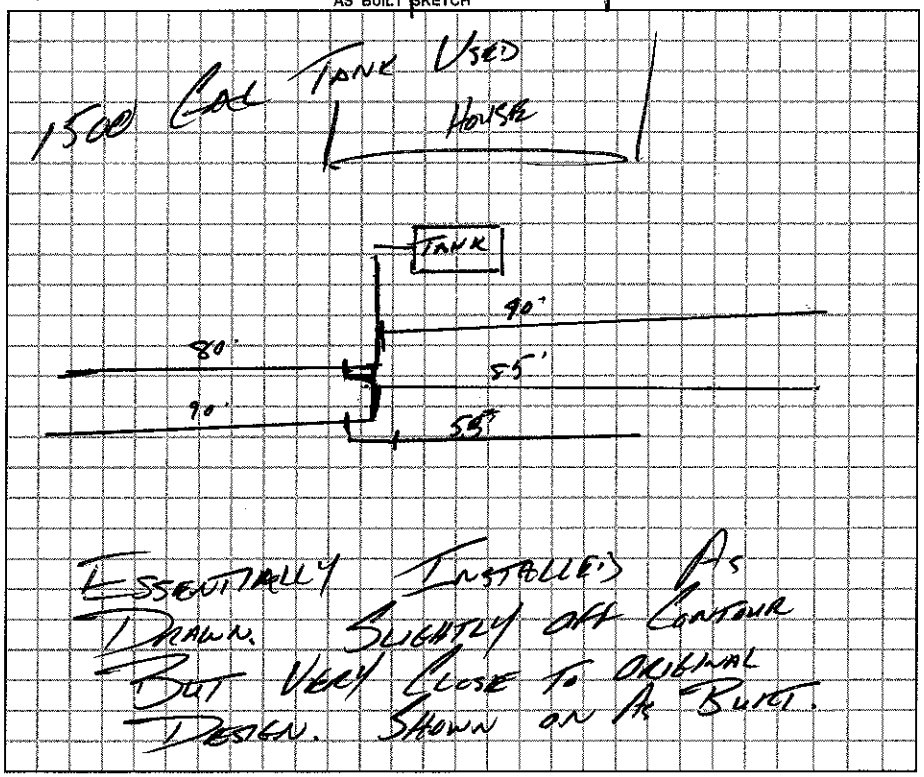

Essentially Installed As Drawn. Slightly off Contour But Very Close to Original Design. Shown on As Built.

Permit can be suspended or revoked if any false information is supplied toward securing the permit / any unauthorized changes are made to the site / any unauthorized changes are made in the installation of the system.

☐ *IMPROVEMENT PERMIT w / plat valid without expiration.* ☑ *IMPROVEMENT PERMIT w / site plan valid for 60 mos.* ☑ *AUTHORIZATION TO CONSTRUCT valid for period equal to IMPROVEMENT PERMIT-not to exceed 60 mo.*

Owner / Applicant Signature: [signature] Date 4/5/11

Improvement Permit by: [signature] REHS Date 4-4-11

Authorization to Construct by: [signature] RS Date 8/8/14

Installed by: R+H


Operation Permit by: [signature] Date: APPROVED JUL 17 2015

Existing System Inspected by: ____ Date: ____

YOU SHOULD CONTACT A LOCATOR SERVICE PRIOR TO ANY EXCAVATION.

WHITE COPY Environmental Health YELLOW COPY (Final) Owner / Applicant PINK COPY (Initial) Owner / Applicant

Lot Address: 108 Maddaket Loop

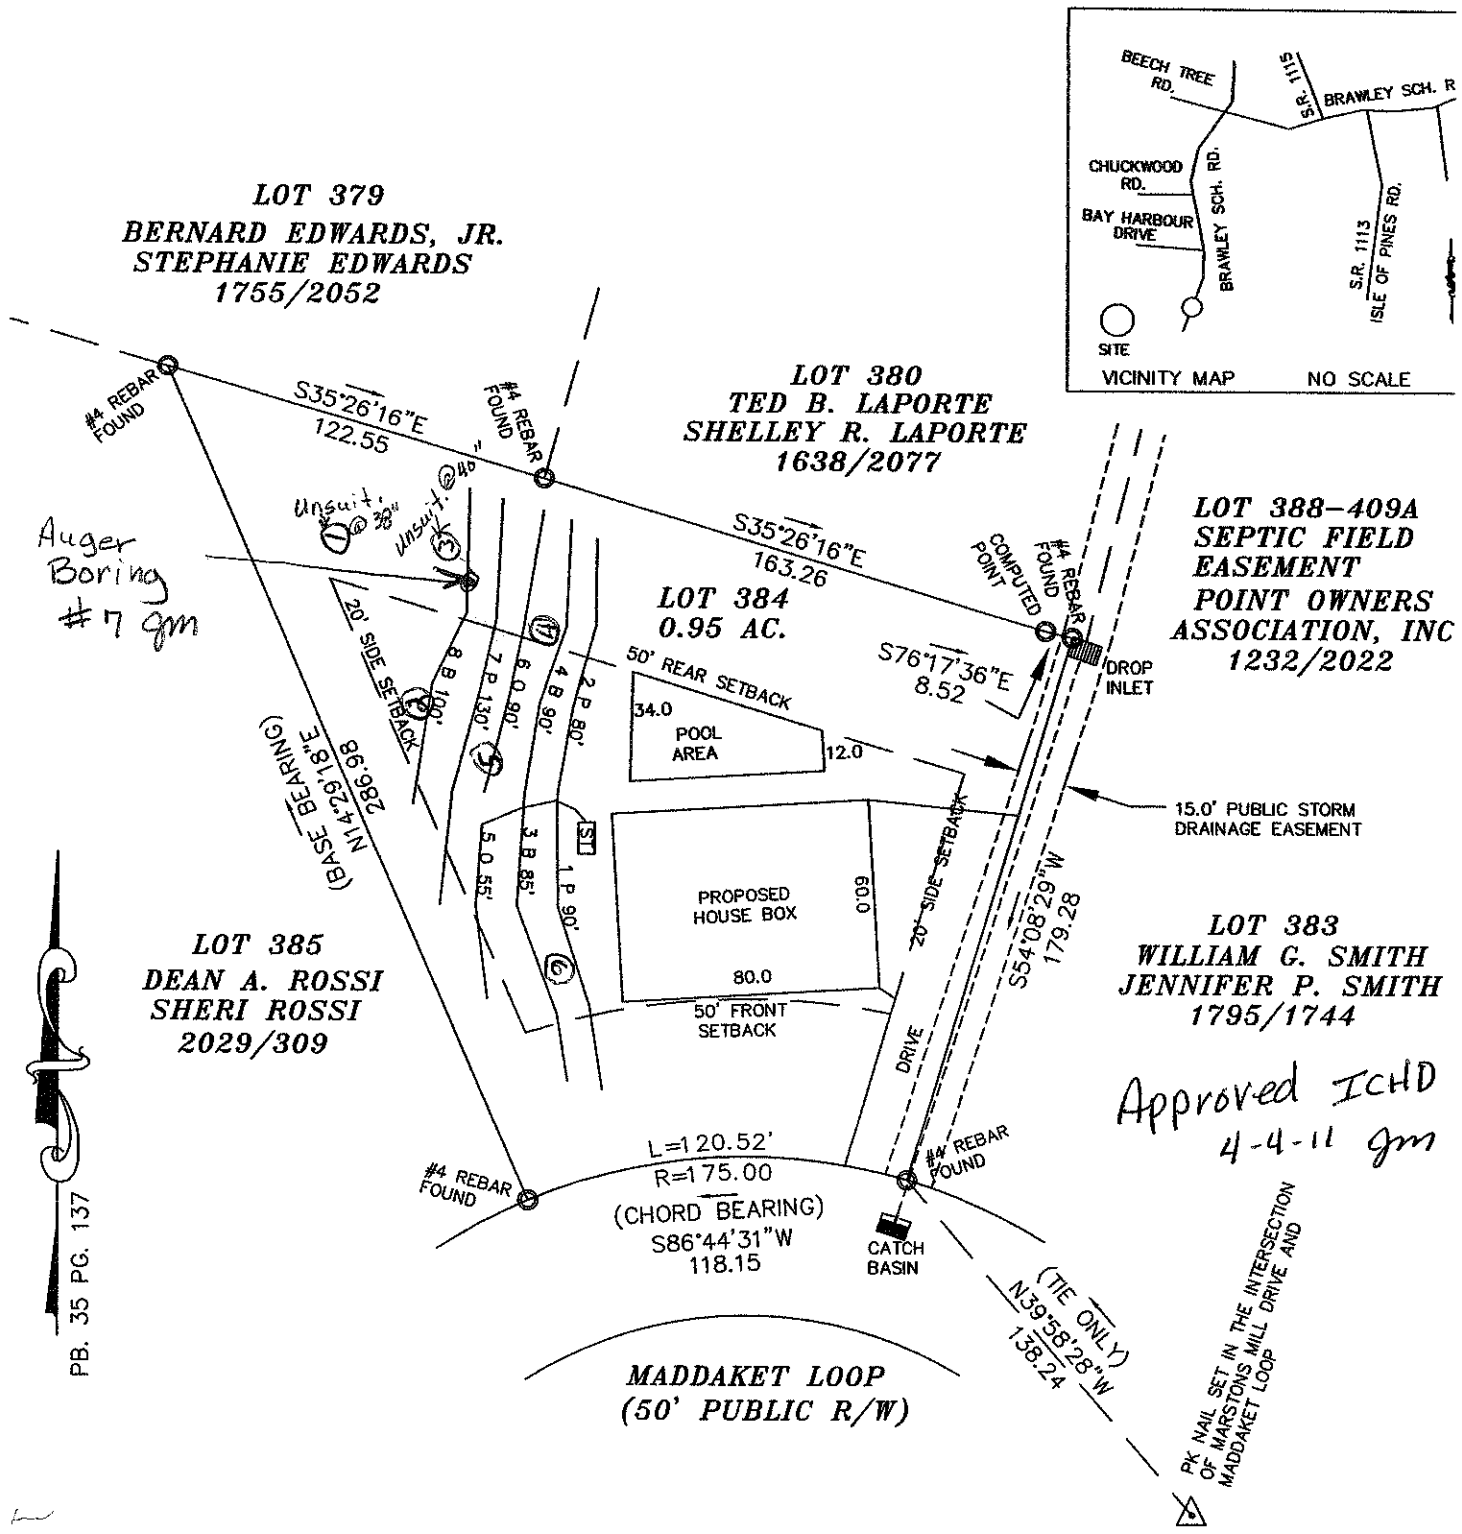

Approved ICHD
4-4-11 gm

NOTES
1) THIS PROPERTY MAY BE SUBJECT TO ANY EASEMENTS AND/OR RIGHTS OF WAY OF RECORD.
2) ACREAGE COMPUTED BY THE COORDINATE METHOD.
3) UNDERGROUND POWER
4) NO GRID MONUMENT FOUND WITHIN 2000 FEET.

0' 30' 60' 100'
SCALE IN FEET

BOUNDARY SURVEY

OF
108 MADDAKET LOOP
LOT 384 THE POINT, PH. 4, MAP 1
DAVIDSON TWSP., IREDELL CO., N.C.

SCALE 1" = 60'

ACQUIRED BY:

LEGEND
□ = DUKE POWER TRANS.
E.I.P. = EXISTING IRON FOUND
I.P.S. = #4 REBAR SET
R/W = RIGHT-OF-WAY
Ⓦ = WELL

FIELD BOOK: 663
FILE: POINT LOT 384
DC FILE:
TAX MAP NO.: 4676802451