...NTY HEALTH DEPARTMENT

STATESVILLE 704-878-5305 50.00 Paid MOORESVILLE 704-664-5...

...MENT PERMIT / AUTHORIZATION TO CONSTRUCT / OPERATION PERMIT / EXISTING SYSTEM INS... TI...

81829 PIN# 4625941684 PT 4625-89-2745 DATE 3-28-20...

...NER OR CONTRACTOR Simonini Builders Inc PHONE: Business (704) 358-9940 Home Brian or Rick 201-8976/309-...

ADDRESS 817 E. Morehead St. Ste. 100 Charlotte, NC 28203

LOCATION On Brawley School Rd. on right just past entrance to The Harbour

SUBDIVISION The Point BLOCK / SECTION 4 LOT 378 LOT AREA .799 Acres SITE CLASS. PS DESIGN FLOW 480 gpd L.T.A.R. .3

Septic Tank: 1000+ Gallons; STB 338 Date 6-16-02

Pump Tank: 1000 Gallons; PT ____ Date ____

Pump Make: ____ Model ____ Serial No. ____

Nitrification Field: No Fields 1 Square Feet 1200' Linear Feet 400'

No Lines 4@100' Trench Width 36" Max Trench Bottom Depth 36" Gravel Depth N/A

☒ New System ☐ Repair System Type: I, II, III, IV, V, VI

System Description: Gravity - 25% Reduction

Repair System Description: Pump Panel Block

Maintenance Agreement Required: ☐ Yes ☒ No

☒ House/Mod. Home ☐ Mobile Home ☐ Business ☐ Other

No. Bedrooms 4 No. Bathrooms 3.5 No. Employees ____

☐ Slab ☒ Crawl Space ☐ Basement w/plumbing ☐ Basement wo/plumbing


Water Supply: ☐ Individual ☒ Public ☒ Community

Comments:/Conditions: Keep Septic System at least 10' from PT & 10' From house. Do not extend Septic System into Easement areas.

Comments:/Conditions: Checked tanks & lines 7/9/0...

Need to check D-box

Scale 1:40 INITIAL SITE SKETCH

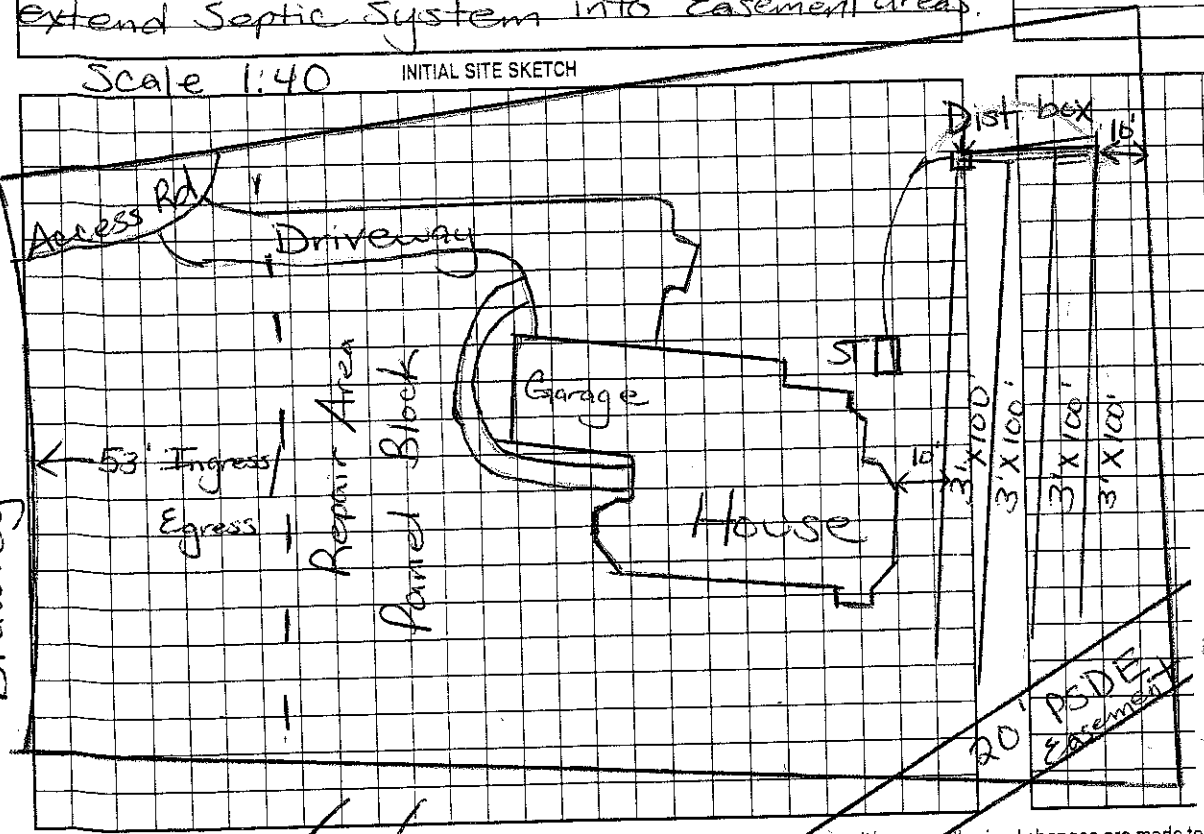

AS BUILT SKETCH

Installed as Drawn

Used EZ Flow

Buildings ok, meet setbacks to Septic, however lowest line of Drainfield is surfacing

5/24/11 Site Visit: Sewage not surfacing but Drainfield wet. Spoke w/ Owner Said pool chag...

Permit can be suspended or revoked if any false information is supplied toward securing the permit/any unauthorized changes are made to the site/any unauthorized changes are made in the installation of the system. Improvement Permit with plat valid without expiration; Improvement Permit with site plan valid for sixty months. Authorization to Construct is valid for a period equal to that of Improvement Permit – not to exceed sixty months.

Signed: ____ date 4/2/02 Installed by: R&H Inc

...ement Permit by: Maria H. Nolan RS date 3/28/2002 Operation Permit by: ____ date ____

...onstruct by: Maria H. Nolan RS date 3/28/2002 Existing System Inspection by: Maria H. Nolan RS date 7/22/2002

HEALTH DEPT. COPY: WHITE OWNER COPY (FINAL): YELLOW OWNER COPY (INITIAL): PINK