IREDELL COUNTY HEALTH DEPARTMENT

STATESVILLE 704-878-5305 MOORESVILLE 704-664-5281

IMPROVEMENT PERMIT / AUTHORIZATION TO CONSTRUCT / OPERATION PERMIT / EXISTING SYSTEM INSPECTION

PERMIT# 1605943 PIN # 4625892745 DATE 6-3-2011

OWNER or APPLICANT Ashley & Jeff Chilton PHONE: ~~Home~~ 704 9073431 Home: 704 372 4344

OWNER or APPLICANT ADDRESS 11654 Brawley School Rd

LOCATION/DIRECTIONS Brawley School Rd on right just past entrance for the Harbour

SUBDIVISION The Point BLOCK / SECTION LOT # 378 LOT AREA .799Ac DESIGN FLOW 480gpd L.T.A.R. .3

Septic Tank 1500 Gallons: STB 338 Date 6-16-02

Pump Tank Gallons: P T Date

Pump Make Model Serial #

Nitrification Field No Fields 1 No Lines 4 Linear Feet 400'

Trench Width 36" Max. Trench Bottom Depth 36" Gravel Depth N/A

☐ New System ☐ Repair ☐ Expansion System Type I II III IV V VI

System Description: Exist. Gravity - 25% Reduction ~~Exist~~ ~~Pump~~

Repair System Description: Pump - Panel Blk

Maintenance Agreement Required ☐ YES ☒ NO

☐ GRAVITY ☐ PRESSURE


☒ Residence No. Bedrooms 4 ☐ Business No. Persons ☐ Other No. Employees ☐ Slab ☐ Crawl Space ☐ Basement w/plumbing ☐ Basement w/o plumbing

Water Supply: ☐ Private ☒ Public ☒ Community


Comments / Conditions: Must keep proposed pergola at least 5ft from Septic System; it should not impact Septic System. Drainfield appears to be functioning okay now.

Comments / Conditions: (Keep tabs on water use to prevent premature Drainfield failure) Limit irrigation use over Drainfield.

INITIAL SITE SKETCH

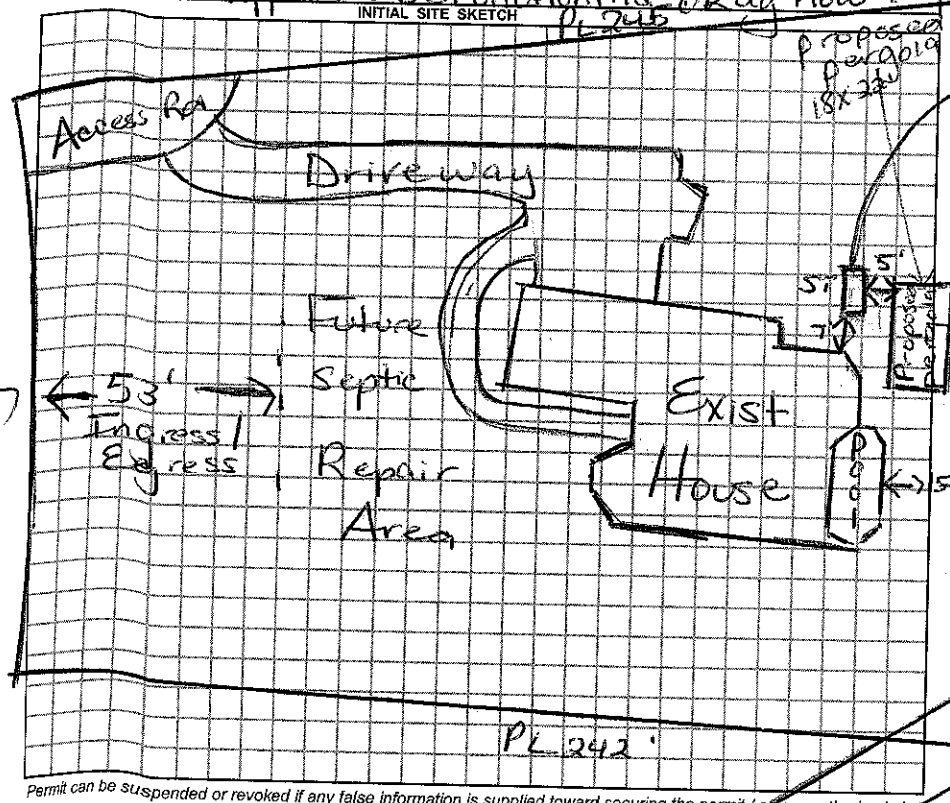

AS BUILT SKETCH

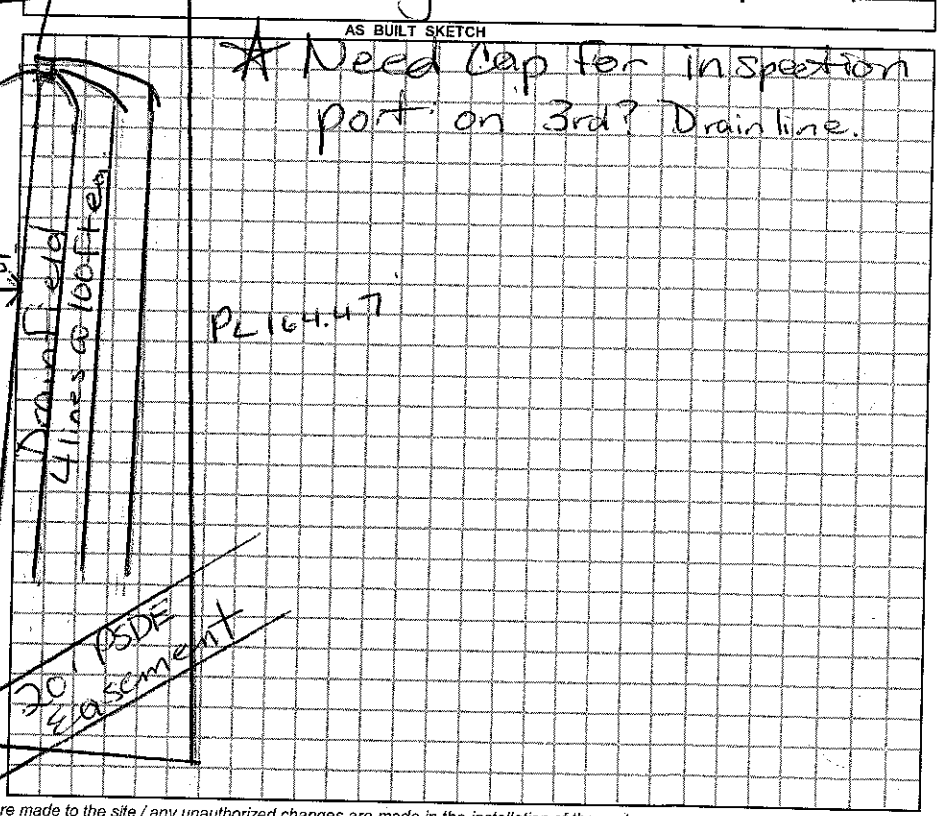

Permit can be suspended or revoked if any false information is supplied toward securing the permit / any unauthorized changes are made to the site / any unauthorized changes are made in the installation of the system.

☐ IMPROVEMENT PERMIT w / plat valid without expiration. ☐ IMPROVEMENT PERMIT w / site plan valid for 60 mos. ☐ AUTHORIZATION TO CONSTRUCT valid for period equal to IMPROVEMENT PERMIT-not to exceed 60 mo.

Owner / Applicant Signature: X Ashley A Chilton Date 6/3/11

Improvement Permit by: Date

Authorization to Construct by: Date

YOU SHOULD CONTACT A LOCATOR SERVICE PRIOR TO ANY EXCAVATION.

Installed by: R & H Inc 7/22/2002

Operation Permit by: Date: 6/3/11

Existing System Inspected by: Date: RFHs

WHITE COPY Environmental Health / YELLOW COPY (Final) Owner / Applicant PINK COPY (Initial) Owner / Applicant