IREDELL COUNTY HEALTH DEPARTMENT

STAT. [illegible]305 200.00 Paid MOORESVILLE 704-664-5281

IMPROVEMENT PERMIT / AUTHORIZATION TO CONSTRUCT / [illegible]ATION PERMIT / EXISTING SYSTEM INSPECTION

PERMIT# 081830 PIN# 4625 89 3622 4625.80 2622 DATE 9/9/05

OWNER OR CONTRACTOR Jay A. Young PHONE: Business 704 447 7630 Home 704 363-6759

ADDRESS 15669 Birkdale Commons

LOCATION BSR on RT past Bay Harbor PKwy

SUBDIVISION Point BLOCK / SECTION 4 LOT 379 LOT AREA 40,672 SITE CLASS. FS DESIGN FLOW 480 L.T.A.R. 0.3

Septic Tank: ~~1000~~ 1500 Gallons; STB 338 Date 11/7/06
Pump Tank: _____ Gallons; PT _____ Date _____
Pump Make: _____ Model _____ Serial No. _____
Nitrification Field: No Fields 1 Square Feet 1200 Linear Feet 480
No Lines 30/33 Trench Width 36" Max Trench Bottom Depth 36" Gravel Depth —

☒ New System ☐ Repair System Type: I (II) III, IV, V, VI
System Description: Gravity 25% Reduct
Repair System Description: Panel Block
Maintenance Agreement Required: ☐ Yes ☒ No

☒ House/Mod. Home No. Bedrooms 4
☐ Mobile Home No. Bathrooms ____
☐ Business No. Employees ____
☐ Other ____


☐ Slab ☒ Crawl Space ☐ Basement w/plumbing ☐ Basement wo/plumbing

Water Supply:
☐ Individual
☐ Public
☒ Community


Comments:/Conditions:

Comments:/Conditions:

INITIAL SITE SKETCH

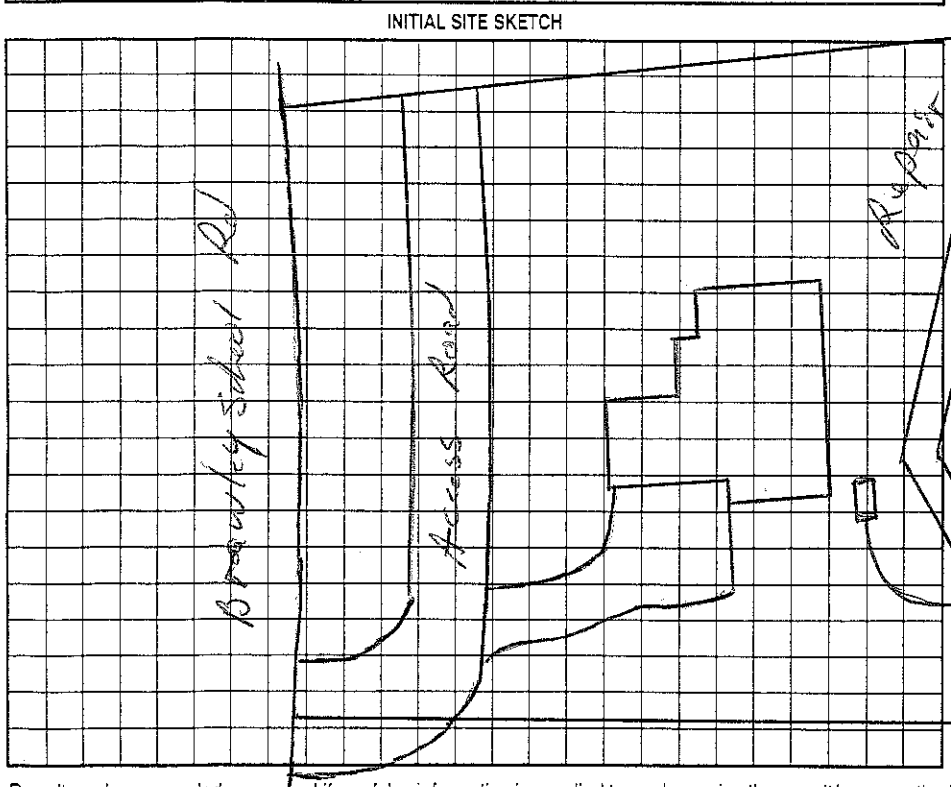

AS BUILT SKETCH

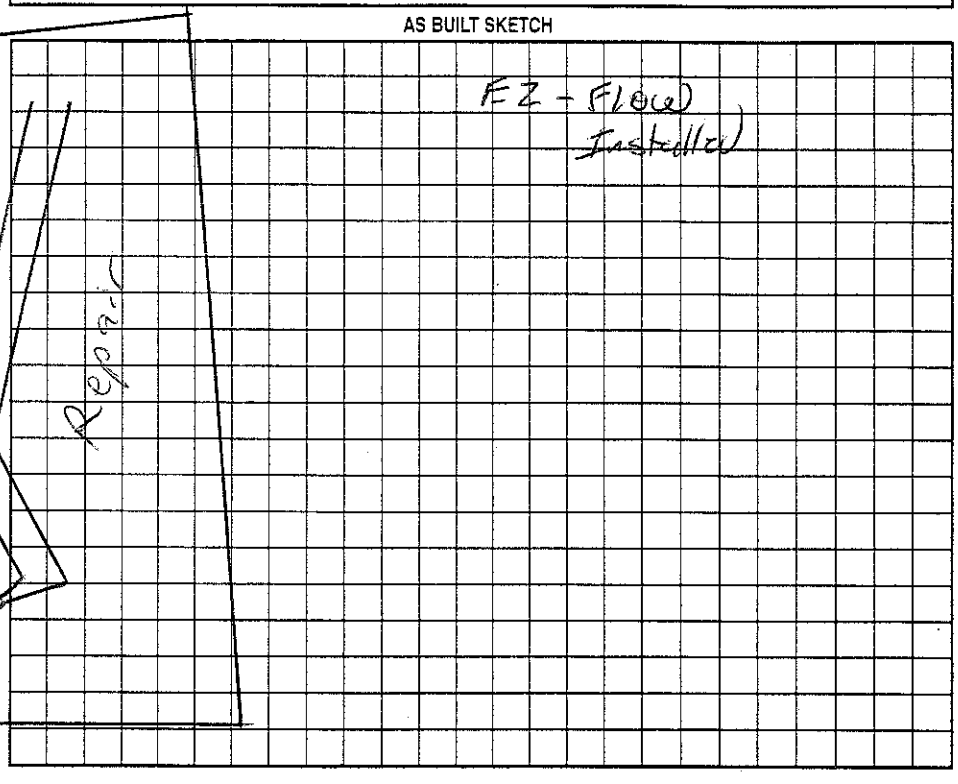

Permit can be suspended or revoked if any false information is supplied toward securing the permit/any unauthorized changes are made to the site/any unauthorized changes are made in the installation of the system. Improvement Permit with plat valid without expiration. Improvement Permit with site plan valid for sixty months. Authorization to Construct is valid for a period equal to that of Improvement Permit – not to exceed sixty months.

Signed: Margaret Young date 9/13/05

Improvement Permit by: RS date 9/9/05

Authorization to Construct by: RS date 9/9/05

Installed by: Orbison

Operation Permit by: RS date 3/23/06

Existing System Inspection by: _____ date _____

HEALTH DEPT. COPY: WHITE OWNER COPY (FINAL): YELLOW OWNER COPY (INITIAL): PINK