IREDELL COUNTY HEALTH DEPARTMENT

STATESVILLE 704-878-5305 MOORESVILLE 704-664-5281

IMPROVEMENT PERMIT / AUTHORIZATION TO CONSTRUCT / OPERATION PERMIT / EXISTING SYSTEM INSPECTION

1179607

3:30

PERMIT# 81832 PIN# 4625941684 PT 4625894428

OWNER OR CONTRACTOR CRESCENT RESOURCES / Tom Stevenson PHONE: Business 704 660-6638 Home DATE 12/10/99

ADDRESS PO BOX 1003, CHARLOTTE NC 28202

LOCATION BLAWLEY SCHOOL - ON RT PAST BAY HARBOR Driveway BY Marion's Mill

SUBDIVISION POINT BLOCK / SECTION 4 LOT 380 LOT AREA 40,677 SITE CLASS PS DESIGN FLOW 480 GPD L.T.A.R. ~.3 GPD/FT

Septic Tank: 1000 + Gallons; STB 338 Date 3-13-04

Pump Tank: 1000 + Gallons; PT 27 Date 3-15-04

Pump Make: Goulds Model WE0312HC Serial No.

Nitrification Field: No Fields 1 Square Feet 1260 Linear Feet 420

No Lines 6@70' Trench Width 36" Max Trench Bottom Depth 36" Gravel Depth N/A

☑ New System ☐ Repair System Type: I, II, (III) IV, V, VI

System Description: PUMP 25% REDUCTION

Repair System Description: PUMP PANEL

Maintenance Agreement Required: ☐ Yes ☑ No

☑ House/Mod. Home No. Bedrooms 4

☐ Mobile Home No. Bathrooms 4

☐ Business No. Employees

☐ Other


☐ Slab ☑ Crawl Space ☐ Basement w/plumbing ☐ Basement wo/plumbing

Water Supply: ☐ Individual ☐ Public ☑ Community


Comments:/Conditions: REMOVE ALL TERRACES AND BERMS Reviewed Building plans; essentially in Compliance with original permit. MS

Comments:/Conditions: Checked tanks & lines 5/13/04

INITIAL SITE SKETCH

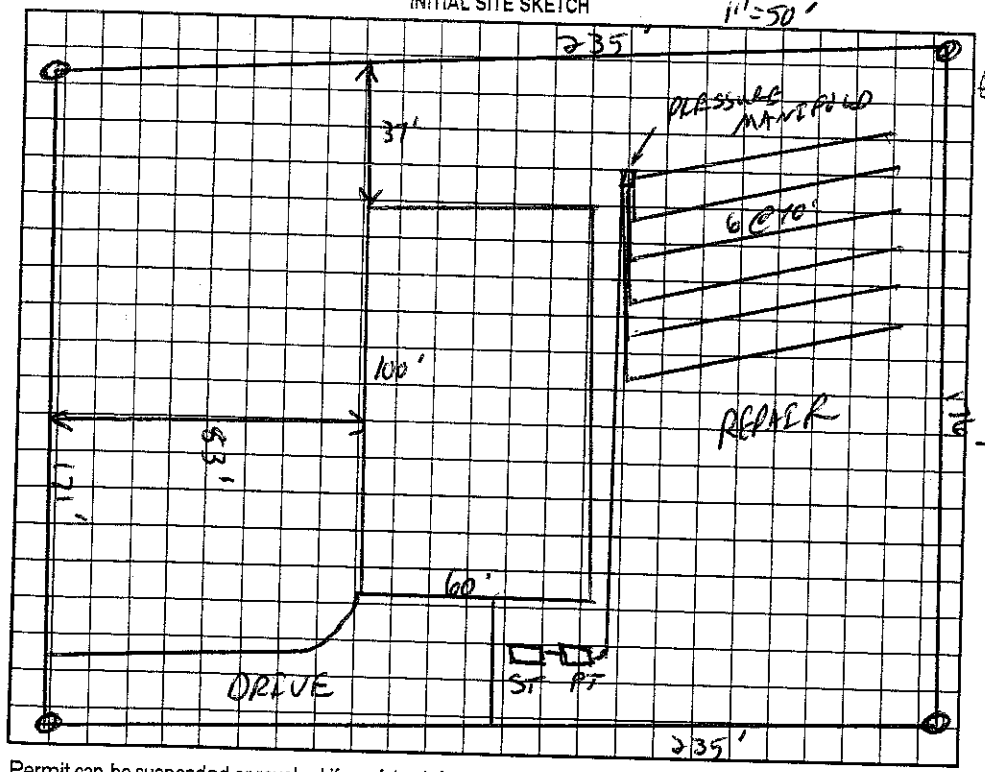

AS BUILT SKETCH

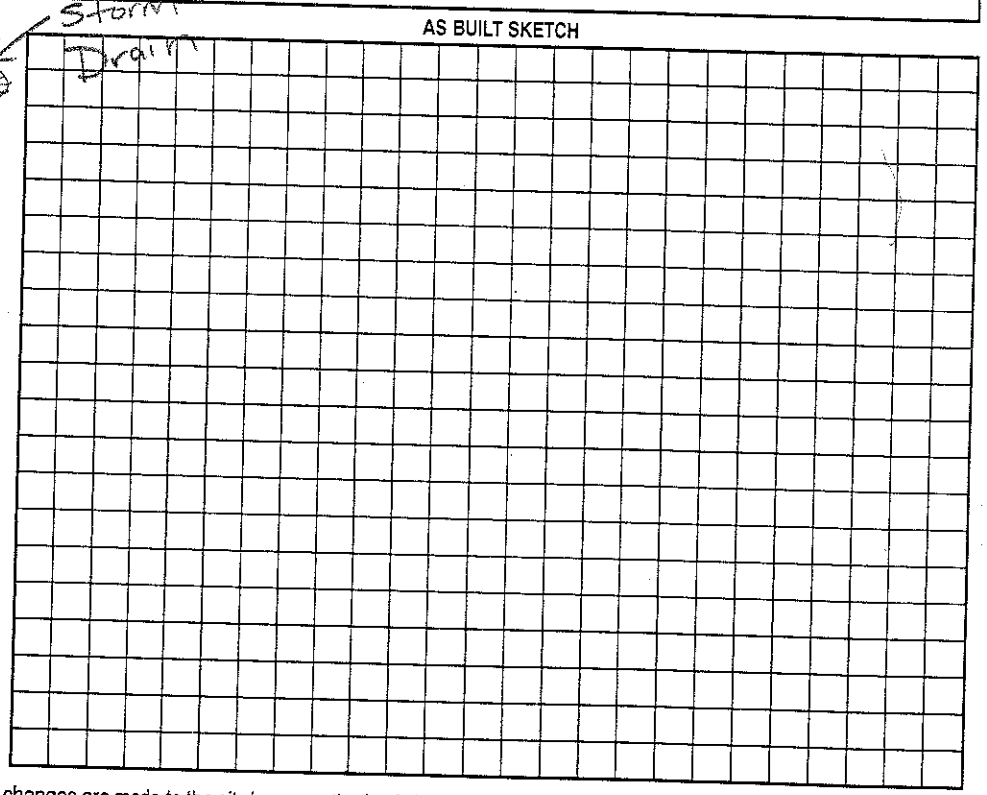

BLAWLEY SCHOOL RD

Permit can be suspended or revoked if any false information is supplied toward securing the permit/any unauthorized changes are made to the site/any unauthorized changes are made in the installation of the system. Improvement Permit with plat valid without expiration. Improvement Permit with site plan valid for sixty months. Authorization to Construct is valid for a period equal to that of Improvement Permit – not to exceed sixty months.

Signed: P.P.G. K date 1-21-00

Improvement Permit by: RS date 12/10/99

Authorization to Construct by: Maria H. Tolson RS date 12/7/03

Installed by: R & H RS

Operation Permit by: Maria H. Tolson RS date 5/13/04

Existing System Inspection by: Maria H. Tolson RS date 9/13/04

HEALTH DEPT. COPY: WHITE OWNER COPY (FINAL): YELLOW OWNER COPY (INITIAL): PINK