IREDELL COUNTY HEALTH DEPARTMENT

STATESVILLE 704-878-5305 MOORESVILLE 704-664-5281

IMPROVEMENT PERMIT / AUTHORIZATION TO CONSTRUCT / OPERATION PERMIT / EXISTING SYSTEM INSPECT

1168820

PERMIT# 8761-3/1168820 PIN# 4625842807 (pt.) Diewst Custom Homes 4625-89-8528 DATE April 22, '97

OWNER OR CONTRACTOR Crescent Resources c/o Jeff Preston Nickerson PHONE: Business 660-1185 Home

ADDRESS 2214 Brawley Sch Rd. Mooresville

LOCATION Brawley Sch Rd on just before jct w/ Brawley Harbor Place

SUBDIVISION The Point BLOCK / SECTION 1L LOT 269 LOT AREA 50,544 +SFE SITE CLASS 15 DESIGN FLOW 440 gpd L.T.A.R. .32-.25

Septic Tank: 1000+ Gallons; STB 312 Date 5-28-04

Pump Tank: 1000 Gallons; PT 27 Date 5-16-04

Pump Make: Myers Model ME50 Serial No.

Nitrification Field: No Fields 1 Square Feet 1080 Linear Feet 360

No Lines 6@60' Trench Width 36" Max Trench Bottom Depth 36" Gravel Depth NA

☑ New System ☐ Repair System Type: I, II, III, IV, V, VI

System Description: LP Panel Black

Repair System Description: PIN/LP INNOVATIVE ON 269A

Maintenance Agreement Required: ☑ Yes ☐ No SFE

☑ House/Mod. Home ☐ Mobile Home ☐ Business ☐ Other

No. Bedrooms 4/4 No. Bathrooms 4/4 No. Employees


☑ Slab ☐ Crawl Space ☑ Basement w/plumbing ☐ Basement wo/plumbing

Water Supply: ☐ Individual ☑ Public ☑ Community


Comments:/Conditions:

Comments:/Conditions: Installed as Drawn
Checked tanks & lines 7/7/04
Pressure, elect & alarm 8/6/04

INITIAL SITE SKETCH 1"=50'

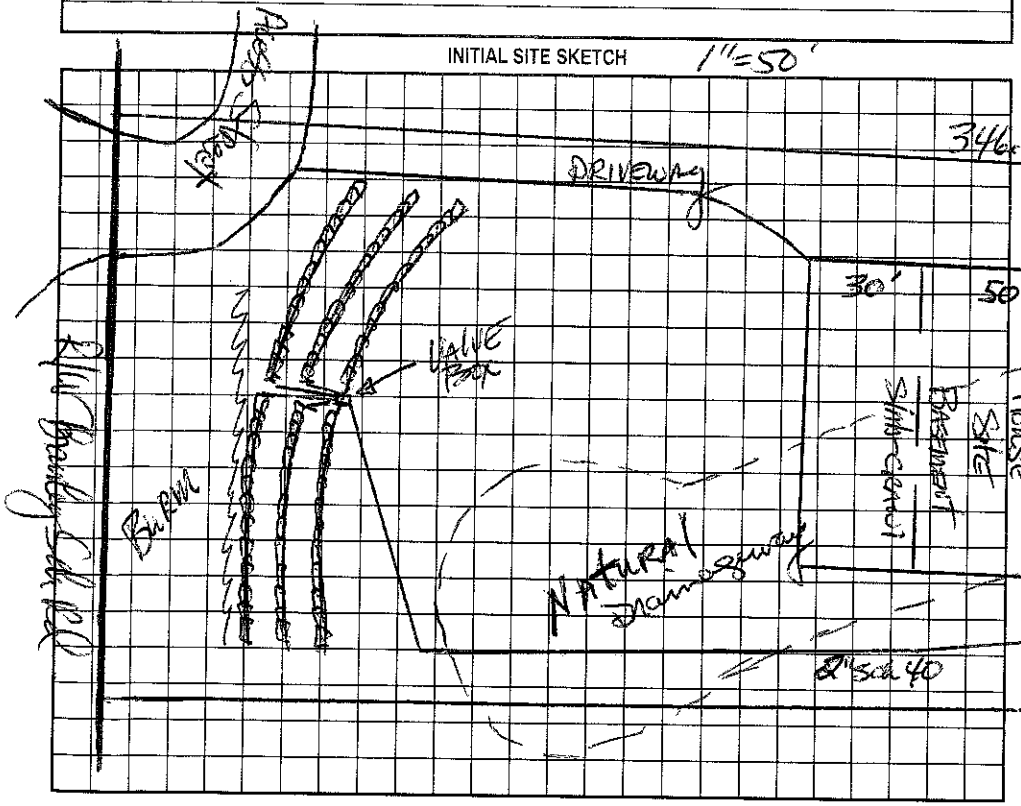

AS BUILT SKETCH

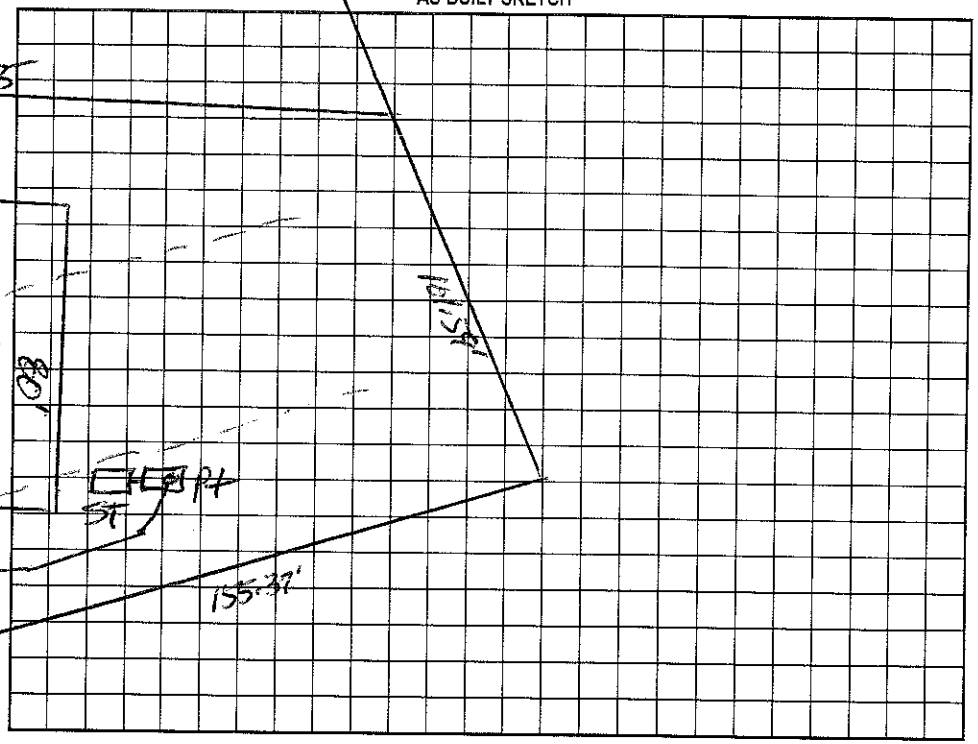

Permit can be suspended or revoked if any false information is supplied toward securing the permit/any unauthorized changes are made to the site/any unauthorized changes are made in the installation of the system. Improvement Permit with plat valid without expiration. Improvement Permit with site plan valid for sixty months. Authorization to Construct is valid for a period equal to that of Improvement Permit – not to exceed sixty months.

Signed: [signature] date 4-22-97

Improvement Permit by: [signature] RS date 4-22-97

Authorization to Construct by: [signature] RS date 10-23-03

Installed by: R & H RS

Operation Permit by: [signature] date 8/6/04

Existing System Inspection by: date

HEALTH DEPT. COPY: WHITE OWNER COPY (FINAL): YELLOW OWNER COPY (INITIAL): PINK