IREDELL COUNTY HEALTH DEPARTMENT

STATESVILLE 704-878-5305 50.00 Redraw-Pard MOORESVILLE 704-664-5281

IMPROVEMENT PERMIT / AUTHORIZATION TO CONSTRUCT / OPERATION PERMIT / EXISTING SYSTEM INSPECTION

PERMIT# 089453 PIN# 4625 90 0509 DATE 5/30/00

OWNER OR CONTRACTOR Grant Detwiler PHONE: Business 896-5552 Home

ADDRESS 197 Isle of Pines Rd. Mooresville, NC. 28115

LOCATION 1100 TL Yacht Rd. TL Yacht Cove, 2nd lot on left

SUBDIVISION Yacht Cove BLOCK / SECTION LOT 22 LOT AREA .49AC SITE CLASS. PS DESIGN FLOW 360 L.T.A.R. .3

Septic Tank: 1000 Gallons; STB 794 Date 10/22/00

Pump Tank: 1000 Gallons; PT Date

Pump Make: ZOELLER Model N-98 Serial No.

Nitrification Field: No Fields 1 Square Feet 630 Linear Feet 210

No Lines 3@70'x3' Trench Width 36" Max Trench Bottom Depth 36" ~~Gravel Depth~~ SAND.

[X] New System [ ] Repair System Type: I, II, III, [IV], V, VI

System Description: LPP DIST - 16" PPBS

Repair System Description: SAME

Maintenance Agreement Required: [X] Yes [ ] No

[X] House/Mod. Home No. Bedrooms 3

[ ] Mobile Home No. Bathrooms 2.5

[ ] Business No. Employees

[ ] Other


[ ] Slab [X] Crawl Space [ ] Basement w/plumbing [ ] Basement wo/plumbing

Water Supply: [X] Individual [ ] Public [ ] Community


Comments:/Conditions:

Comments:/Conditions:

INITIAL SITE SKETCH (1"=40')

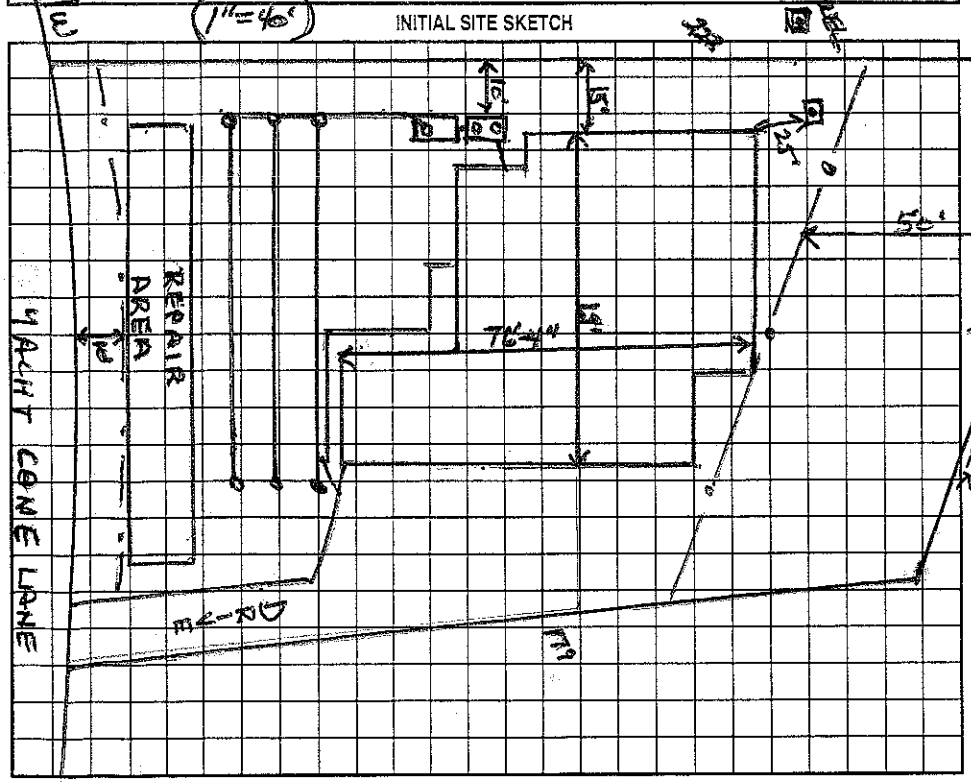

AS BUILT SKETCH

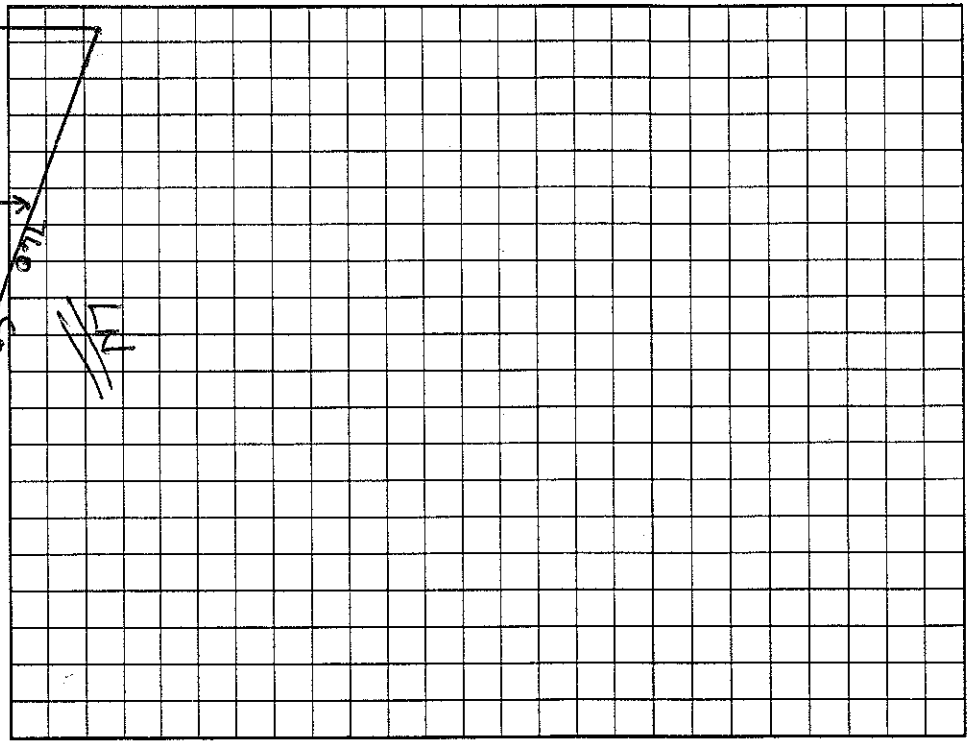

Permit can be suspended or revoked if any false information is supplied toward securing the permit/any unauthorized changes are made to the site/any unauthorized changes are made in the installation of the system. Improvement Permit with plat valid without expiration. Improvement Permit with site plan valid for sixty months. Authorization to Construct is valid for a period equal to that of Improvement Permit – not to exceed sixty months.

Signed: * Marshall Building Co. date 5/31/00

Installed by: Macneal Const.

Improvement Permit by: Wesley Sparks RS. date 5/30/00

Operation Permit by: Wesley Sparks RS. date 3/1/01

Authorization to Construct by: Wesley Sparks RS. date 5/30/00

Existing System Inspection by: date

HEALTH DEPT. COPY: WHITE OWNER COPY (FINAL): YELLOW OWNER COPY (INITIAL): PINK